

W.P.T. A.M.
5/2/85

APPROVED
5/21 85
RH P 35375

PERMIT

SEWAGE DISPOSAL SYSTEM

A 34312

MARYLAND STATE DEPARTMENT OF HEALTH*

HOWARD COUNTY
BUREAU OF ENVIRONMENTAL HEALTH
992-2330

05-374294

ELLICOTT CITY

DISTRICT 5th

INDEXED

DATE 5/2/85

Jack Fyock

IS PERMITTED TO INSTALL ALTER

ADDRESS 988-9270

SUBDIVISION Glenelg Manor II ROAD 12729 Folly Quarter LOT 7A

PROPERTY OWNER Eugene & Virginia Atkinson

ADDRESS

IF GARBAGE GRINDER IS USED INCREASE SEPTIC TANK CAPACITY BY 50% AND ABSORPTION AREA BY 22%.

GARBAGE GRINDER? YES NO

SEPTIC TANK CAPACITY 1250 GALLONS NUMBER OF BEDROOMS 4

DEEP TRENCHES - 158 sq. ft. one sidewall area per bedroom. Ditch is to be 2 feet wide, 10 feet deep, with inlet at 3 feet below original grade and filled with 7 feet of stone. Length of the ditch depends on the number of sq. ft. needed. Start the ditch and run it 80 feet from the front lot line and 100 feet from the right lot line as seen when facing the lot from Right of Way.

NOTE: No trench to exceed 100 feet in length. If more than one trench used, a distribution box is required. Trenches to be installed on level ground. Call for inspection of trench before and after gravel is installed. Provide 6" - 8" diameter cleanout and cap to grade or above on septic tank.

632' OF TRENCH = 91 FE TRENCH.

PLANS APPROVED BY Raymond Hodges/F. Skinner DATE 12/14/84

COVER NO WORK UNTIL INSPECTED AND APPROVED.

NEITHER THE HOWARD COUNTY COUNCIL NOR THE HEALTH DEPARTMENT IS RESPONSIBLE FOR THE SUCCESSFUL OPERATION OF ANY SYSTEM.

BUILDING PERMIT SIGNED AND RETURNED

NOTE: IF TRENCH IS USED CALL FOR INSPECTION BEFORE AND AFTER PLACING GRAVEL IN TRENCH.

NOTE: NO DRY WELL SHALL EXCEED 15 FOOT IN DIAMETER. NO ABSORPTION TRENCH TO EXCEED 100 FEET IN LENGTH.

NOTE: ALL PIPE FROM HOUSE TO SEPTIC TANK MUST BE CAST IRON OR SCHEDULE 40 PVC OR ABS.

PERMIT VOID AFTER THREE YEARS.

NOTE: INSTALL STAND PIPE ON SEPTIC TANK AND DRY WELL. STAND PIPES MUST BE 6 INCHES IN DIAMETER. CAST IRON, CONCRETE OR TERRA COTTA, OR PVC OR ABS ACCEPTED. IF TOP OF SEPTIC TANK IS DEEPER THAN 3 FEET MANHOLE TO GRADE REQUIRED.


BOO151056 Relocate Kitchen to garage + master BR/Bath to 1st floor.
12/22/04 BOO151588 LPTank

A 34312

*INSTALLER IS RESPONSIBLE FOR OBTAINING FINAL APPROVAL ON THIS PERMIT

*CALL 992-2330 FOR INSPECTION OF SEPTIC SYSTEMS.

EH - 2-1082

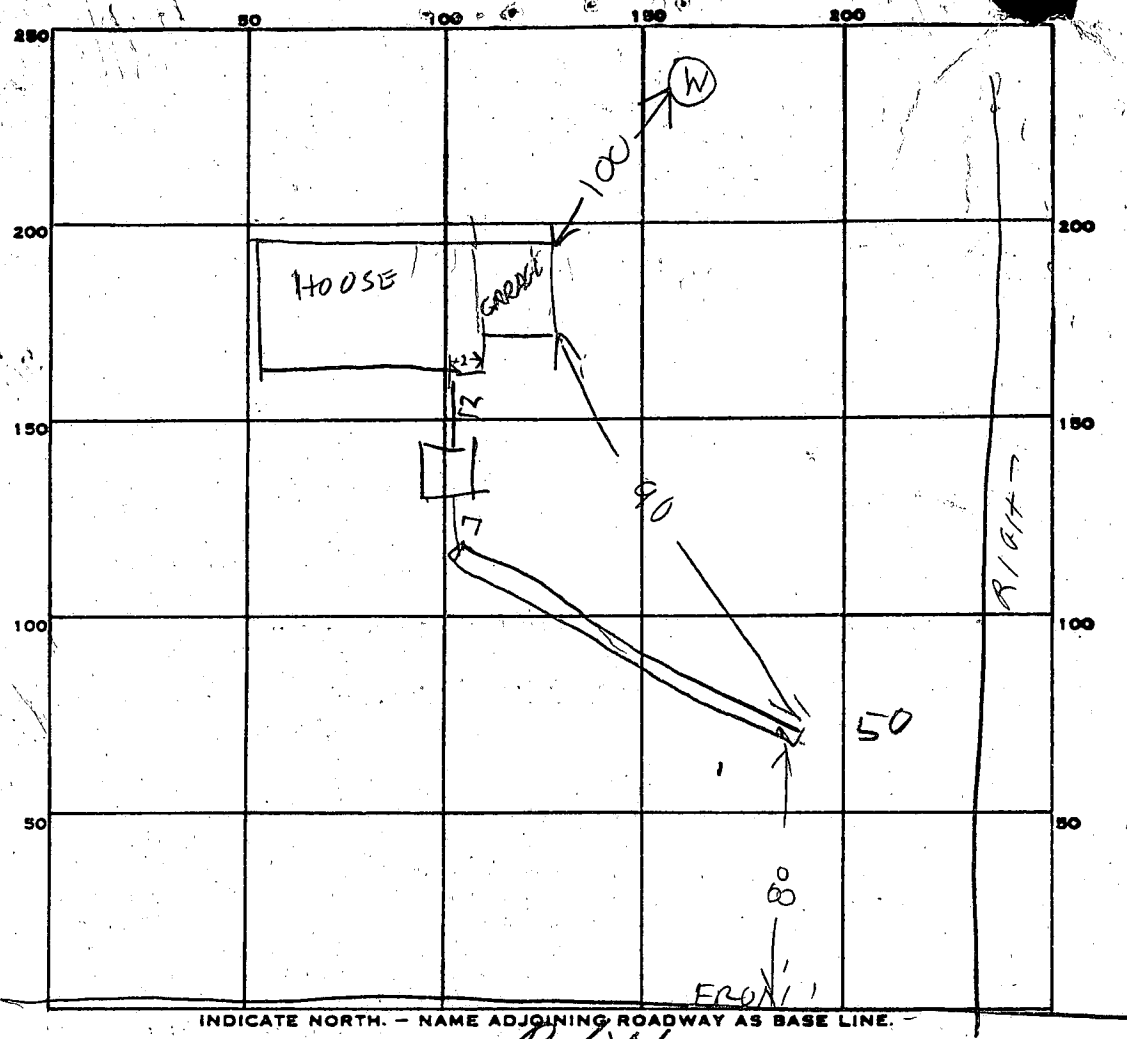

INDICATE NORTH. - NAME ADJOINING ROADWAY AS BASE LINE.

PERMIT CARD _____

SEPTIC TANK, LEVEL 1500

CLEANOUTS ST OIK

DISTRIBUTION BOX, LEVEL _____

TILE FIELD, DEPTH 10 FT. TRENCH WIDTH 2 FT.

GRAVEL DEPTH 7 FT IN. TOTAL LENGTH 93 FT.

NUMBER OF TRENCHES 1 TOTAL BOTTOM AREA 657

SEEPAGE PITS, INSIDE DIAMETER _____ FT. DEPTH BELOW INLET _____ FT.

ABSORBENT AREA _____ SQ. FT.

REMARKS 5/2/85¹⁰¹⁴ - DITCH DUG OK NOW ADD STONE
5/2/85 1240 - SKIPSAD GRAIG ALREADY HERE & SAID
OK TO BACK FILL MOST OF DITCH
BACK FILLED ONE MORE TRUCK LOAD
TO BE ADDED

95
7
665

DATE SYSTEM APPROVED 5/2/85

INSPECTOR Raymond Hodger