

8/8/01
Layout
a.m.

9/5/01
Final
PM

9/6/01
Final
PM

ISSUE DATE: 8/6/2001

APPROVAL DATE: 9/6/01

PERMIT
INDEXED

P 515973-E
A 59914-R

ON-SITE SEWAGE DISPOSAL SYSTEM
HOWARD COUNTY HEALTH DEPARTMENT
BUREAU OF ENVIRONMENTAL HEALTH

04-363884

Fogle's Septic Clean, Inc IS PERMITTED TO INSTALL ALTER

ADDRESS: 580 Obrecht Road PHONE NUMBER: 410-795-5670

SUBDIVISION: Monticello LOT NUMBER: 42

ADDRESS: 14309 Fox Creek Court PROPERTY OWNER: D.R. Horton Custom

SEPTIC TANK CAPACITY (GALLONS): 1250 (TOP SEAM)

PUMP CHAMBER CAPACITY (GALLONS): N/A

NUMBER OF BEDROOMS: 4

SQUARE FEET PER BEDROOM: 180

LINEAR FEET OF TRENCH REQUIRED: 240

TRENCHES:	Trench to be 2.0 feet wide. Inlet 3.0 feet below original grade. Bottom maximum depth 6.0 feet below original grade. Effective area begins at 3.0 feet below original grade. 3.0 feet of stone below distribution pipe.
LOCATION:	Begin trenches 180 feet down the left lot line and 70 feet off that same lot line as seen when facing the lot from Fox Creek Court. Run trenches on contour in both directions.
NOTES:	

PLANS APPROVED: Amy Mc Millen OK SRK 4/12/01 DATE: 4-3-01


- NOTE: PERMIT VOID AFTER 2 YEARS
- NOTE: CONTRACTOR RESPONSIBLE FOR SCHEDULING A PRE-CONSTRUCTION INSPECTION FOR ALL INSTALLATIONS
- NOTE: WATERTIGHT SEPTIC TANKS REQUIRED
- NOTE: ALL PARTS OF SEPTIC SYSTEM SHALL BE 100 FEET FROM ANY WATER WELL
- NOTE: MANHOLE RISERS REQUIRED ON ALL SEPTIC TANKS AND PUMP CHAMBERS

NEITHER THE HOWARD COUNTY COUNCIL NOR THE HEALTH DEPARTMENT IS RESPONSIBLE FOR THE SUCCESSFUL OPERATION OF ANY SYSTEM PERMITTEE RESPONSIBLE FOR OBTAINING FINAL APPROVAL ON THIS PERMIT CALL 410-313-2640 FOR INSPECTION OF SEPTIC SYSTEM

~~CALL PERMITS~~
~~AND RETURNS~~ 12-12-01
B00133555
28x15 DECK

0515973-E

NOT TO SCALE

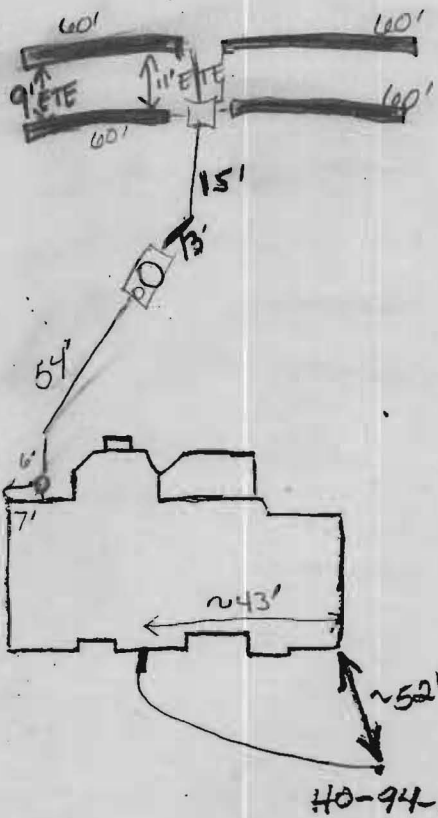

TRENCH DATA

TRENCH WIDTH 2'
 TRENCH INLET DEPTH 3'
 TRENCH BOTTOM DEPTH 6'
 DEPTH OF STONE 3'
 NUMBER OF TRENCHES 4
 TOTAL TRENCH LENGTH 240'
 ABSORBENT AREA 720 ft²
 DISTRIBUTION BOX LEVEL yes
 BAFFLE IN DISTRIBUTION BOX yes

SEPTIC TANK DATA

SEPTIC TANK 1250 T.S. GALLONS
 MANHOLE RISER center
 6 INCH INSPECTION PORT front
 PUMP CHAMBER DATA N/A
 PUMP CHAMBER GALLONS _____
 MANHOLE RISER _____
 ALARM _____
 PUMP PERFORMANCE TEST _____

Fox Creek Court

PRE-CONSTRUCTION INSPECTION: 8/8/01 Layout as per B.P. plan. Easement staked. (BB)

INSPECTION COMMENTS: 9/5/01 No TRENCHES DUG (KG) 9/6/01 Conn To House-ok COVER TRENCHES-ALL (KG) 10/1/01 WPI ok (KG)

INSPECTOR Loedel, K

DATE SYSTEM APPROVED 9/6/01