

C1 2886 SEQUENCE NO. (OEP USE ONLY)
 (THIS NUMBER IS TO BE PUNCHED IN COLS. 3-6 ON ALL CARDS)

STATE OF MARYLAND WELL COMPLETION REPORT
 FILL IN THIS FORM COMPLETELY PLEASE PRINT OR TYPE

THIS REPORT MUST BE SUBMITTED WITHIN 45 DAYS AFTER WELL IS COMPLETED.
 COUNTY NUMBER **A34312**

DATE Received [] DATE WELL COMPLETED **092084** Depth of Well **160** (TO NEAREST FOOT) FROM "PERMIT TO DRILL WELL" **H0-81-0713**

OWNER **REUWER FOUR DEN** first name **GLENELG MANOR** TOWN **GLENELG**
 STREET OR RFD **1721** SUBDIVISION **SIMPSON WOOD** SECTION **2** LOT **7A**

WELL LOG
 Not required for driven wells

STATE THE KIND OF FORMATIONS PENETRATED, THEIR COLOR, DEPTH, THICKNESS AND IF WATER BEARING

DESCRIPTION (Use additional sheets if needed)	FEET		Check if water bearing
	FROM	TO	
Top Soil	0	2	
Sandy	2	20	
Sand Stone	20	25	✓
Micka	25	45	
Sand Stone	45	50	✓
Micka	50	160	

GROUTING RECORD
 WELL HAS BEEN GROUTED YES NO
 TYPE OF GROUTING MATERIAL
 CEMENT **CM** BENTONITE CLAY **BC**
 NO. OF BAGS **6** NO. OF POUNDS **600**
 GALLONS OF WATER **36**
 DEPTH OF GROUT SEAL (to nearest foot) from **0** ft. to **32** ft.

CASING RECORD
 casing types insert appropriate code below
 ST STEEL **CO** CONCRETE
 PL PLASTIC **OT** OTHER
 MAIN CASING TYPE **PL** Nominal diameter (nearest inch) **6** Total depth of main casing (nearest foot) **34**

OTHER CASING (if used)
 diameter inch [] depth (feet) from [] to []

SCREEN RECORD
 screen type or open hole insert appropriate code below
 ST STEEL **BR** BRASS **HO** OPEN HOLE
 PL PLASTIC **OT** OTHER

C2
 DEPTH (nearest ft.)
 E A C H S C R E E N
 1 **H0** **32** **160**
 2 [] [] [] [] [] [] [] [] [] []
 3 [] [] [] [] [] [] [] [] [] []
 SLOT SIZE 1 [] 2 [] 3 []
 DIAMETER OF SCREEN [] (NEAREST INCH)

GRAVEL PACK [] IF WELL DRILLED WAS FLOWING WELL INSERT F IN BOX 68

OEP USE ONLY (NOT TO BE FILLED IN BY DRILLER)
 T [] (E.R.O.S.) WQ [] [] []
 TELESCOPE CASING [] LOG INDICATOR [] OTHER DATA [] [] []


C3
PUMPING TEST
 HOURS PUMPED (nearest hour) **3**
 PUMPING RATE (gal. per min. to nearest gal.) **5**
 METHOD USED TO MEASURE PUMPING RATE **Bucko**
 WATER LEVEL (distance from land surface) BEFORE PUMPING **20** WHEN PUMPING **43**
 TYPE OF PUMP USED (for test) **A** air **P** piston **T** turbine **C** centrifugal **R** rotary **O** other (describe below) **J** jet **S** submersible

PUMP INSTALLED
 DRILLER WILL INSTALL PUMP YES NO
 IF DRILLER INSTALLS PUMP, THIS SECTION MUST BE COMPLETED FOR ALL WELLS EXCEPT HOME USE
 TYPE OF PUMP INSTALLED PLACE (A,C,J,P,R,S,T,O) IN BOX-SEE ABOVE: **29**
 CAPACITY: GALLONS PER MINUTE (to nearest gallon) [] [] [] [] [] [] [] [] [] []
 PUMP HORSE POWER [] [] [] [] [] [] [] [] [] []
 PUMP COLUMN LENGTH (nearest ft.) [] [] [] [] [] [] [] [] [] []
 CASING HEIGHT (circle appropriate box and enter casing height) above } LAND SURFACE **2** (nearest foot) below }

CIRCLE APPROPRIATE LETTER
A A WELL WAS ABANDONED AND SEALED WHEN THIS WELL WAS COMPLETED
E ELECTRIC LOG OBTAINED
P TEST WELL CONVERTED TO PRODUCTION WELL

I HEREBY CERTIFY THAT THIS WELL HAS BEEN CONSTRUCTED IN ACCORDANCE WITH COMAR 10.17.13 "WELL CONSTRUCTION" AND IN CONFORMANCE WITH ALL CONDITIONS STATED IN THE ABOVE CAPTIONED PERMIT, AND THAT THE INFORMATION PRESENTED HEREIN IS ACCURATE AND COMPLETE TO THE BEST OF MY KNOWLEDGE.

DRILLERS IDENT. NO. **273**
 DRILLERS SIGNATURE **Ralph Mayne**
 DRILLERS SIGNATURE (MUST MATCH SIGNATURE ON APPLICATION) **Ralph E. Mayne**
 SITE SUPERVISOR (sign. of driller or journeyman responsible for sitework if different from permittee)

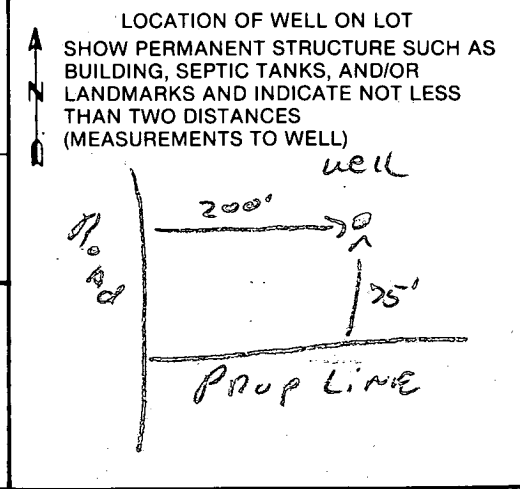

B 1 2751

SEQUENCE NO. (OEP USE ONLY)

STATE OF MARYLAND PERMIT TO DRILL WELL

OEP PERMIT NUMBER

40-81-0713

(THIS NUMBER IS TO BE PUNCHED IN COLS. 3-6 ON ALL CARDS)

please print or type

fill in this form completely

Date Received 9/20/84 9:30 AM

AP2284

OWNER INFORMATION

OWNER: RENEWER HOWARD

STREET: 0194 BALTIMORE WAYL PIKE

TOWN: ELLICOTT CITY MD 21043

B 3

LOCATION OF WELL

COUNTY: HOWARD

SUBDIVISION: GLEWELG MANOR

SECTION: 2 LOT: 2A

NEAREST TOWN: GLEWELG

MILES FROM TOWN: 1 MI

DRILLER INFORMATION

DRILLER'S NAME: Ralph Mayne License No. 80


FIRM NAME: Ralph Mayne (well drilling)

ADDRESS: 9120 Brown Church Rd. Mt. Airy

SIGNATURE: Ralph Mayne Date: 8/17/84

B 4

DIRECTION OF WELL FROM TOWN (CIRCLE BOX)

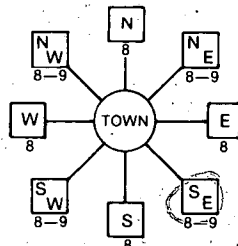

NEAR WHAT ROAD: Folley Quarter Rd

ON WHICH SIDE OF ROAD (CIRCLE APPROPRIATE BOX)



DISTANCE FROM ROAD: 2500 FT

WELL INFORMATION

APPROX. PUMPING RATE (GAL. PER MIN.): 5

AVERAGE DAILY QUANTITY NEEDED (GAL. PER DAY): 500

USE FOR WATER (CIRCLE APPROPRIATE BOX)

- Home (single or double household unit only) - circled
Farming (livestock watering & agricultural irrigation)
Industrial, commercial, state and federal gov. other (requires appropriation permit)
Public or private water company (requires appropriation permit and state health department approval)
Test, observation, monitoring (may require appropriation permit)

NOT TO BE FILLED IN BY DRILLER HEALTH DEPARTMENT APPROVAL

COUNTY NAME: Howard COUNTY NO. A34312

OEP SIGNATURE: [Signature] STATE HEALTH INSERT S

DATE ISSUED: 090784 CO SIGNATURE: [Signature] EXP. DATE: 3/7/85

NORTH GRID: 516000 EAST GRID: 0811000

APPROXIMATE DEPTH OF WELL: 150 FEET

APPROXIMATE DIAMETER OF WELL: 6 INCH

METHOD OF DRILLING (circle one)

- Bored (or Augered) - circled
Jetted
Jetted & Driven
Air-Rotary - circled
Air-PerCussion
Rotary (Hydraulic Rotary)
Cable
Reverse-Rotary
Drive-Point
Other

REPLACEMENT OR DEEPEMED WELLS (CIRCLE APPROPRIATE BOX)

- N: This well will not replace an existing well - circled
Y: This well will replace a well that will be abandoned and sealed
S: This well will replace a well that will be used as a standby
D: This well will deepen an existing well
Permit number of well to be replaced or deepened: [Blank]

Not to be filled in by driller (OEP USE ONLY)

APPROP. PERMIT NUMBER: GAP

FORCE INITIALS IN BOX: CW PERMIT No. 40-81-0713

SPECIAL CONDITIONS

SHOW MAJOR FEATURES OF BOX & LOCATE WELL WITH AN X


SOURCES OF DRILLING WATER

- 1. well
2.
3.

WRITE THE BOX NUMBER FROM THE MAP HERE

Box numbers: E 8101, N 5106

DRAW A SKETCH BELOW SHOWING LOCATION OF WELL IN RELATION TO NEARBY TOWNS AND ROADS AND GIVE DISTANCE FROM WELL TO NEAREST ROAD JUNCTION

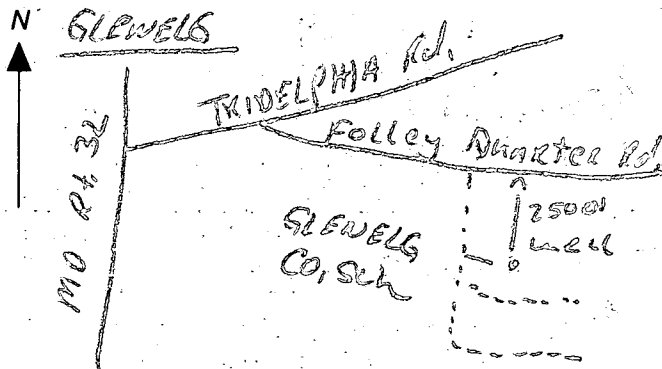

WP I

5/3/85 - all work completed outside
8 m side house. Pitless + line 3 1/2 ft.
below grade. P.R.V. on line at pressure
tank.

J

BERNICE-WHITE
UPPER LEFT COI
30' CAS 16
1 A. 61
28 DRW

FILE INQUIRY FORM

Property Address: 12729 F.O. Rd

T/C w/buyer Re: 1 BR add'n on right-rear
portion of house

Advised owner no problem expected, contingent
on insp (via auger?) to verify system operation
HR