

5/16/01 - Final AM

Index card

PERMIT

P 515242-A

SEWAGE DISPOSAL SYSTEM
HOWARD COUNTY HEALTH DEPARTMENT
BUREAU OF ENVIRONMENTAL HEALTH
410-313-2640

A 59914-F

ISSUE DATE 5/11/2001

APPROVAL DATE 5/18/01

04-363841
INDEXED

Fogles Septic Clean Inc IS PERMITTED TO INSTALL ALTER

ADDRESS 580 Obrecht Road, Sykesville, MD 21784 PHONE 410-795-5670

SUBDIVISION Monticello LOT NUMBER 30 ADDRESS 14312 Fox Creek Court

PROPERTY OWNER STERLING WINN PROPERTY OWNER'S ADDRESS 1370 Piccard Dr, #230

SEPTIC TANK CAPACITY 1500 GALLONS
Rockville, MD 20850

PUMP CHAMBER CAPACITY N/A GALLONS * WATERTIGHT SEPTIC TANK REQUIRED *

NUMBER OF BEDROOMS 5

SQUARE FEET PER BEDROOM 180

LINEAR FEET OF TRENCH REQUIRED 225

TRENCHES: Trenches to be 2 feet wide. Inlet 3 feet below original grade. Bottom maximum depth

7 feet below original grade. 4 feet of stone below distribution box pipe

LOCATION: Place distribution box 195 feet down the right (306.51') lot line and 80 feet

off this same lot line. Run (5) 60' trenches toward right lot line.

Trenches to be spaced 10 feet apart center-to-center to allow room for

three systems. 12/27/00 OK (BA)

OK to extend upper trenches larger to full edge of septic area for economy: i.e. let 60', next 70',

Site is not contained as on plan. OK to install 2 trenches (112ft long each) if only extends 15-20

feet of SDA and keeps to high part of lot. PIP 5/18/01 (per TC contractor)

PLANS APPROVED Mark Rifkin, R.S. DATE 11/22/2000

PERMIT VOID AFTER 2 YEARS

NOTE: CONTRACTOR RESPONSIBLE FOR SCHEDULING A PRE-CONSTRUCTION INSPECTION FOR ALL INSTALLATIONS

NOTE: TOP OF SEPTIC TANKS ARE TO BE NO DEEPER THAN 3.0 FEET BELOW FINISH GRADE

NOTE: WATERTIGHT SEPTIC TANKS REQUIRED

NOTE: CLEANOUT REQUIRED EVERY 70 FEET OF SEWER LINE AND/OR AT 90° SWEEPS IN LINES FROM HOUSE TO DRAIN FIELDS, 90° ELBOWS ARE NOT ACCEPTABLE

NOTE: ALL PARTS OF SEPTIC SYSTEMS (I.E. TANK, DISTRIBUTION BOX, DRAINFIELDS) TO BE 100 FEET FROM ANY WATER WELL UNLESS OTHERWISE SPECIFICALLY AUTHORIZED

NOTE: NO ABSORPTION TRENCH TO EXCEED 100 FEET IN LENGTH UNLESS SPECIFICALLY AUTHORIZED

NOTE: ALL PIPE FROM HOUSE TO SEPTIC TANK MUST BE CAST IRON OR SCHEDULE 35/40 PVC OR ABS

NOTE: MANHOLE RISERS REQUIRED ON ALL SEPTIC TANKS AND PUMP CHAMBERS

NOTE: DISTRIBUTION BOXES MUST HAVE BAFFLES

NOTE: IF PUMPED SEPTIC SYSTEM REQUIRED, (1) SEPTIC PUMP DETAIL TO BE PROVIDED BY INSTALLER PRIOR TO ISSUANCE OF SEPTIC PERMIT (2) PUMP PERFORMANCE TEST IS NECESSARY PRIOR TO HEALTH DEPARTMENT APPROVAL OF SEPTIC PERMIT

BUILDING PERMIT SIGNED

AND RETURNED 6-27-02


800137205-DECK

4/3/03 800141050 - DECK

NEITHER THE HOWARD COUNTY COUNCIL NOR THE HEALTH DEPARTMENT IS RESPONSIBLE FOR THE SUCCESSFUL OPERATION OF ANY SYSTEM
PERMITTEE RESPONSIBLE FOR OBTAINING FINAL APPROVAL ON THIS PERMIT
CALL 410-313-2640 FOR INSPECTION OF SEPTIC SYSTEM

515242-A

NOT TO SCALE

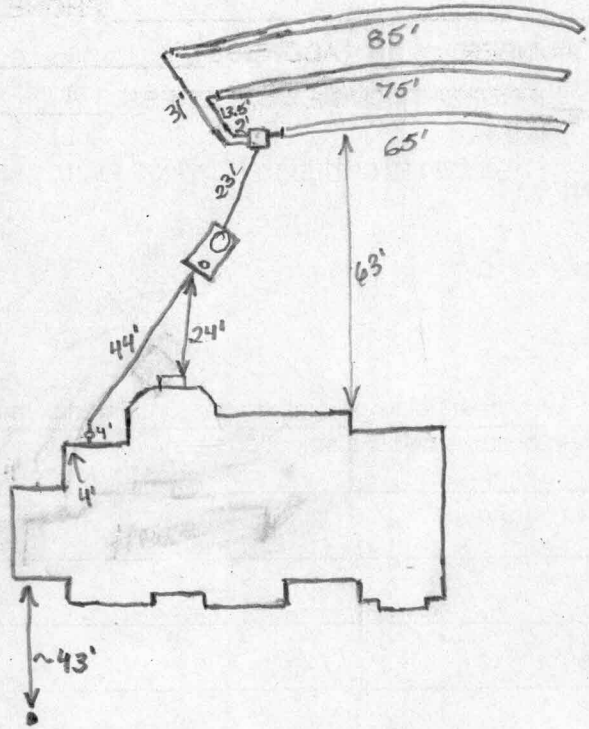

HO-94-2163

Fox Creek Ct.

TRENCH DATA

TRENCH WIDTH 2'
 TRENCH INLET DEPTH 3'
 TRENCH BOTTOM DEPTH 7'
 DEPTH OF STONE 4'
 NUMBER OF TRENCHES 3
 TOTAL TRENCH LENGTH 225'
 ABSORBENT AREA 900 sq ft.
 DISTRIBUTION BOX LEVEL Yes
 BAFFLE IN DISTRIBUTION BOX Yes

SEPTIC TANK DATA

SEPTIC TANK 1,500^{TS} GALLONS
 MANHOLE RISER Yes
 6 INCH INSPECTION PORT Yes

PUMP CHAMBER DATA

~~PUMP CHAMBER GALLONS _____~~
~~MANHOLE RISER _____~~
~~ALARM _____~~
~~PUMP PERFORMANCE TEST _____~~

PRE-CONSTRUCTION INSPECTION: Layout OK, see modification to specs to allow longer trenches for economy of space. PJP 5/16/01

INSPECTION COMMENTS: House connection partially made, needs rest of pipe to ST. Septic tank set only. PJP 5/17/01
5/18/01 System satisfactory. O.K. to cover. BB

BUILDING PERMIT SIGNED _____
AND RETURNED _____

INSPECTOR B. Baker DATE SYSTEM APPROVED 5/18/01