

7/31/01  
Layout to  
Follow Lot 9

8/16/01  
Final  
10:00 - 10:30

# PERMIT

SEWAGE DISPOSAL SYSTEM  
HOWARD COUNTY HEALTH DEPARTMENT  
BUREAU OF ENVIRONMENTAL HEALTH

410-313-2640  
INDEXED

P 515953-B

A 59914-0

ISSUE DATE 7/24/2001

APPROVAL DATE 9/19/01

04-363841

Fogles Septic Clean, Inc IS PERMITTED TO INSTALL  ALTER

ADDRESS 580 Obrecht Road, Sykesville, MD 21784 PHONE 410-795-5670

SUBDIVISION Monticello LOT NUMBER 39 ADDRESS 14321 Fox Creek Court

PROPERTY OWNER D R Horton Custom Homes PROPERTY OWNER'S ADDRESS 1370 Piccard Dr, #230

SEPTIC TANK CAPACITY 1250 GALLONS \* WATERTIGHT SEPTIC TANK REQUIRED \* (20850)

PUMP CHAMBER CAPACITY N/A GALLONS

NUMBER OF BEDROOMS 4

SQUARE FEET PER BEDROOM 180

LINEAR FEET OF TRENCH REQUIRED 180

TRENCHES: Trenches to be 2 feet wide. Inlet 3 feet below original grade. Bottom maximum depth 7 feet below original grade. 4 feet of stone below distribution box.

LOCATION: Place the distribution box 80' down the left lot line and 45 feet off this same lot line. Run (3) 60' trenches on contour to front of lot.

## BUILDING PERMIT SIGNED

## AND RETURNED

31605 BOO152676-IG POOL  
63005 BOO154744-DECK

PLANS APPROVED Mark Rifkin, R.S. OK SRK 2/16/01 DATE 2/14/2001

PERMIT VOID AFTER 2 YEARS

NOTE: CONTRACTOR RESPONSIBLE FOR SCHEDULING A PRE-CONSTRUCTION INSPECTION FOR ALL INSTALLATIONS

NOTE: TOP OF SEPTIC TANKS ARE TO BE NO DEEPER THAN 3.0 FEET BELOW FINISH GRADE

NOTE: WATERTIGHT SEPTIC TANKS REQUIRED

NOTE: CLEANOUT REQUIRED EVERY 70 FEET OF SEWER LINE AND/OR AT 90° SWEEPS IN LINES FROM HOUSE TO DRAIN FIELDS, 90° ELBOWS ARE NOT ACCEPTABLE

NOTE: ALL PARTS OF SEPTIC SYSTEMS (I.E. TANK, DISTRIBUTION BOX, DRAINFIELDS) TO BE 100 FEET FROM ANY WATER WELL UNLESS OTHERWISE SPECIFICALLY AUTHORIZED

NOTE: NO ABSORPTION TRENCH TO EXCEED 100 FEET IN LENGTH UNLESS SPECIFICALLY AUTHORIZED

NOTE: ALL PIPE FROM HOUSE TO SEPTIC TANK MUST BE CAST IRON OR SCHEDULE 35/40 PVC OR ABS

NOTE: MANHOLE RISERS REQUIRED ON ALL SEPTIC TANKS AND PUMP CHAMBERS

NOTE: DISTRIBUTION BOXES MUST HAVE BAFFLES


NOTE: IF PUMPED SEPTIC SYSTEM REQUIRED, (1) SEPTIC PUMP DETAIL TO BE PROVIDED BY INSTALLER PRIOR TO ISSUANCE OF SEPTIC PERMIT (2) PUMP PERFORMANCE TEST IS NECESSARY PRIOR TO HEALTH DEPARTMENT APPROVAL OF SEPTIC PERMIT

NEITHER THE HOWARD COUNTY COUNCIL NOR THE HEALTH DEPARTMENT IS RESPONSIBLE FOR THE SUCCESSFUL OPERATION OF ANY SYSTEM  
PERMITTEE RESPONSIBLE FOR OBTAINING FINAL APPROVAL ON THIS PERMIT  
CALL 410-313-2640 FOR INSPECTION OF SEPTIC SYSTEM

P 515953-B

NOT TO SCALE

well  
HO-94-2120

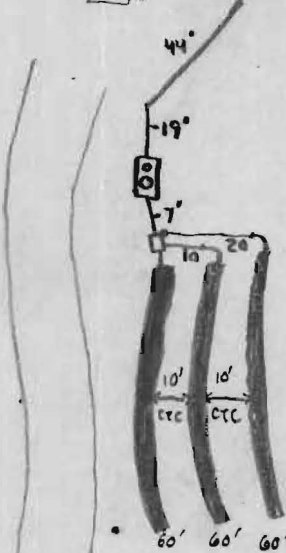

FOX CREEK COURT

**TRENCH DATA**

TRENCH WIDTH 2'  
 TRENCH INLET DEPTH 3'  
 TRENCH BOTTOM DEPTH 7'  
 DEPTH OF STONE 4'  
 NUMBER OF TRENCHES 3  
 TOTAL TRENCH LENGTH 180  
 ABSORBENT AREA 720ft<sup>2</sup>  
 DISTRIBUTION BOX LEVEL ✓  
 BAFFLE IN DISTRIBUTION BOX ✓

**SEPTIC TANK DATA** Baffles in ✓

SEPTIC TANK 1250TS GALLONS  
 MANHOLE RISER on center  
 6 INCH INSPECTION PORT on front

**PUMP CHAMBER DATA**

PUMP CHAMBER GALLONS NA  
 MANHOLE RISER NA  
 ALARM NA  
 PUMP PERFORMANCE TEST NA

PRE-CONSTRUCTION INSPECTION: 7/31/01-SDA STAGED, INSTALL 3-60' TRENCHES TOWARDS RD,

STARTING 1ST TRENCH ON CONTOUR OUT OF SDA SLIGHTLY TO CONSERVE FUTURE REPAIR AREA, BUILDER MAY HAVE TO ADJ HOUSE SEWER BACK TO WHAT WAS APPROVED ON BP PLAN  
 INSPECTION COMMENTS: OR PUMP TANK MAY BE REQUIRED -SRW

8/16/01-OK TO COVER ALL WORK, HOLD FOR HOUSE CONN. -SRW 8-28-01 WPI DK KG

9/19/01-HOUSE CONN. VERIFIED OVER THE PHONE W/BUILDER -SRW

INSPECTOR Steven R. Krieg

DATE SYSTEM APPROVED 9/19/01

