

10/2/01 LAYOUT 11 AM  
10/4/01 FINAL PM

ISSUE DATE: 9/25/2001

APPROVAL DATE: 12/28/01

**PERMIT  
INDEXED**

P 516043-A

A 59914-J

**ON-SITE SEWAGE DISPOSAL SYSTEM  
HOWARD COUNTY HEALTH DEPARTMENT  
BUREAU OF ENVIRONMENTAL HEALTH**

**04-363795**

Fogles Septic Clean, Inc IS PERMITTED TO  INSTALL  ALTER

ADDRESS: 580 Obrecht Road PHONE NUMBER: 410-795-5670

SUBDIVISION: Monticello LOT NUMBER: 34

ADDRESS: 14333 Fox Creek Court PROPERTY OWNER: D.R. Horton

SEPTIC TANK CAPACITY (GALLONS): 1250 (TOPSEAM)

PUMP CHAMBER CAPACITY (GALLONS): N/A

NUMBER OF BEDROOMS: 4

SQUARE FEET PER BEDROOM: 180

LINEAR FEET OF TRENCH REQUIRED: 240

TRENCHES:	Trench to be 3.0 feet wide. Inlet 3.5 feet below original grade. Bottom maximum depth 5.5 feet below original grade. Effective area begins at 2.0 feet below original grade. 2.0 feet of stone below distribution pipe.
LOCATION:	Starting from the front right lot corner, place the distribution box 140' down the right lot line and 35' off this same lot line. Run (3) trenches on contour toward right-rear portion of lot.
NOTES:	

PLANS APPROVED: MER OK SRK 7/13/01 DATE: 7/6/01


- NOTE: PERMIT VOID AFTER 2 YEARS
- NOTE: CONTRACTOR RESPONSIBLE FOR SCHEDULING A PRE-CONSTRUCTION INSPECTION FOR ALL INSTALLATIONS
- NOTE: WATERTIGHT SEPTIC TANKS REQUIRED
- NOTE: ALL PARTS OF SEPTIC SYSTEM SHALL BE 100 FEET FROM ANY WATER WELL
- NOTE: MANHOLE RISERS REQUIRED ON ALL SEPTIC TANKS AND PUMP CHAMBERS

**NEITHER THE HOWARD COUNTY COUNCIL NOR THE HEALTH DEPARTMENT IS  
RESPONSIBLE FOR THE SUCCESSFUL OPERATION OF ANY SYSTEM  
PERMITTEE RESPONSIBLE FOR OBTAINING FINAL APPROVAL ON THIS PERMIT  
CALL 410-313-2640 FOR INSPECTION OF SEPTIC SYSTEM**

10160043-A

NOT TO SCALE

INDEXED

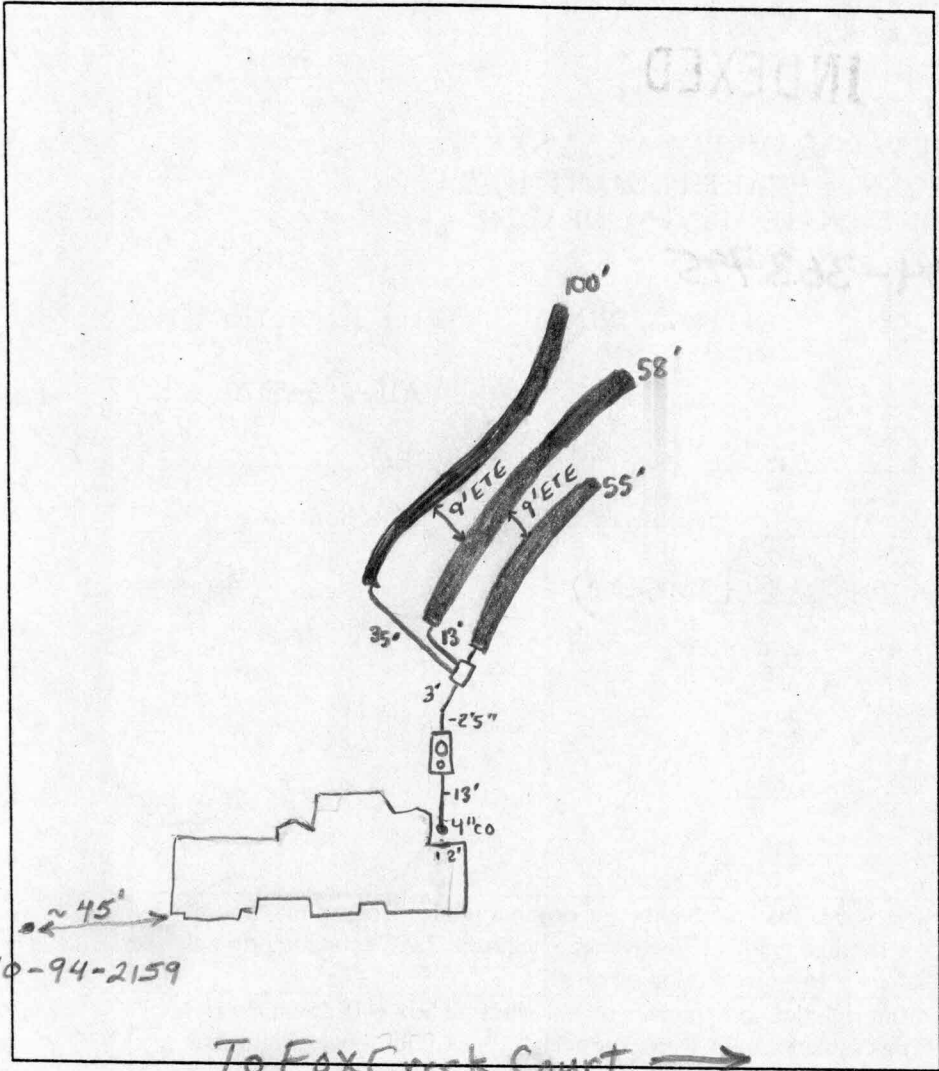

40-94-2159

TRENCH DATA	
TRENCH WIDTH	<u>3'</u>
TRENCH INLET DEPTH	<u>3.5'</u>
TRENCH BOTTOM DEPTH	<u>5.5'</u>
DEPTH OF STONE	<u>2'</u>
NUMBER OF TRENCHES	<u>3</u>
TOTAL TRENCH LENGTH	<u>240'</u>
ABSORBENT AREA	<u>720ft<sup>2</sup></u>
DISTRIBUTION BOX LEVEL	<input checked="" type="checkbox"/>
BAFFLE IN DISTRIBUTION BOX	<input checked="" type="checkbox"/>

SEPTIC TANK DATA	
SEPTIC TANK	<u>1250TS</u> GALLONS
MANHOLE RISER	<u>on center</u>
6 INCH INSPECTION PORT	<u>on front</u>
PUMP CHAMBER DATA	
PUMP CHAMBER GALLONS	<u>NA</u>
MANHOLE RISER	<u>NA</u>
ALARM	<u>NA</u>
PUMP PERFORMANCE TEST	<u>NA</u>

PRE-CONSTRUCTION INSPECTION: 10/2/01 OK TO INSTALL PER PLAN (K6135)

INSPECTION COMMENTS: 10/2/01 Distance from well to driveway ~ 7' but not paved yet, may need barrier. (BB)

10/4/01- OK TO COVER ALL WORK, NEEDS HOUSE CONNECTION - (SRU)

12/28/01 House connection made according to builder. (BB)

INSPECTOR B. Baker DATE SYSTEM APPROVED 12/28/01