



5/7/03
Easement
Revision
O.K.
BB

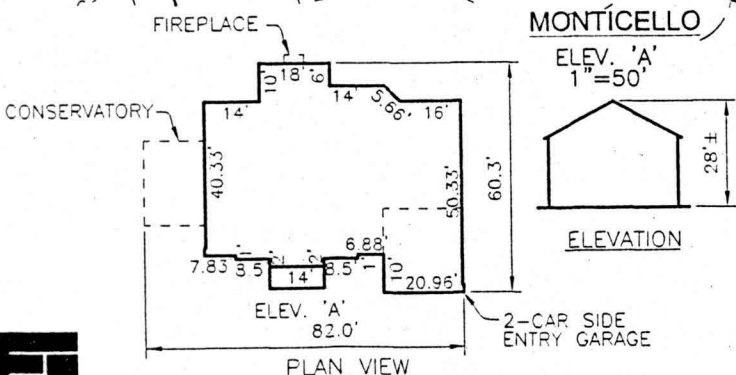

Approved Septic System Plan
Howard County Health Department

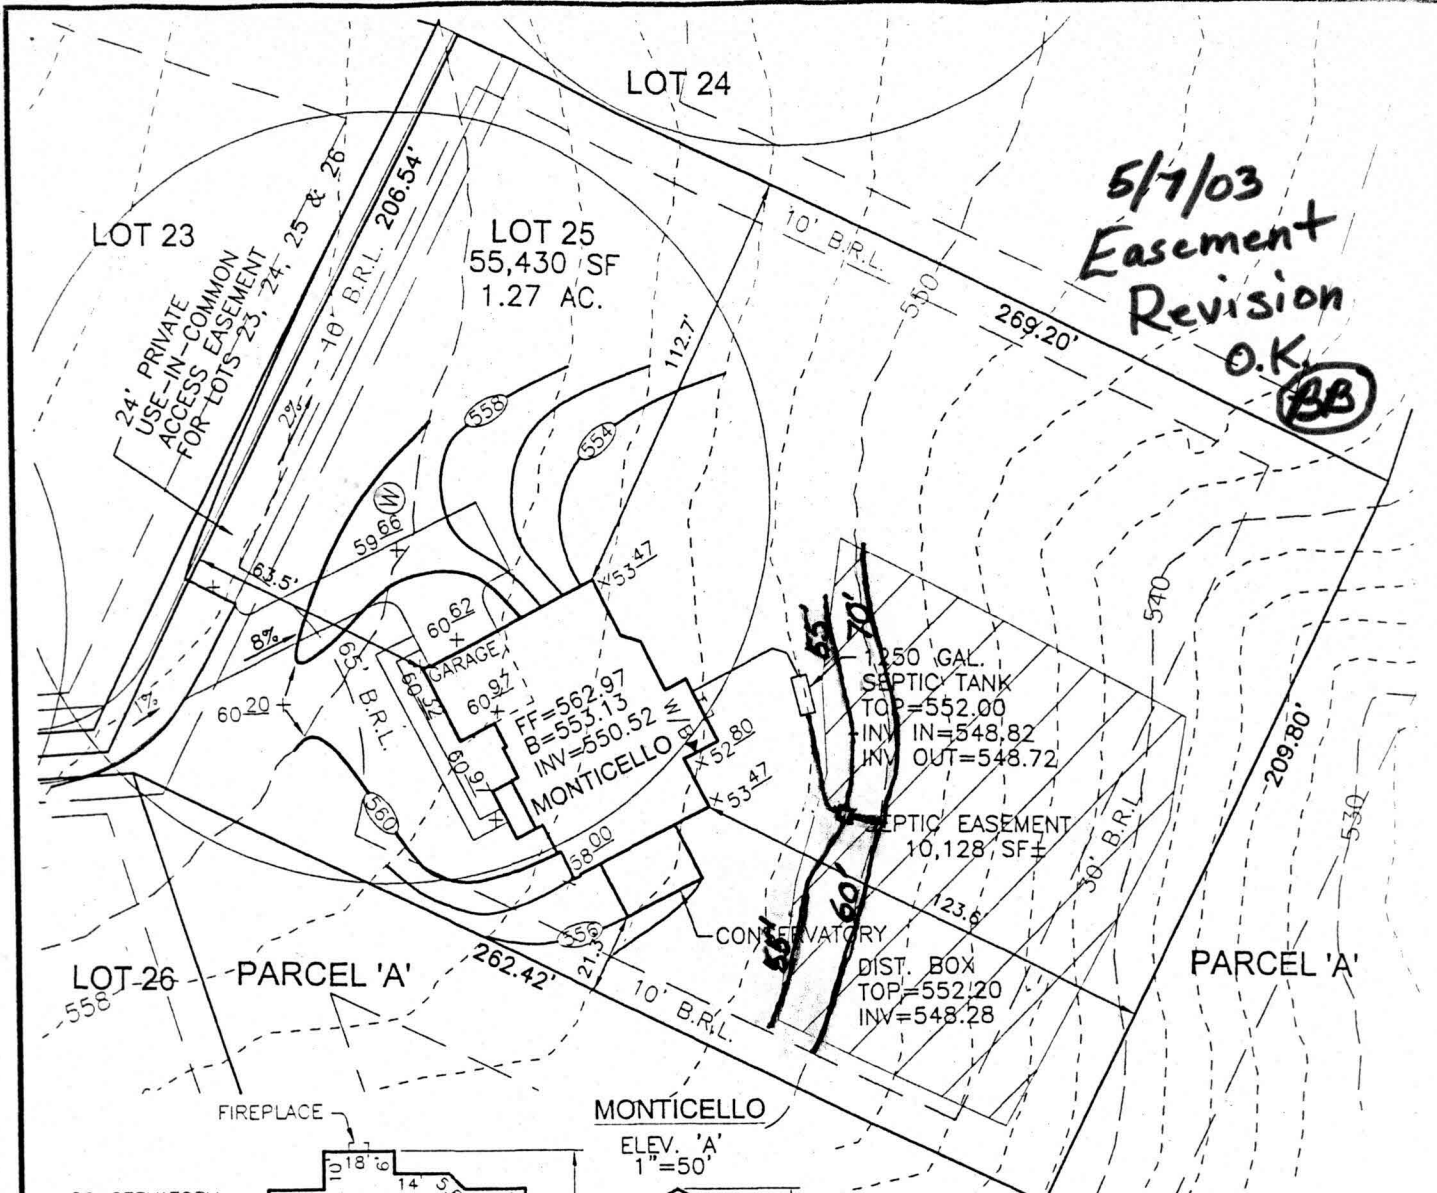

FREDERICK WARD ASSOCIATES, INC.

ENGINEERS
ARCHITECTS
SURVEYORS

7125 Riverwood Drive Columbia, Maryland 21046-2354
Phone: 410-290-9550 Fax: 410-720-6226
Bel Air, Maryland Columbia, Maryland Warrenton, Virginia

Brian Baker
Signature **5/7/03**
Date

SCALE 1"=50'
DRAWN BY CMH
CHECKED BY JCO
DATE APRIL 2003
W. O. # 2024059.0
SHEET # 1 OF 1

NVHomes
FOX CREEK SUBDIVISION
LOT 25

TAX MAP 15 BLOCKS 12 & 18
TAX MAP BLOCKS 7 & 13
3RD ELECTION DISTRICT

PARCEL '183'
HOWARD COUNTY, MARYLAND