

HOWARD COUNTY
 PERMIT APPLICATION

PERMIT NUMBER

Building Address 12789 Folly Quarter Rd
ElliotH City MD 21042
 Suite/Apt. #: _____ SDP/WP/Pettition #: _____
 Census Tract _____ Subdivision _____
 Section _____ Area _____ Lot _____
 Tax Map _____ Parcel _____ Grid _____
 Zoning _____ Map Coordinates _____ Lot size _____

Property Owner's Name John Riegel
 Address 12789 Folly Quarter Rd
 City ElliotH City State MD Zip Code 21042
 Home Phone 410-531-1691 Work Phone 410-365-9410
 Applicant's Name & Mailing Address, (if other than stated hereon): _____
 Phone _____ Fax _____

Existing Use SFD
 Proposed Use Front Porch
 Estimated Construction Cost \$ 10,000.00
 Description of Work Construct 9 x 50 Front Porch

Contractor Company SHANE
 Contact Person _____
 Address _____
 City _____ State _____ Zip Code _____
 License No. _____
 Phone _____ Fax _____

Occupant or Tenant _____
 Contact Name _____
 Address _____
 City _____ State _____ Zip Code _____
 Phone _____ Fax _____

Engineer or Architect Company NA
 Contact Person _____
 Address _____
 City _____ State _____ Zip Code _____
 Phone _____ Fax _____

BUILDING DESCRIPTION - COMMERCIAL

BUILDING DESCRIPTION - RESIDENTIAL

Building Characteristics
 Height: 12'
 No. of stories: 1
 Gross area, sq. ft. per floor: 450
 Use group: _____
 Construction type:
 Reinforced Concrete
 Structural Steel
 Masonry
 Wood Frame
 State Certified Modular

Utilities
 Water Supply:
 Public
 Private
 Sewage Disposal:
 Public
 Private
 Electric Yes No
 Gas Yes No
 Heating System:
 Electric Oil
 Natural Gas
 Propane Gas
 Sprinkler system: N/A
 Full
 Partial
 Other Suppression
 # of Heads _____

Building Characteristics
 SF Dwelling SF Townhouse
 Depth _____ Width _____
 1st floor: 9' 50'
 2nd floor: _____
 Basement: _____
 Finished Basement Unfinished Basement
 Crawl space Slab on Grade
 No. of Bedrooms 3
 Height: _____
 Multi-family dwellings:
 No. of efficiency units: _____
 No. of 1 BR units: _____
 No. of 2 BR units: _____
 No. of 3 BR units: _____
 Other Structure: _____
 Dimensions: _____
 Footings: _____
 Roof Height: _____
 State Certified Modular
 Manufactured Home

Utilities
 Water Supply:
 Public
 Private
 Sewage Disposal:
 Public
 Private
 Electric Yes No
 Gas Yes No
 Heating System:
 Electric Oil
 Natural Gas
 Propane Gas
 Sprinkler system: N/A
 NFPA #13D
 NFPA #13R
 Other: _____

THE UNDERSIGNED HEREBY CERTIFIES AND AGREES AS FOLLOWS: (1) THAT HE/SHE IS AUTHORIZED TO MAKE THIS APPLICATION; (2) THAT THE INFORMATION IS CORRECT; (3) THAT HE/SHE WILL COMPLY WITH ALL REGULATIONS OF HOWARD COUNTY WHICH ARE APPLICABLE THERETO; (4) THAT HE/SHE WILL PERFORM NO WORK ON THE ABOVE REFERENCED PROPERTY NOT SPECIFICALLY DESCRIBED IN THIS APPLICATION; (5) THAT HE/SHE GRANTS COUNTY OFFICIALS THE RIGHT TO ENTER ONTO THIS PROPERTY FOR THE PURPOSE OF INSPECTING THE WORK PERMITTED AND POSTING NOTICES.

John Riegel
 Applicant's Signature
OWNER
 Title/Company


John Riegel
 Print Name
10/11/06
 Date

Checks payable to: **DIRECTOR OF FINANCE OF HOWARD COUNTY**
 ** PLEASE WRITE NEATLY AND LEGIBLY. **
 - FOR OFFICE USE ONLY -

AGENCY	DATE	SIGNATURE APPROVAL	DPZ SETBACK INFORMATION	PROPERTY ID#:
Land Development, DPZ			Front: _____	Filing fee \$ _____
State Highways			Rear: _____	Permit fee \$ _____
Building Official			Side: _____	Excise tax \$ _____
Dev. Engineering, DPZ			Side St.: _____	Add'l per. fee \$ _____
Health	<u>10/11/06</u>	<u>[Signature]</u>	All minimum setbacks met?	TOTAL FEES \$ _____
Fire Protection			YES <input type="checkbox"/> NO <input type="checkbox"/>	Sub-total paid \$ _____
Is Sediment Control approval required prior to issuance?			YES <input type="checkbox"/> NO <input type="checkbox"/>	Balance due \$ _____
YES <input type="checkbox"/> NO <input type="checkbox"/>			Is Entrance Permit required?	Check \$ _____
			YES <input type="checkbox"/> NO <input type="checkbox"/>	Validation # _____
CONTINGENCY CONSTRUCTION START: <input type="checkbox"/>			Historic District?	
ONE STOP SHOP: <input type="checkbox"/>			YES <input type="checkbox"/> NO <input type="checkbox"/>	
			Lot Coverage for NewTown Zone _____	
			SDP/Red-line approval date _____	Accepted by _____
Distribution of Copies- Write: Building Official				
Green: LDD, DPZ				
Yellow: DED, DPZ				
Pink: Health				
Gold: SHA				

- NOTES:
- 1) B.R.L. information, if shown, was obtained from existing record plat or local agencies and is not guaranteed by NTT, Inc.
 - 2) Building line and/or Flood Zone information is subject to the interpretation of the originator.
 - 3) NTT, Inc. does not certify to unshown or unrecorded encroachments or overlaps.
 - 4) Property markers NOT found, or guaranteed by this location.
 - 5) Setback distance accuracy: 1' ±

Existing Private Use In Common
Driveway Easement for Parcel 76

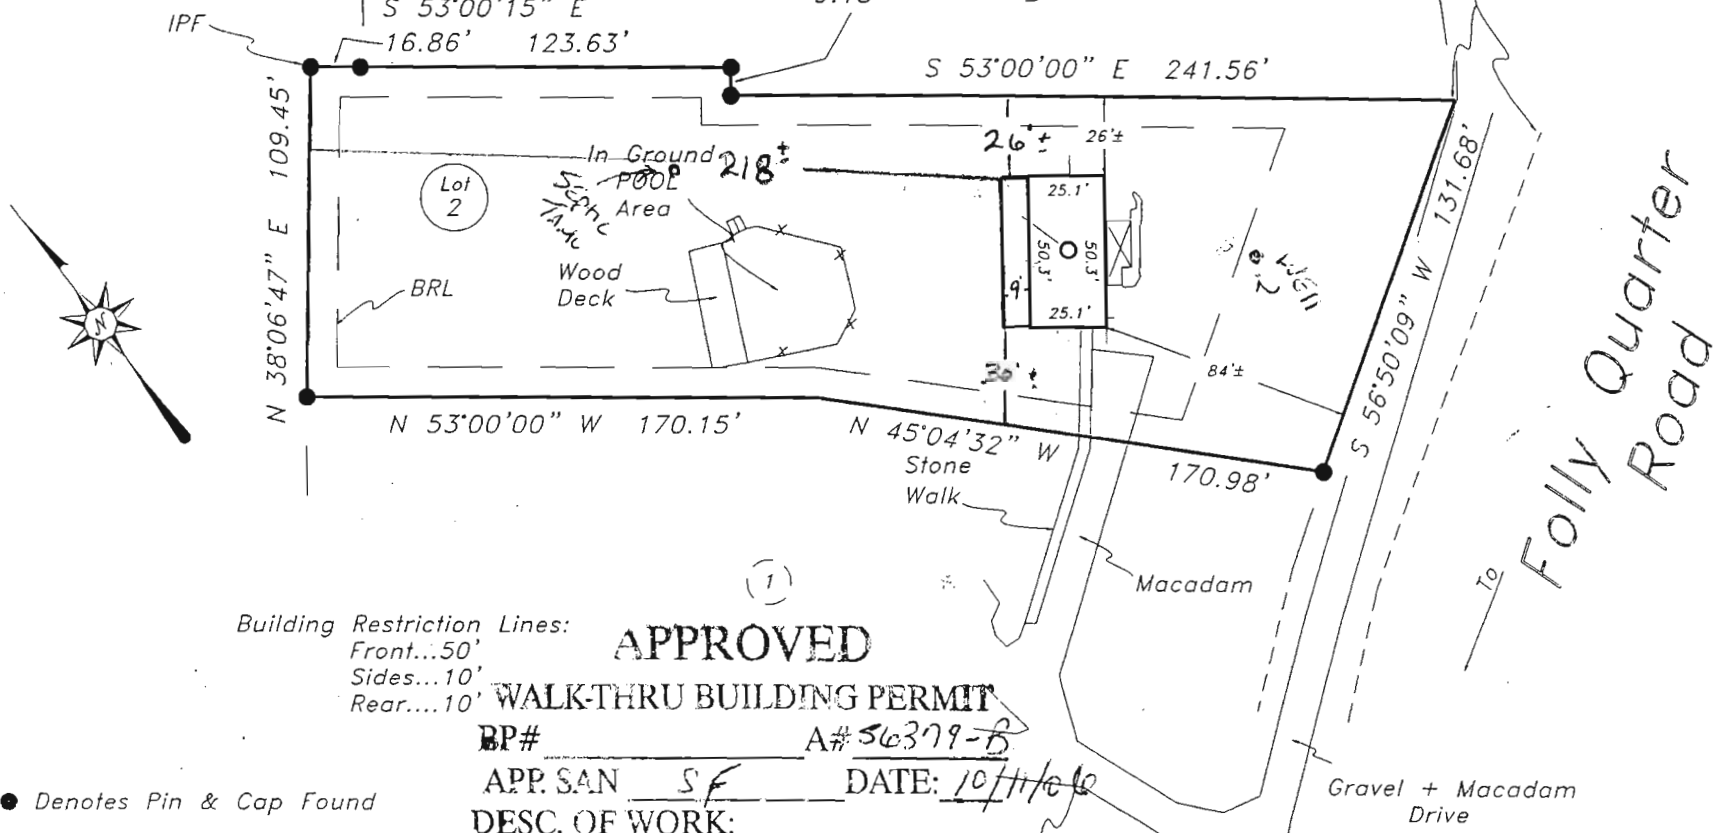

Building Restriction Lines:
Front...50'
Sides...10'
Rear...10'

APPROVED
WALK-THRU BUILDING PERMIT

BP# _____ A# 50379-B
APP. SAN SF DATE: 10/11/06
DESC. OF WORK: 9x50 front front

● Denotes Pin & Cap Found

Subject property is shown in Zone C on the FIRM Map of Howard County, Maryland on Community Panel # 240044 0021B. Effective 12-4-86
Subject property currently uses Lot 1's Macadam Drive for Ingress and Egress to dwelling from Common Driveway

This is to certify that I have surveyed the property shown hereon, being known as Lot 2, MAISEL PROPERTY and recorded among the land records of Howard County, Maryland in Plot 14525 folio for the purpose of locating the improvements thereon.



LOCATION DRAWING
12789 Folly Quarter Road
Howard County, Maryland
Election District No. 05

- * This plat is of benefit to the consumer only insofar as it is required by a lender or a title insurance company or its agent in connection with contemplated transfer, financing, or refinancing purposes.
- * This plat is not to be relied upon for the establishment of location of fences, garages, buildings, or other existing or future structures.
- * This plat does not provide for the accurate identification of property boundary lines, but such identification may not be required for the transfer of title or for securing financing or refinancing.

NTT Associates, Inc.
16205 Old Frederick Road
Mt. Airy, Maryland 21771
Ph. (410)442-2031
Fax No. (410)442-1315

Scale:	1" = 60'
Date:	7-17-06
Field By:	Don
Drawn By:	Don
Drawing #	AEC09257-06