

5/4/01 5/8/01  
Layout ASAP  
1:00

# PERMIT

SEWAGE DISPOSAL SYSTEM  
HOWARD COUNTY HEALTH DEPARTMENT  
BUREAU OF ENVIRONMENTAL HEALTH  
410-313-2640

P 514995

A 514268

ISSUE DATE 3/30/01

APPROVAL DATE 5/8/01

INDEXED

Egle's Septic Clean, Inc. IS PERMITTED TO INSTALL  ALTER

ADDRESS 580 Obrecht Rd., Sykesville, MD 21784 PHONE (410) 795-5670

SUBDIVISION Farside LOT NUMBER 63 ADDRESS 11723 Fox Spur Court

PROPERTY OWNER Jason Soubier PROPERTY OWNER'S ADDRESS 9509 Oakhurst Dr. Columbia, MD 21046

SEPTIC TANK CAPACITY 1250 GALLONS (Top seam)

PUMP CHAMBER CAPACITY NA GALLONS

NUMBER OF BEDROOMS 4

SQUARE FEET PER BEDROOM 180

LINEAR FEET OF TRENCH REQUIRED 240

TRENCHES: Trenches to be 3 feet wide. Inlet 2 feet below original grade. Bottom maximum depth 4 feet below original grade. 2 feet of stone below distribution box. pipe

LOCATION: Set the distribution box 340 ft. down the right (633.05 ft) down the right lot line and 90' off the same lot line. Run trenches on contour towards the right lot line.

LAYOUT INSP. REQUIRED - ADJUSTMENTS EXPECTED  
WITH PIPE TO D. BOX FROM SEPTIC TANK

PLANS APPROVED Steven R. Krieg / Mark Rifkin ON SRU DATE 11/8/00

PERMIT VOID AFTER 2 YEARS 3/30/01


- NOTE: CONTRACTOR RESPONSIBLE FOR SCHEDULING A PRE-CONSTRUCTION INSPECTION FOR ALL INSTALLATIONS
- NOTE: TOP OF SEPTIC TANKS ARE TO BE NO DEEPER THAN 3.0 FEET BELOW FINISH GRADE
- NOTE: WATERTIGHT SEPTIC TANKS REQUIRED
- NOTE: CLEANOUT REQUIRED EVERY 70 FEET OF SEWER LINE AND/OR AT 90° SWEEPS IN LINES FROM HOUSE TO DRAIN FIELDS, 90° ELBOWS ARE NOT ACCEPTABLE
- NOTE: ALL PARTS OF SEPTIC SYSTEMS (I.E. TANK, DISTRIBUTION BOX, DRAINFIELDS) TO BE 100 FEET FROM ANY WATER WELL UNLESS OTHERWISE SPECIFICALLY AUTHORIZED
- NOTE: NO ABSORPTION TRENCH TO EXCEED 100 FEET IN LENGTH UNLESS SPECIFICALLY AUTHORIZED
- NOTE: ALL PIPE FROM HOUSE TO SEPTIC TANK MUST BE CAST IRON OR SCHEDULE 35/40 PVC OR ABS
- NOTE: MANHOLE RISERS REQUIRED ON ALL SEPTIC TANKS AND PUMP CHAMBERS
- NOTE: DISTRIBUTION BOXES MUST HAVE BAFFLES
- NOTE: IF PUMPED SEPTIC SYSTEM REQUIRED, (1) SEPTIC PUMP DETAIL TO BE PROVIDED BY INSTALLER PRIOR TO ISSUANCE OF SEPTIC PERMIT (2) PUMP PERFORMANCE TEST IS NECESSARY PRIOR TO HEALTH DEPARTMENT APPROVAL OF SEPTIC PERMIT

NO RETURNED 6/27/01  
B00130791 Propane tank

NEITHER THE HOWARD COUNTY COUNCIL NOR THE HEALTH DEPARTMENT IS RESPONSIBLE FOR THE SUCCESSFUL OPERATION OF ANY SYSTEM  
PERMITTEE RESPONSIBLE FOR OBTAINING FINAL APPROVAL ON THIS PERMIT  
CALL 410-313-2640 FOR INSPECTION OF SEPTIC SYSTEM

514995

NOT TO SCALE

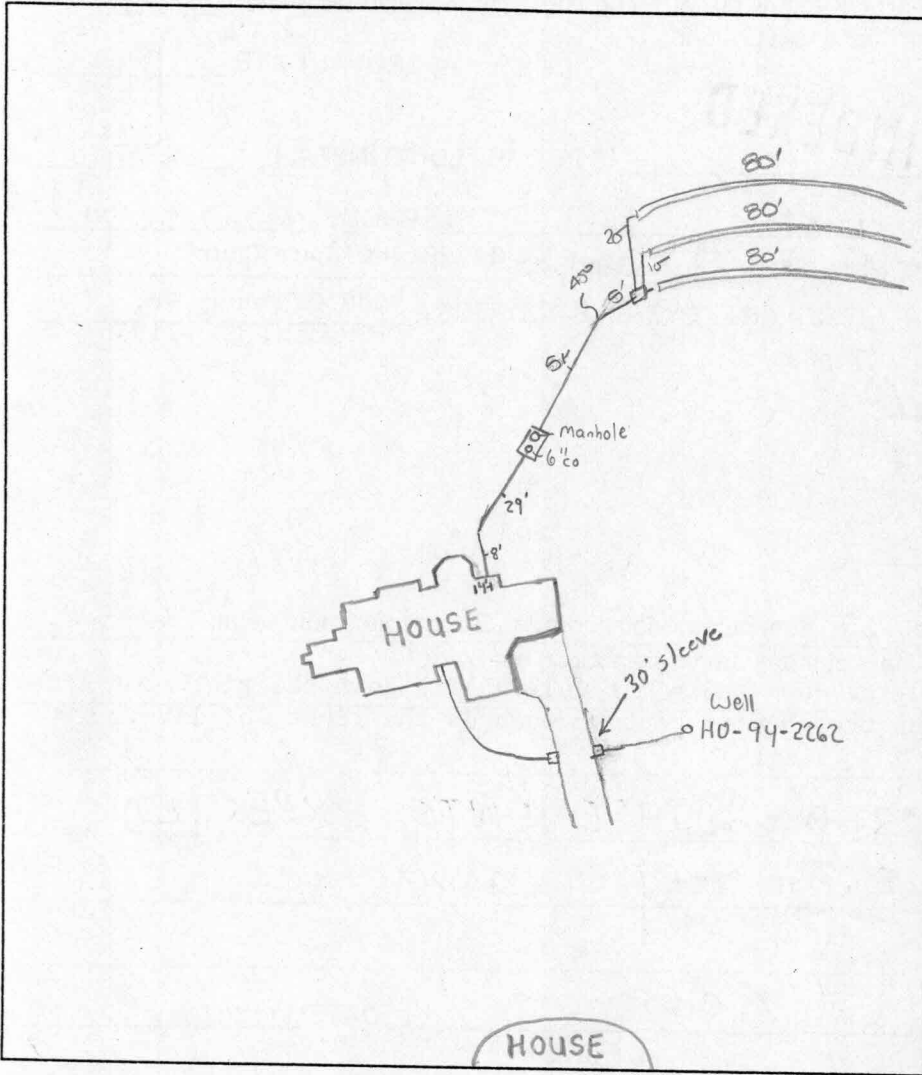

**TRENCH DATA**

TRENCH WIDTH 3  
 TRENCH INLET DEPTH 2  
 TRENCH BOTTOM DEPTH 4  
 DEPTH OF STONE 2  
 NUMBER OF TRENCHES 3  
 TOTAL TRENCH LENGTH 240  
 ABSORBENT AREA 720  
 DISTRIBUTION BOX LEVEL   
 BAFFLE IN DISTRIBUTION BOX

**SEPTIC TANK DATA**

SEPTIC TANK 1250 TS GALLONS  
 MANHOLE RISER on center  
 6 INCH INSPECTION PORT on front

**PUMP CHAMBER DATA**

PUMP CHAMBER GALLONS NA  
 MANHOLE RISER NA  
 ALARM NA  
 PUMP PERFORMANCE TEST NA

PRE-CONSTRUCTION INSPECTION: 5/4/01 - SEPTIC PIPING - (HOUSE SEWER) ADJUSTED SLIGHTLY AND FARTHER AWAY TO HELP ACCOMMODATE FOR FUTURE GRADING, FUTURE POOL LOCATION / TENNIS COURT & ASSOCIATED GRADING WILL HAVE TO BE ADJUSTED OVER TOWARDS THE 606.02 LOT LINE  
 INSPECTION COMMENTS: AS STATED ON THE APPROVED PERC CERT / BP PLAN, INSTALL TRENCHES TOWARDS THE D BOX SLIGHTLY OUT OF SDA AND RUN 3 TRENCHES ON CONTOUR (SR)

5/8/01 A.M. - OK to continue. DCC

5/8/01 P.M. FINAL INSP - OK to cover all septic work. DCC

INSPECTOR

T. A. K. K. K.

DATE SYSTEM APPROVED

5/8/01