

Fill out in triplicate.
File but checked blanks.
Make fee of \$15.00 payable to:

APPLICATION

A 05095

SEWAGE DISPOSAL TESTING

P _____

MARYLAND STATE DEPARTMENT OF HEALTH

HOWARD COUNTY

ELLCOTT CITY

DISTRICT 3

DATE 5/4/62

*Drain well 10 ft in dia. by 10 1/2 ft
deep below the inlet located 17 ft
from the front property line and 95 ft from
the right side property line. Right side
property line determined when lot was
RT 144. 750 gal depth tank*

TO: THE COUNTY HEALTH OFFICER
ELLCOTT CITY, MARYLAND

I, HENEBY, APPLY FOR THE NECESSARY TESTS IN ORDER TO CONSTRUCT (OR RECONSTRUCT) A SEWAGE DISPOSAL SYSTEM.

PROPERTY OWNER

J. Donald Hoffman

ADDRESS

West Friendship rd.

PHONE

HUNTLEY 9-4919

PROPERTY LOCATION:

SUBDIVISION

LOT NO.

ROAD AND DESCRIPTION

Rt. 144 - 3/4 mile east of Rt. 32

OCCUPANT

PHONE

PERSON TO CONSTRUCT SYSTEM

ADDRESS

PHONE

SIZE OF LOT

1 1/2 acres

TYPE BLDG.

NUMBER OF PERSONS

IF NOT SINGLE RESIDENCE DESCRIBE

SIGNATURE OF APPLICANT

J. Donald Hoffman

APPROVED BY

James Henigan

FOR

(KIND OF SYSTEM)

DATE

5-11-62

REJECTED BY

FOR

(KIND OF SYSTEM)


DATE

HOLD PENDING FURTHER TESTS

DATE

REASONS FOR REJECTION OR HOLDING

THIS IS NOT A PERMIT

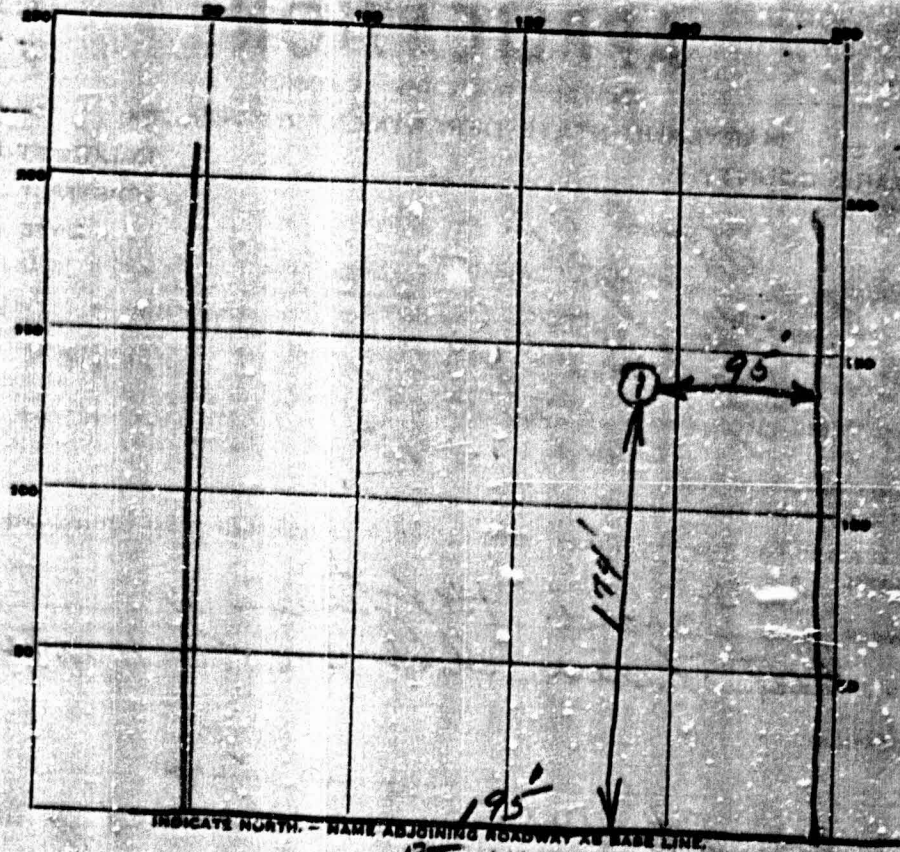

INDICATE NORTH - NAME ADJOINING ROADWAY AS BASE LINE.
RT 144

DATE	TEST NO.	DEPTH	PRE-WET		TEST - 1" DROP		TIME
			START	STOP	START	STOP	
5-11-62	1	9	1:57	1:03	1:03	1:13	10 Min.

SOIL AUGER FINDING Test 1 p 1 q 0 00

TESTED BY James Hennigan

REMARKS

ALSO PRESENT 5-11-62 Carl J. Williams LOT NO. 1/2 acre