

8-8-62

PERMIT

P 0555C
A 05095

SEWAGE DISPOSAL SYSTEM

MARYLAND STATE DEPARTMENT OF HEALTH

HOWARD COUNTY

ELLICOTT CITY

DISTRICT 3

DATE 7/31/62

INDEXED

INDEXED

Carl Williams

IS PERMITTED TO INSTALL ALTER

ADDRESS _____ PHONE _____

A SEWAGE DISPOSAL SYSTEM LOCATED AT Rt 144 - 3/4 of a mile east

of Rt 32

SUBDIVISION _____ ROAD _____ LOT _____

PROPERTY OWNER J. Donald Hoffman

ADDRESS _____

SPECIFICATIONS

DRAIN FIELD _____ DEPTH _____ FEET, BOTTOM AREA _____ SQ. FT.

SEEPAGE PITS 1 ABSORBENT SIDE-WALL AREA 10' x 10' SQ. FT. below the inlet

SEPTIC TANK CAPACITY 750 GALLONS

FOR GARBAGE GRINDER, INCREASE DISPOSAL AREA 25% & TANK CAPACITY 50%


OTHER locate the dry well 174 feet from the front
property property line and 45 feet from the right
side property line. Right side property line
determined when facing lot from Rt 144

PLANS APPROVED BY J. Heenan DATE 5/11/62

FILL SEPTIC TANK AND DISTRIBUTION BOX WITH WATER BEFORE CALLING FOR AN INSPECTION. COVER NO WORK UNTIL INSPECTED AND APPROVED.

NEITHER THE HOWARD COUNTY COMMISSIONERS NOR THE HEALTH DEPARTMENT IS RESPONSIBLE FOR THE SUCCESSFUL OPERATION OF ANY SYSTEM.

APPROVED

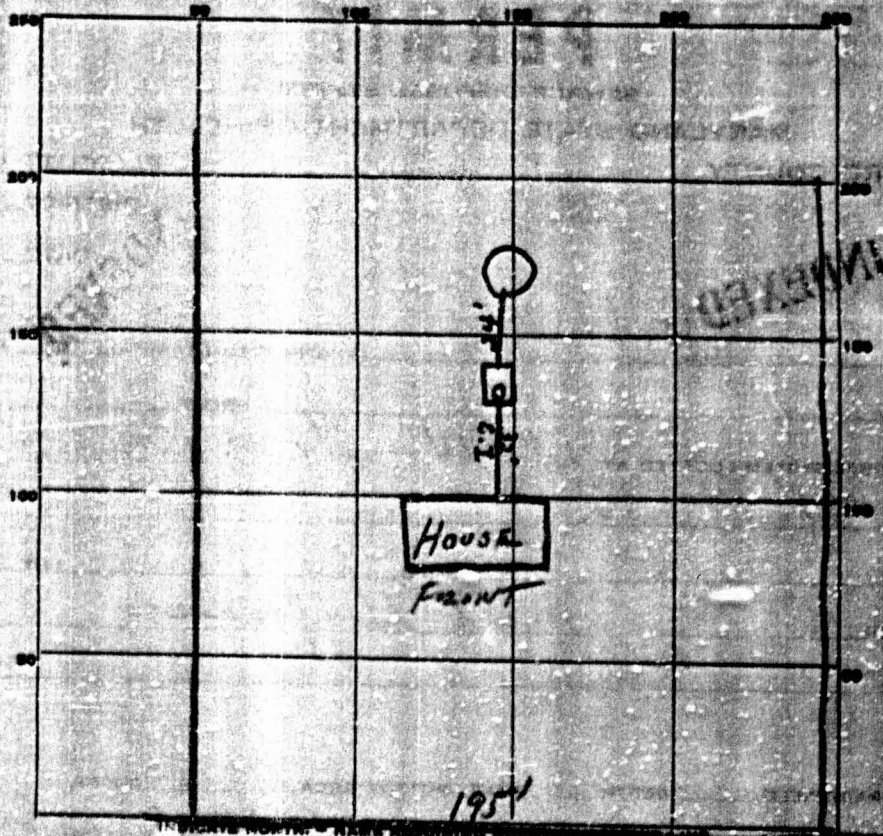

PERMIT CARD gja
 SEPTIC TANK, LEVEL concrete 75 gal. CLEANOUTS 6" stand pipe
 DISTRIBUTION BOX, LEVEL None
 TILE FIELD, DEPTH _____ FT. TRENCH WIDTH _____ FT.
 GRAVEL DEPTH _____ IN. TOTAL LENGTH _____ FT.
 NUMBER OF TRENCHES _____ TOTAL BOTTOM AREA _____
 SEEPAGE PITS, INSIDE DIAMETER 10 FT. DEPTH BELOW INLET 10 1/2 FT.
 ABSORBENT AREA OK SQ. FT.

REMARKS _____

DATE SYSTEM APPROVED 8-8-62 INSPECTOR J. Hennigan