


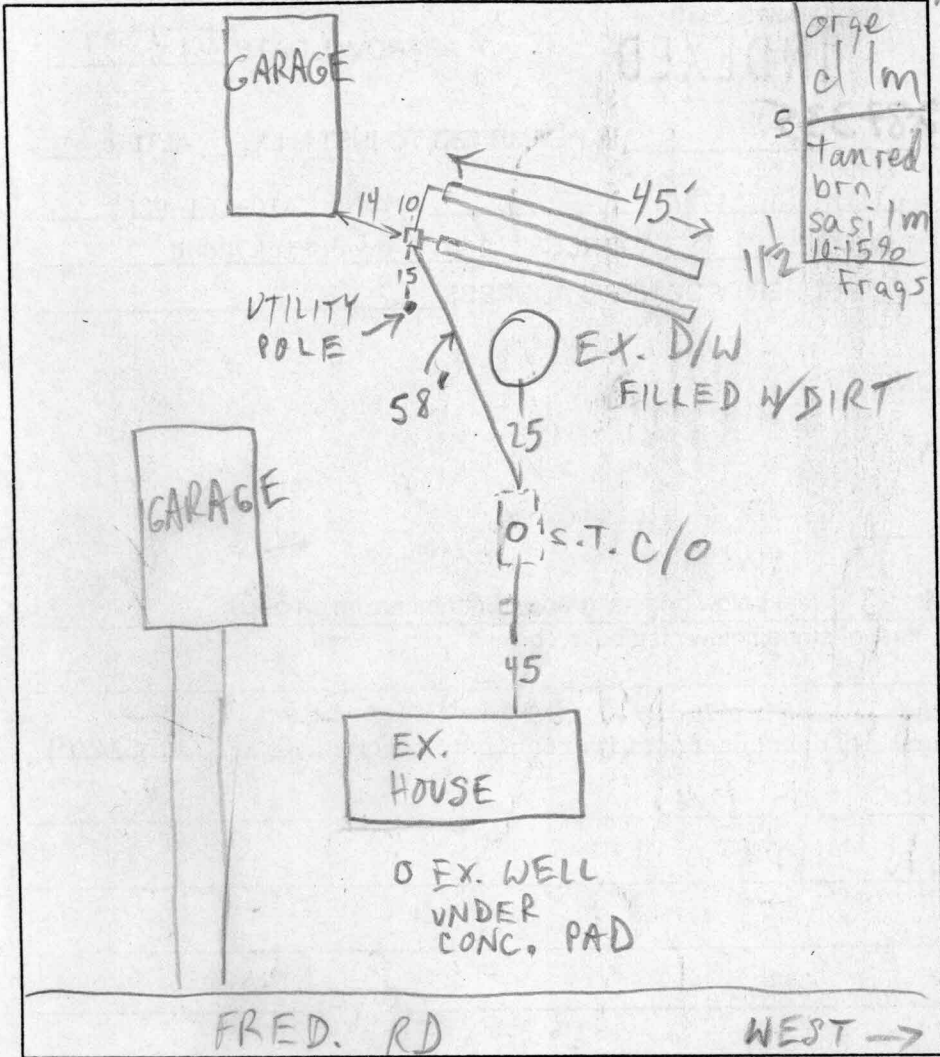

NOT TO SCALE

TRENCH VICINITY



TRENCH DATA	
TRENCH WIDTH	<u>2</u>
TRENCH INLET DEPTH	<u>3</u>
TRENCH BOTTOM DEPTH	<u>10</u>
DEPTH OF STONE	<u>7</u>
NUMBER OF TRENCHES	<u>2</u>
TOTAL TRENCH LENGTH	<u>90</u>
ABSORBENT AREA	<u>630</u>
DISTRIBUTION BOX LEVEL	<input checked="" type="checkbox"/>
BAFFLE IN DISTRIBUTION BOX	<input checked="" type="checkbox"/>

SEPTIC TANK DATA	
SEPTIC TANK	<u>EX. 750</u> GALLONS
MANHOLE RISER	_____
6 INCH INSPECTION PORT	<input checked="" type="checkbox"/>
PUMP CHAMBER DATA	
PUMP CHAMBER GALLONS	_____
MANHOLE RISER	_____
ALARM	_____
PUMP PERFORMANCE TEST	_____

PRE-CONSTRUCTION INSPECTION: 5/7/01 10:00 OK TO START (MR)

INSPECTION COMMENTS: 5/7/01 12:30 OK TO CONTINUE (MR)  
5/7/01 OK TO COVER (MR)

INSPECTOR M. Ripkin DATE SYSTEM APPROVED 5/7/01