


10/18/01

Proposed garage O.K.  
Perc Testing done on lot behind  
this parcel indicated good soils.  
(BB)

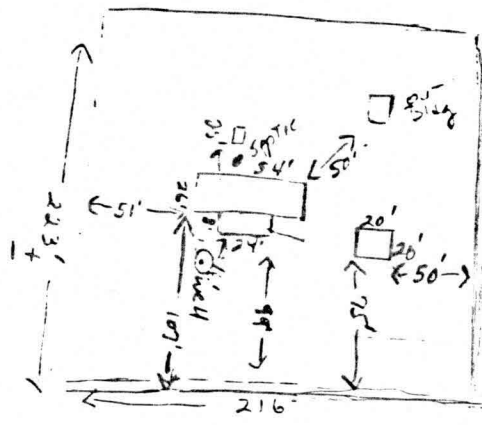

Frederick Rd

MATHIS

1/2" = 50'

**HOWARD COUNTY  
PERMIT APPLICATION**

PERMIT NUMBER

300132882 4

Building Address 12420 Frederick Road  
West Friendship Md 21794  
Suite/Apt. #: \_\_\_\_\_ SDP/WP/Petition #: \_\_\_\_\_  
Census Tract 6030 Subdivision \_\_\_\_\_  
Section \_\_\_\_\_ Area \_\_\_\_\_ Lot \_\_\_\_\_  
Tax Map 15 Parcel 141 Grid 12  
Zoning RR Map Coordinates 10E3 Lot size \_\_\_\_\_

Property Owner's Name Ellen Mathis  
Address 12420 Frederick Rd  
City West Friendship State Md Zip Code 21794  
Home Phone 410 489-4348 Work Phone \_\_\_\_\_  
Applicant's Name & Mailing Address, (if other than stated hereon):  
Shirley Richardson  
4750 Ten Oaks Rd  
Dayton Md 21036  
Phone 410-489-7035 Fax 410-531-6085

Existing Use SID  
Proposed Use SID GARAGE  
Estimated Construction Cost \$ 11,000.00  
Description of Work Block foundation Framed walls  
Single roof vinyl siding 40' finished interior  
20 x 20 Garage

Contractor Company SIG CONTRACTORS  
Contact Person Shirley Richardson  
Address 4750 Ten Oaks Rd  
City Dayton State Md Zip Code 21036  
License No. 43679  
Phone 410 489 7035 Fax 410-531-6085

Occupant or Tenant Ellen Mathis  
Contact Name same  
Address 12420 Frederick Rd  
City West Friendship State Md Zip Code 21794  
Phone 410-489-4348 Fax \_\_\_\_\_

Engineer or Architect Company \_\_\_\_\_  
Contact Person \_\_\_\_\_  
Address \_\_\_\_\_  
City \_\_\_\_\_ State \_\_\_\_\_ Zip Code \_\_\_\_\_  
Phone \_\_\_\_\_ Fax \_\_\_\_\_

**BUILDING DESCRIPTION - COMMERCIAL**

**BUILDING DESCRIPTION - RESIDENTIAL**

**Building Characteristics**  
Height: \_\_\_\_\_  
No. of stories: \_\_\_\_\_  
Gross area, sq. ft. per floor: \_\_\_\_\_  
Use group: \_\_\_\_\_  
Construction type:  
 Reinforced Concrete  
 Structural Steel  
 Masonry  
 Wood Frame  
 State Certified Modular

**Utilities**  
Water Supply:  
 Public  
 Private  
Sewage Disposal:  
 Public  
 Private  
Electric Yes  No   
Gas Yes  No   
Heating System:  
Electric  Oil   
Natural Gas   
Propane Gas   
Sprinkler system: N/A   
 Full  
 Partial  
 Other Suppression  
# of Heads \_\_\_\_\_

**Building Characteristics**  
SF Dwelling  SF Townhouse   
1st floor: Depth Width  
2nd floor: \_\_\_\_\_  
Basement:  
Finished Basement  Unfinished Basement   
Crawl space  Slab on Grade   
No. of Bedrooms \_\_\_\_\_  
Multi-family dwellings:  
No. of efficiency units: \_\_\_\_\_  
No. of 1 BR units: \_\_\_\_\_  
No. of 2 BR units: \_\_\_\_\_  
No. of 3 BR units: \_\_\_\_\_  
Other Structure: GARAGE  
Dimensions: 20' x 20'  
Footings: 24" x 9"  
Roof: Shingles  
 State Certified Modular  
 Manufactured Home

**Utilities**  
Water Supply:  
 Public  
 Private  
Sewage Disposal:  
 Public  
 Private  
Electric Yes  No   
Gas Yes  No   
Heating System:  
Electric  Oil   
Natural Gas   
Propane Gas   
Sprinkler system: N/A   
 NFPA #13D  
 NFPA #13R  
 Other:

UNDERSIGNED HEREBY CERTIFIES AND AGREES AS FOLLOWS: (1) THAT HE/SHE IS AUTHORIZED TO MAKE THIS APPLICATION; (2) THAT THE INFORMATION IS CORRECT; (3) THAT HE/SHE WILL COMPLY WITH ALL REGULATIONS OF HOWARD COUNTY WHICH ARE APPLICABLE THERETO; (4) THAT HE/SHE WILL PERFORM NO WORK ON THE ABOVE REFERENCED PROPERTY NOT SPECIFICALLY DESCRIBED IN THIS APPLICATION; (5) THAT HE/SHE GRANTS COUNTY OFFICIALS THE RIGHT TO ENTER ONTO THE PROPERTY FOR THE PURPOSE OF INSPECTING THE WORK PERMITTED AND POSTING NOTICES.

Applicant's Signature Shirley D. Richardson  
Signature of Contractor SIG Contractors  
Company \_\_\_\_\_


Print Name Shirley D. Richardson  
Date 10-18-01

Checks payable to: **DIRECTOR OF FINANCE OF HOWARD COUNTY**  
\*\* PLEASE WRITE NEATLY AND LEGIBLY. \*\*  
- FOR OFFICE USE ONLY -

AGENCY \_\_\_\_\_ DATE 10/18/01 SIGNATURE APPROVAL Brian Baker  
Development, DPZ  
Highways  
Planning Official  
Engineering, DPZ  
Health  
Protection  
Sediment Control approval required prior to issuance?  
YES  NO   
CONTINGENCY CONSTRUCTION START:   
ONE STOP SHOP:

DPZ SETBACK INFORMATION  
Front: \_\_\_\_\_  
Rear: \_\_\_\_\_  
Side: \_\_\_\_\_  
Side St.: \_\_\_\_\_  
All minimum setbacks met?  
YES  NO   
Is Entrance Permit required?  
YES  NO   
Historic District?  
YES  NO   
Lot Coverage for NewTown Zone \_\_\_\_\_  
SDP/Red-line approval date \_\_\_\_\_ Accepted by \_\_\_\_\_

PROPERTY ID#: 73961  
Filing fee \$ 25  
Permit fee \$ 72  
Excise tax \$ \_\_\_\_\_  
Sub-total paid \$ \_\_\_\_\_  
Add'l permit fee \$ \_\_\_\_\_  
TOTAL FEES \$ 97  
Balance due \$ \_\_\_\_\_  
Check # 7396  
Validation # 412174

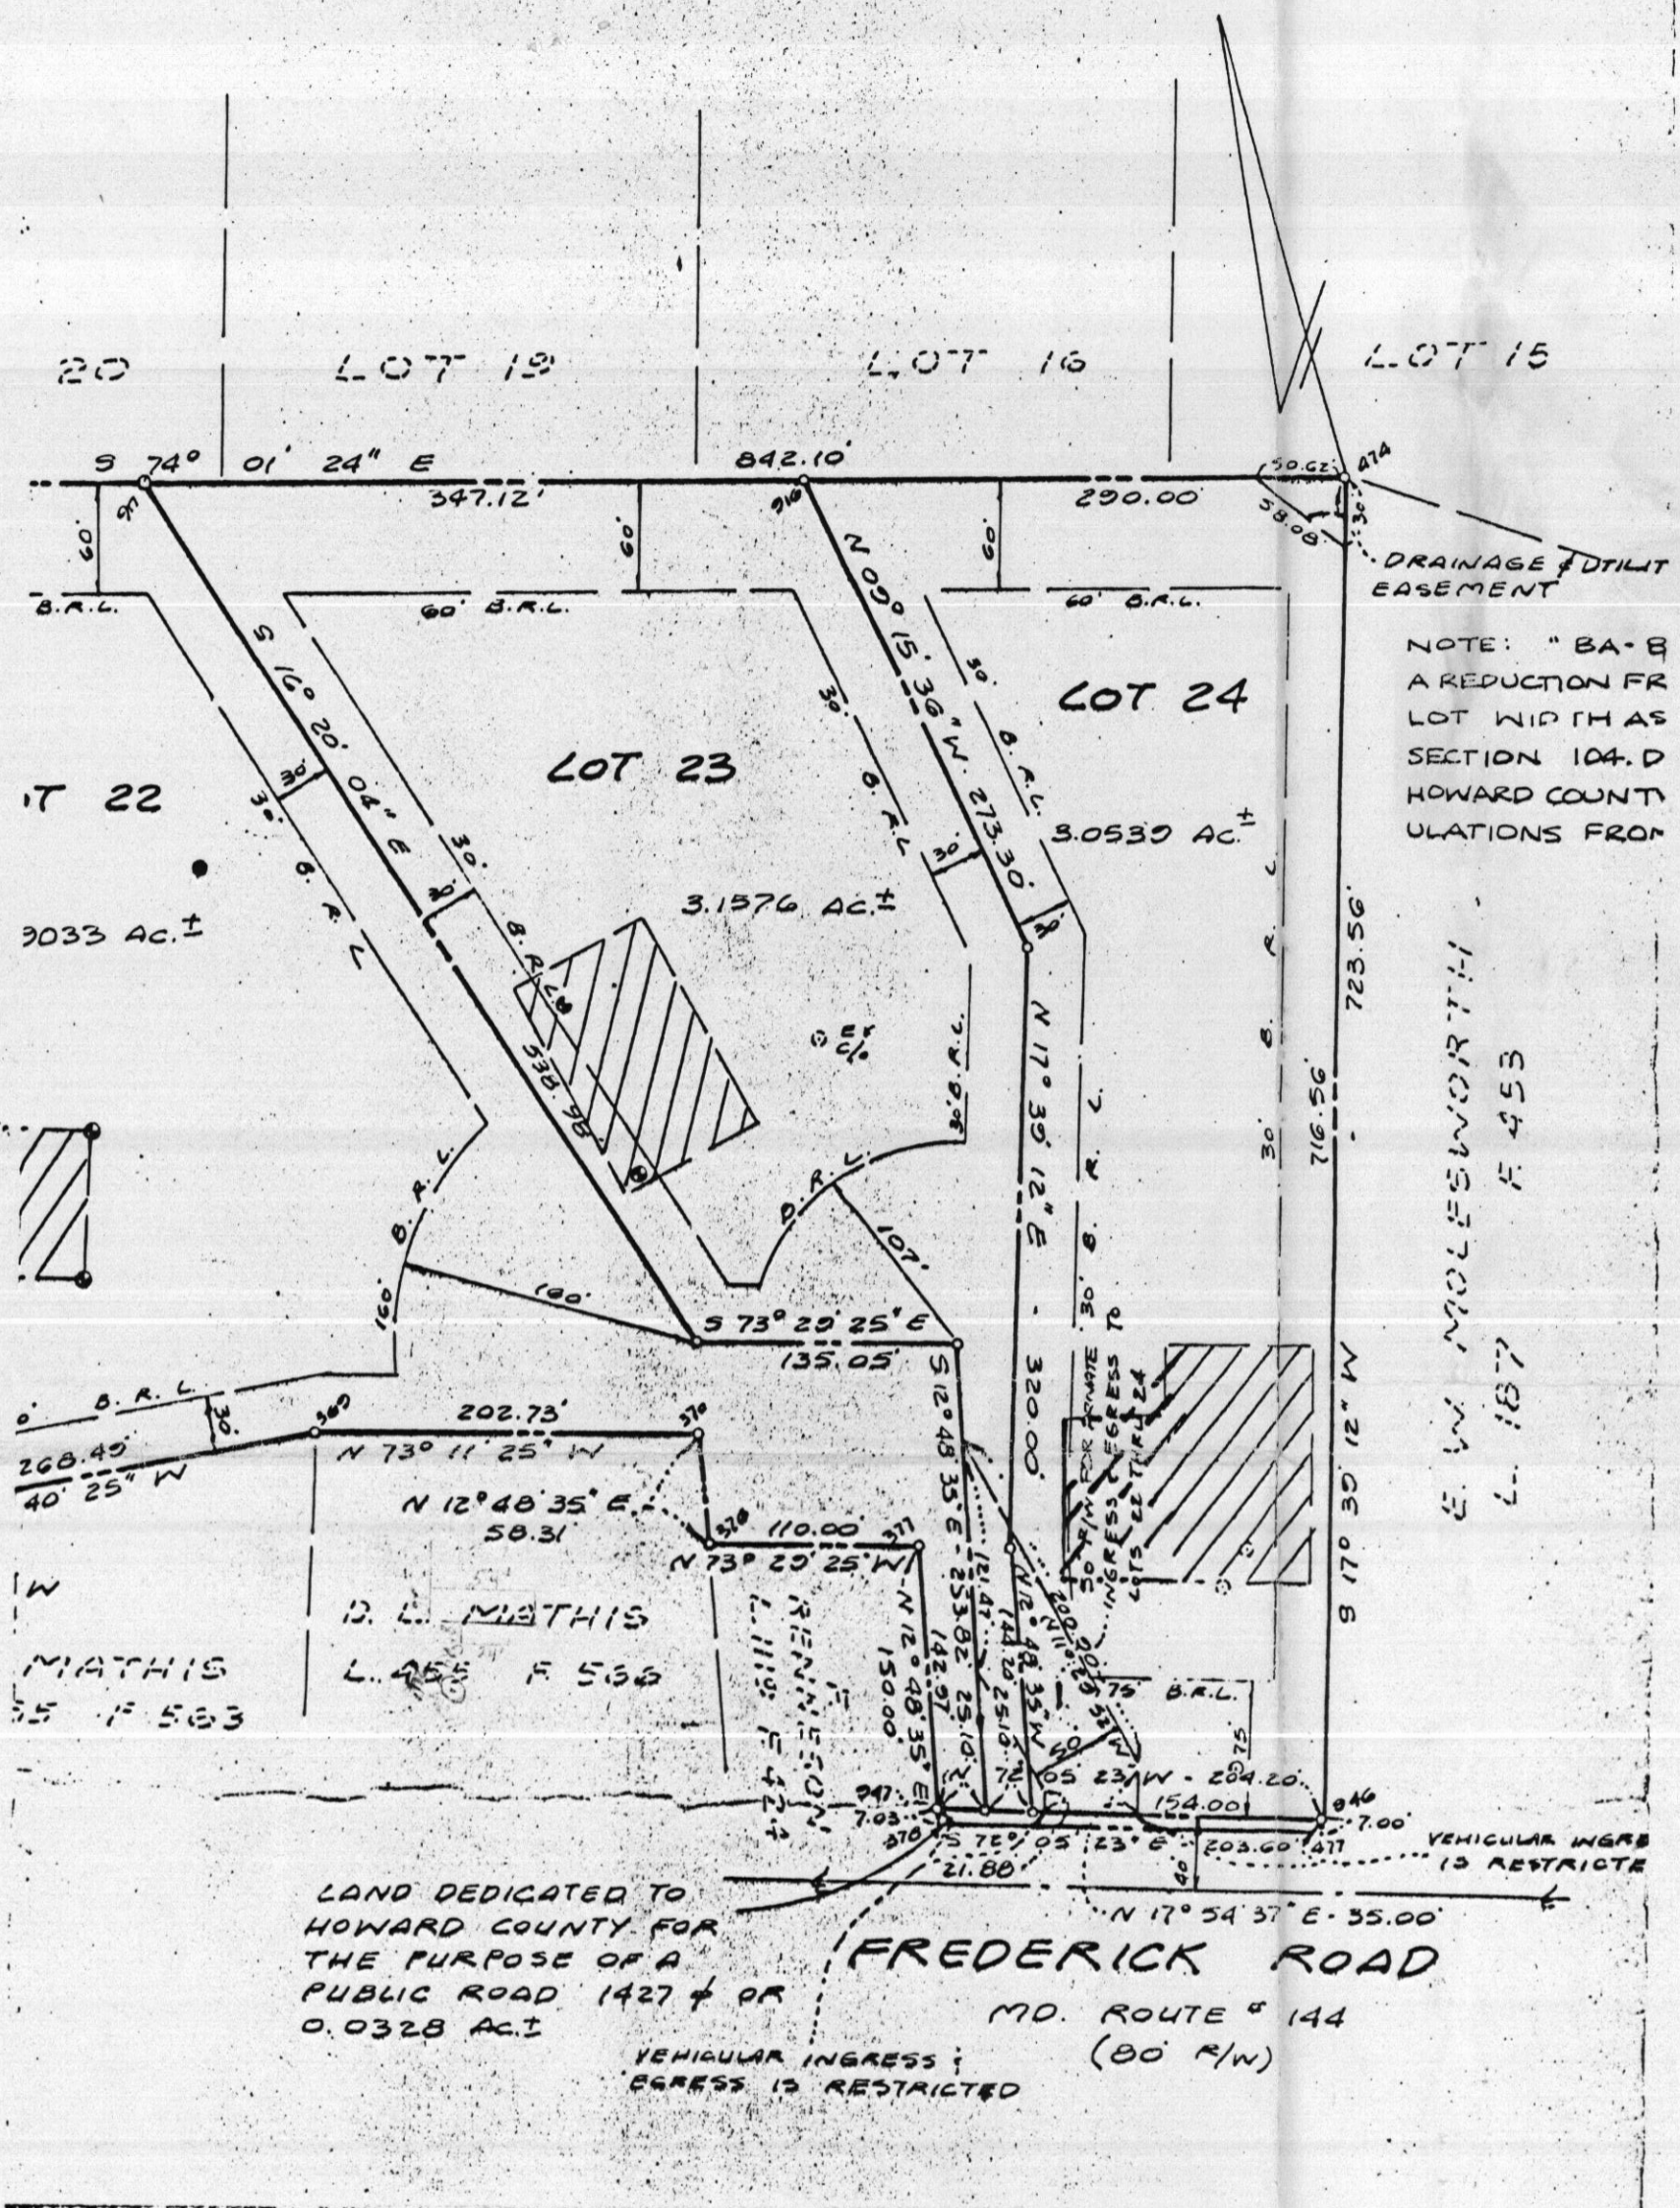

NOTE: "BA-B  
 A REDUCTION FR  
 LOT WIDTH AS  
 SECTION 104. D  
 HOWARD COUNTY  
 REGULATIONS FROM

E. W. MOLESWORTH  
 L. 1877 F 453



W  
 MATHIS  
 L. 455 F 563

D. L. MATHIS  
 L. 455 F 566

RENNISON  
 L. 1195 F 424

LAND DEDICATED TO  
 HOWARD COUNTY FOR  
 THE PURPOSE OF A  
 PUBLIC ROAD 1427 ± OR  
 0.0328 AC.±

**FREDERICK ROAD**

MD. ROUTE 144  
 (80' R/W)

VEHICULAR INGRESS;  
 EGRESS IS RESTRICTED

TO: E. W. MOLESWORTH  
 DEPT. OF PUBLIC WORKS  
 HOWARD COUNTY  
 RECEIVED

# PERMIT APPLICATION

DEPARTMENT OF INSPECTIONS, LICENSES & PERMIT  
3430 COURT HOUSE DRIVE, ELLICOTT CITY, MARYLAND 21043

54805

**BUILDING ADDRESS (HOUSE NO., STREET, TOWN OR AREA)**  
 12420 Frederick Rd.  
 West Friendship, Md 21794

LOT NO.	PARCEL NO.	SEC.	AREA	BLOCK NO.	LIBER	FOLIO
12	149	N/A	N/A	12	455	566
SUB DIVISION		ZONE	ZONE MAP	ELEC. DIST.	CENSUS TR.	
N/A		RR	15	3	6030	

GRADING/SEDIMENT CONTROL  YES  NO SDP #

**DESCRIPTION OF WORK AUTHORIZED**  
 To construct a porch 8' x 24'  
 with a concrete slab, framed  
 Porch to be open (no screening)

**OWNER NAME AND ADDRESS**  
 Daniel Mathis, Sr.  
 12420 Frederick Rd  
 West Friendship Md 21794

**PHONE NO.** 410-489-4348

SIZE OF BLDG.	FRONT	DEPTH	HEIGHT

**OCCUPANT'S NAME AND ADDRESS**  
 SAME

**PHONE NO.**

TYPE OF BLDG.	AREA	VOLUME	ROOF
B. ROOMS			
ROOMS			
BATHS			
FIREPLACES			

**ARCHITECT OR ENGINEER'S NAME AND ADDRESS**

**PHONE NO.**

FOOTINGS	FOUNDATION	S. WALLS
8' x 24"	block	

**CONTRACTOR'S NAME AND ADDRESS**  
 Blue Ribbon Const Co Inc  
 4750 Ten Oaks Rd  
 Dayton Md 21036-1125

**PHONE NO.** 410-531-5260

UTILITIES					
WATER/WELL	SEWER/SEPTIC	GAS	ELECTRICITY	TYPE OF HEAT	AC

EXISTING USE	PROPOSED USE
Single Family Dwelling	Porch

I have carefully examined and read this application and know the same is true and correct, and that is doing this work, all provisions of Howard County Ordinances and the State Laws of Maryland will be complied with, whether specified or not; and I will notify the Department of Inspections, and Permits twenty-four hours in advance when I am ready for the inspections called for elsewhere in the application; and that no work will be covered up until such inspections have been completed with.

EST. CONSTRUCTION COST	LICENSE NUMBER	PERMIT FEE
\$11500.00	643010	

SIGNATURE \_\_\_\_\_

N/S CODE \_\_\_\_\_

TITLE \_\_\_\_\_ DATE \_\_\_\_\_

### FOR OFFICE USE ONLY

DISTRICT IN FEET FROM R/W LINE TO FRONT BUILDING LINE \_\_\_\_\_

SIDE YARD \_\_\_\_\_  
 (DISTANCE IN FEET FROM SIDE BLDG. LINE TO SIDE PROPERTY LINE)

TO SIDE BUILDING LINE \_\_\_\_\_  
 DISTANCE IN FEET, REAR YD. REQUIRING SET

BACK \_\_\_\_\_ (CORNER LOT ONLY)

SDP # \_\_\_\_\_

Check payable to: DIRECTOR OF FINANCE OF HOWARD COUNTY

FUNCTION	DATE	SIGNATURE APPROVAL
ZONING/PLANNING		
SHA		
SEDIMENT/GRADING		
BUILDING OFFICIAL		
WATER & SEWER		
HEALTH DEPT.	6/20/94	A. McMiller
FIRE PROTECTION		
STORM WATER MGM.		

**CAUTION**

To begin construction before a permit placard has been issued and displayed on the job is a violation of the law.  
 Use and occupancy permit must be applied for 10 days before it will be issued.

**IMPORTANT: PLEASE SHOW ZIP CODES AND AREA CODES WHEREVER REQUIRED.**


APPROVED \_\_\_\_\_ DATE \_\_\_\_\_

2-69-591

**Distribution of Copies:**  
 White - Building Official  
 Green - Planning & Zoning

**Yellow - Engineering  
 Pink - Health Dept  
 Gold - S.H.A**

6/20/94  
 Proposed porch location will have no impact to existing well or septic. OK to proceed.

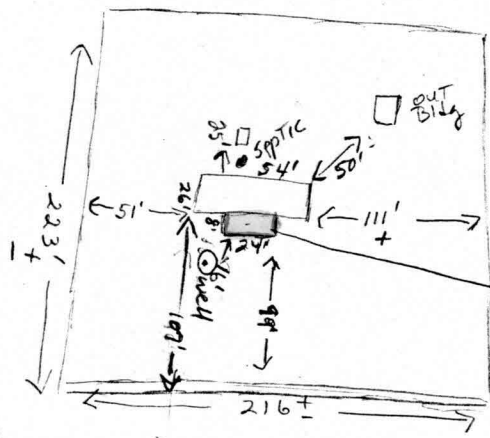

→ proposed porch  
 8' x 24'

Frederick Rd.

Diagram drawn accurately depicts actual location of existing well and septic  
 Amy McMullen

RECEIVED  
 HOWARD COUNTY  
 HEALTH DEPT.  
 94 JUN 16 AM 9:07

1/2" = 50'