

6/13/01
+5 AP
6/14/01
2-00

04-364694

INDEXED PERMIT

ISSUE DATE: 6/1/2001

P 515274-A

APPROVAL DATE: 6/14/01

A 511463-A

ON-SITE SEWAGE DISPOSAL SYSTEM HOWARD COUNTY HEALTH DEPARTMENT BUREAU OF ENVIRONMENTAL HEALTH

Jack Fyock Septic Service IS PERMITTED TO INSTALL ALTER

ADDRESS: P.O. Box 89, Glenelg, MD 21737 PHONE NUMBER: 410-531-2939

SUBDIVISION: Avery Property LOT NUMBER: 1

ADDRESS: 14371 Frederick Road PROPERTY OWNER: Cornerstone Homes

SEPTIC TANK CAPACITY (GALLONS): 1250 (Top Seamed)

PUMP CHAMBER CAPACITY (GALLONS): N/A

NUMBER OF BEDROOMS: 4

SQUARE FEET PER BEDROOM: 240

LINEAR FEET OF TRENCH REQUIRED: 320 Trenches to be 6' apart.

TRENCHES:	Trench to be 2.0 feet wide. Inlet 3.0 feet below original grade. Bottom maximum depth 6.0 feet below original grade. Effective area begins at 3.0 feet below original grade. 3.0 feet of stone below distribution pipe.
LOCATION:	Place the distribution box 70 feet off the front property line and 80 feet off the left (142.82') lot line as viewed from Frederick Road. Run trenches on contour in both directions from the distribution box. as shown on plan
NOTES:	Pre-construction stake out inspection and open trench inspections required. Call to schedule with Health Department inspector prior to septic system construction in order to maximize efficiency of the limited sewage disposal area.

PLANS APPROVED: Amy Mc Millen 4/13/01 OK BB DATE: 4-6-01


- NOTE: PERMIT VOID AFTER 2 YEARS
- NOTE: CONTRACTOR RESPONSIBLE FOR SCHEDULING A PRE-CONSTRUCTION INSPECTION FOR ALL INSTALLATIONS
- NOTE: WATERTIGHT SEPTIC TANKS REQUIRED
- NOTE: ALL PARTS OF SEPTIC SYSTEM SHALL BE 100 FEET FROM ANY WATER WELL
- NOTE: MANHOLE RISERS REQUIRED ON ALL SEPTIC TANKS AND PUMP CHAMBERS

NEITHER THE HOWARD COUNTY COUNCIL NOR THE HEALTH DEPARTMENT IS RESPONSIBLE FOR THE SUCCESSFUL OPERATION OF ANY SYSTEM PERMITTEE RESPONSIBLE FOR OBTAINING FINAL APPROVAL ON THIS PERMIT CALL 410-313-2640 FOR INSPECTION OF SEPTIC SYSTEM

P515274-A

INDEXED

NOT TO SCALE

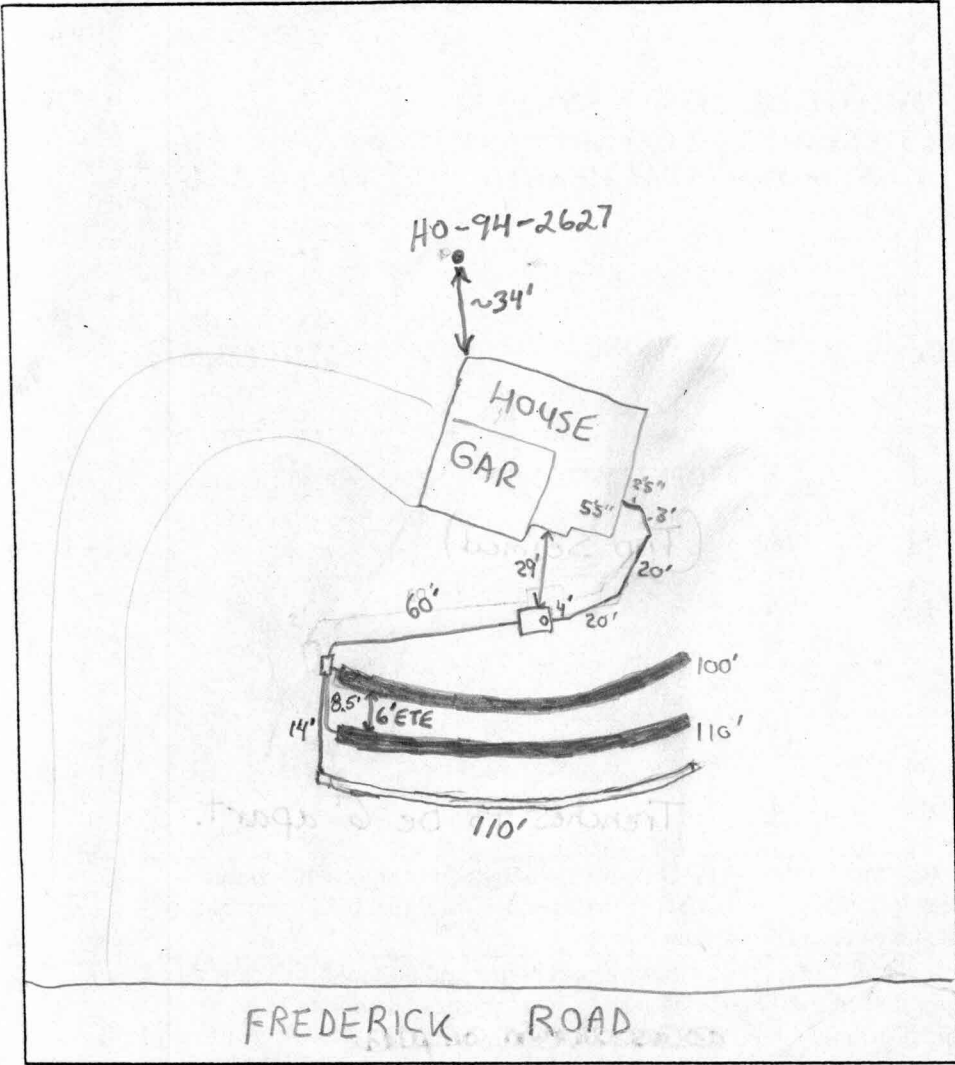

TRENCH DATA

TRENCH WIDTH 2.0'
 TRENCH INLET DEPTH 3.0'
 TRENCH BOTTOM DEPTH 6.0'
 DEPTH OF STONE 3.0'
 NUMBER OF TRENCHES 3
 TOTAL TRENCH LENGTH 320'
 ABSORBENT AREA 960 sq. ft.
 DISTRIBUTION BOX LEVEL Yes
 BAFFLE IN DISTRIBUTION BOX Yes

SEPTIC TANK DATA

SEPTIC TANK 1250 TS GALLONS
 MANHOLE RISER No
 6 INCH INSPECTION PORT on front

PUMP CHAMBER DATA

PUMP CHAMBER GALLONS NA
 MANHOLE RISER NA
 ALARM NA
 PUMP PERFORMANCE TEST NA

PRE-CONSTRUCTION INSPECTION: 6/8/01 Easement not staked. Nud wall check. (BB)

INSPECTION COMMENTS: 6/19/01- OK TO CONTINUE WORK, OPEN TRENCH INSP. OK, (SRK)

6/13/01- OK TO CONTINUE WORK, PUT MANHOLE ACCESS ON SEPTIC TANK, AND FINISH 3RD TRENCH (SRK)

6/14/01 Everything satisfactory. O.K. to cover. (BB)

INSPECTOR B. Baker

DATE SYSTEM APPROVED 6/14/01