

11 a.m. Layout

8/20/01 - Still Needs Stakeout of trenches before go ahead on construction. JPP

ISSUE DATE: 7/26/2001

APPROVAL DATE: 8/21/01

# PERMIT INDEXED

P 515960

A 22850

## ON-SITE SEWAGE DISPOSAL SYSTEM HOWARD COUNTY HEALTH DEPARTMENT BUREAU OF ENVIRONMENTAL HEALTH

**04-334973**

South Carroll Backhoe, Inc IS PERMITTED TO INSTALL  ALTER

ADDRESS: 4410 Salem Bottom Road, Westminster PHONE NUMBER: 410-875-4197

SUBDIVISION: Stanley B. Miller Property LOT NUMBER: 23

ADDRESS: 16483 Frederick Road PROPERTY OWNER: Joan Alascio

SEPTIC TANK CAPACITY (GALLONS): 1250

PUMP CHAMBER CAPACITY (GALLONS): N/A

NUMBER OF BEDROOMS: 4

SQUARE FEET PER BEDROOM: 240

LINEAR FEET OF TRENCH REQUIRED: 240

TRENCHES:	Trench to be 2.0 feet wide. Inlet 3.5 feet below original grade. Bottom maximum depth 7.5 feet below original grade. Effective area begins at 3.5 feet below original grade. 4.0 feet of stone below distribution pipe.
LOCATION:	Starting from the right front lot corner, place the distribution box 180' down the right lot line and 20' off this same lot line. Run (3) trenches on contour to right side of lot.
NOTES:	

PLANS APPROVED: MER 5/22/01 OK (BB) DATE: 5/18/01


- NOTE: PERMIT VOID AFTER 2 YEARS
- NOTE: CONTRACTOR RESPONSIBLE FOR SCHEDULING A PRE-CONSTRUCTION INSPECTION FOR ALL INSTALLATIONS
- NOTE: WATERTIGHT SEPTIC TANKS REQUIRED
- NOTE: ALL PARTS OF SEPTIC SYSTEM SHALL BE 100 FEET FROM ANY WATER WELL
- NOTE: MANHOLE RISERS REQUIRED ON ALL SEPTIC TANKS AND PUMP CHAMBERS

**NEITHER THE HOWARD COUNTY COUNCIL NOR THE HEALTH DEPARTMENT IS RESPONSIBLE FOR THE SUCCESSFUL OPERATION OF ANY SYSTEM PERMITTEE RESPONSIBLE FOR OBTAINING FINAL APPROVAL ON THIS PERMIT CALL 410-313-2640 FOR INSPECTION OF SEPTIC SYSTEM**

P 515960

NOT TO SCALE

Well HO-94-2297

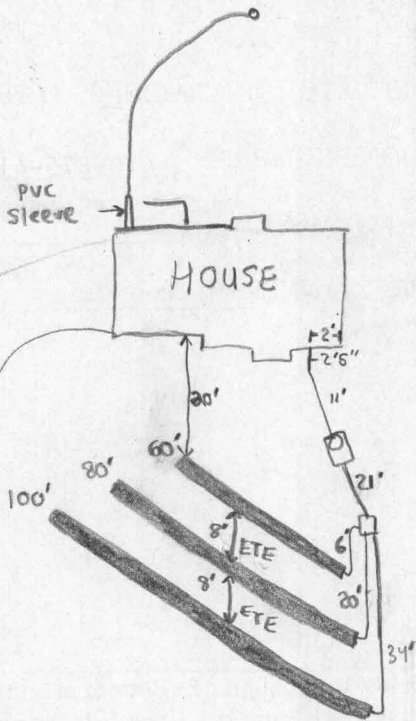

RT. 144 FREDERICK ROAD

**TRENCH DATA**

TRENCH WIDTH 2'  
 TRENCH INLET DEPTH 3.5'  
 TRENCH BOTTOM DEPTH 7.5'  
 DEPTH OF STONE 4'  
 NUMBER OF TRENCHES 3  
 TOTAL TRENCH LENGTH 240'  
 ABSORBENT AREA 720 ft<sup>2</sup>  
 DISTRIBUTION BOX LEVEL   
 BAFFLE IN DISTRIBUTION BOX

**SEPTIC TANK DATA** BAFFLES IN

SEPTIC TANK 1500 T.S. GALLONS  
 MANHOLE RISER on front  
 6 INCH INSPECTION PORT NO

**PUMP CHAMBER DATA**

PUMP CHAMBER GALLONS NA  
 MANHOLE RISER NA  
 ALARM NA  
 PUMP PERFORMANCE TEST NA

PRE-CONSTRUCTION INSPECTION: 8/21/01 @ 11:30 A Met Builder @ Site - No Sighting of Trenches evident, piles of fill dirt in

lower, Eastern portion of SDA. Sept Contractor needed as Builder Had No Idea. Owners of SDA were stoked. App

INSPECTION COMMENTS: 8/21/01 - OK TO COVER ALL WORK - SRK

INSPECTOR Steven R. Krieg DATE SYSTEM APPROVED 8/21/01