

JUNE 9, 1986  
3:50  
JUNE 10, 1986  
AM

6/11/86  
approved  
needs manhole c/o  
6/26/86  
manhole c/o  
verified c/o  
P 37086  
A 34480  
Bow

# PERMIT

SEWAGE DISPOSAL SYSTEM

MARYLAND STATE DEPARTMENT OF HEALTH

05-374448

HOWARD COUNTY

BUREAU OF ENVIRONMENTAL HEALTH  
992-2330 461-9933

ELLICOTT CITY

DISTRICT 5th

DATE 5/29/86

INDEXED  
INDEXED

Chuck Ashby

IS PERMITTED TO INSTALL  ALTER

ADDRESS 5755 Oklahoma Road, Sykesville, Maryland 21784 PHONE 781-6075

SUBDIVISION Glenelg Manor II ROAD 12891 Folly Quarter Road LOT 11-C

PROPERTY OWNER Richard Keister

ADDRESS 105-E North Rock Glen Road, Baltimore, Md. 21229

IF GARBAGE GRINDER IS USED INCREASE SEPTIC TANK CAPACITY BY 50% AND ABSORPTION AREA BY 22%.

GARBAGE GRINDER? YES \_\_\_\_\_ NO

SEPTIC TANK CAPACITY 1,000 GALLONS NUMBER OF BEDROOMS 3

TRENCHES - 180 sq. ft. sidewall area per bedroom. Trench to be 3 ft. wide. Inlet 3 ft. below original grade. Bottom maximum depth 4 1/2 ft. below original grade. Effective area begins at 3 ft. below original grade. 1 1/2 ft. of stone below distribution pipe. Start the first trench 250 ft. from the 299.78 ft. lot line and 135 ft. from the 476.24 ft. lot line. Run trenches along level ground toward the 476.24 ft. lot line. NO TRENCH TO EXCEED 100 FEET IN LENGTH. IF MORE THAN ONE TRENCH USED, A DISTRIBUTION BOX IS REQUIRED. CALL FOR INSPECTION OF TRENCHES BEFORE AND AFTER GRAVEL IS INSTALLED. *OK*

**BUILDING PERMIT SIGNED  
AND RETURNED**

49105 B00153504-GARAGE

PLANS APPROVED BY Craig Williams DATE 5/20/85

COVER NO WORK UNTIL INSPECTED AND APPROVED.

NEITHER THE HOWARD COUNTY COUNCIL NOR THE HEALTH DEPARTMENT IS RESPONSIBLE FOR THE SUCCESSFUL OPERATION OF ANY SYSTEM.

NOTE: IF TRENCH IS USED CALL FOR INSPECTION BEFORE AND AFTER PLACING GRAVEL IN TRENCH.

NOTE: NO DRY WELL SHALL EXCEED 15 FOOT IN DIAMETER. NO ABSORPTION TRENCH TO EXCEED 100 FEET IN LENGTH.

NOTE: ALL PIPE FROM HOUSE TO SEPTIC TANK MUST BE CAST IRON OR SCHEDULE 40 PVC OR ABS.

PERMIT VOID AFTER THREE YEARS.

NOTE: INSTALL STAND PIPE ON SEPTIC TANK AND DRY WELL. STAND PIPES MUST BE 6 INCHES IN DIAMETER CAST IRON, CONCRETE OR TERRA COTTA, OR PVC OR ABS ACCEPTED. IF TOP OF SEPTIC TANK IS DEEPER THAN 3 FEET MANHOLE TO GRADE REQUIRED.


BLDG. PERMIT SIGNED  
AND RETURNED 5/18/85  
Serial # 48661 - PPA

**\*INSTALLER IS RESPONSIBLE FOR OBTAINING FINAL APPROVAL ON THIS PERMIT**

\*CALL 992-2330 FOR INSPECTION OF SEPTIC SYSTEMS.

EH - 2-1082

A  
37448

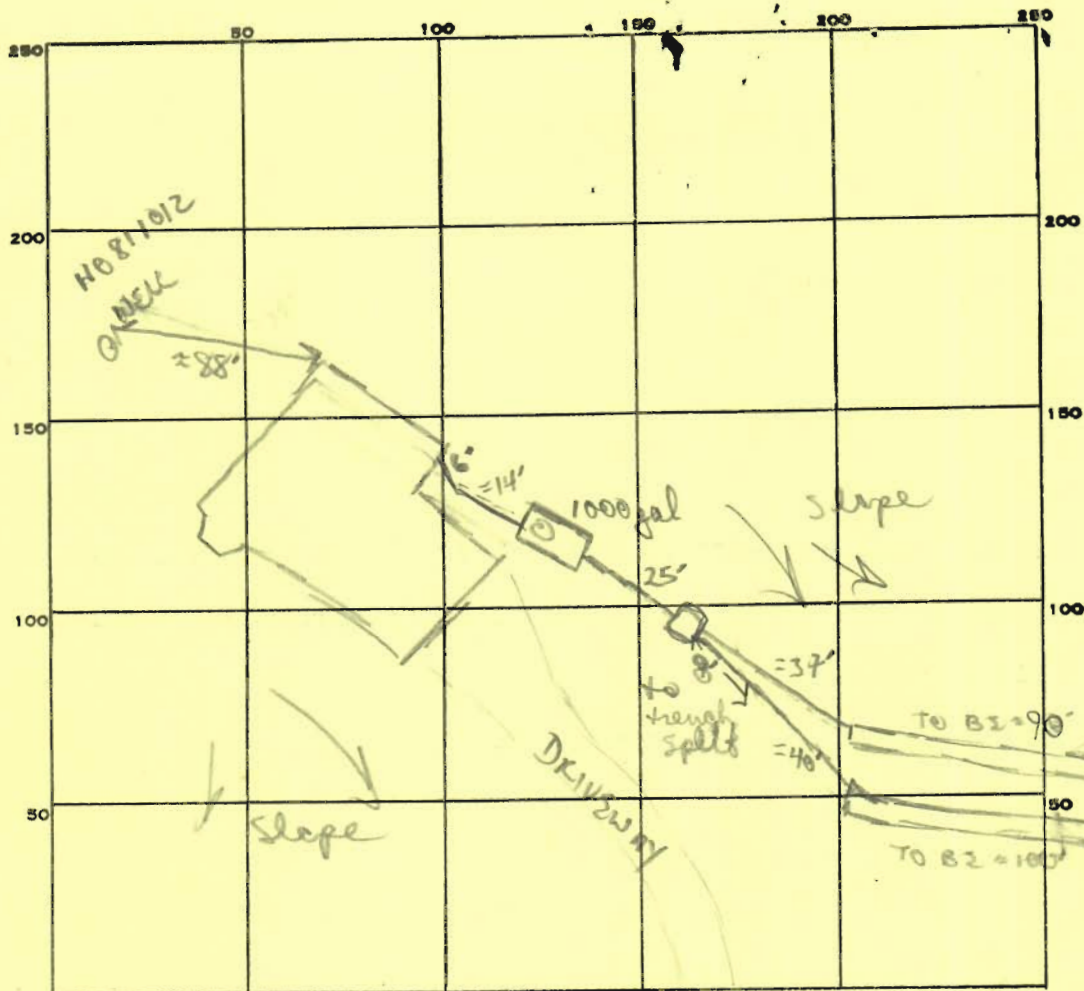

PERMIT CARD

SEPTIC TANK, LEVEL

DISTRIBUTION BOX, LEVEL

TILE FIELD, DEPTH 18 IN. TRENCH WIDTH 3+ FT.

GRAVEL DEPTH 18 IN. TOTAL LENGTH 90' + 100' FT.

NUMBER OF TRENCHES 2 TOTAL BOTTOM AREA 270 + 300

SEEPAGE PITS, INSIDE DIAMETER — FT. DEPTH BELOW INLET — FT.

ABSORBENT AREA 570 SQ. FT.

REMARKS

S.T. will need manhole c/o. (= 4' below grade)  
 OK to continue digging trenches 1 & 2; OK to add stone pipe paper to both trenches

6/10/86 OK to finish digging trench (lengthen #1 to 90') + finish adding stone pipe paper to trenches. OK to cover trenches + all work from tank. Need to see man hole c/o before

DATE SYSTEM APPROVED

6/26/86

INSPECTOR

B Nixon

final approval

cont final

ROADWAY

will need man hole

CLEANOUTS

man hole c/o verified

To main  
Common  
RATED  
TO ROAD

180  
3  
540 MIN