

ISSUE DATE: 10/5/2001

P 516058-B

APPROVAL DATE: 10/31/01

A 39143

# PERMIT

INDEXED

## ON-SITE SEWAGE DISPOSAL SYSTEM HOWARD COUNTY HEALTH DEPARTMENT BUREAU OF ENVIRONMENTAL HEALTH

05-410339

SK Backhoe & Septic Service IS PERMITTED TO  INSTALL  ALTER

ADDRESS: 1220 FSK Highway, Keymer PHONE NUMBER: 410-775-0562

SUBDIVISION: Clarksville Manor LOT NUMBER: 5

ADDRESS: 6312 Golden Harvest Court PROPERTY OWNER: SANDRA + DANNY SELBY  
Trinity Custom Homes

SEPTIC TANK CAPACITY (GALLONS): 1500

PUMP CHAMBER CAPACITY (GALLONS): N/A

NUMBER OF BEDROOMS: 5

SQUARE FEET PER BEDROOM: 210

LINEAR FEET OF TRENCH REQUIRED: 350

|           |  |
|-----------|--|
| TRENCHES: | Trench to be 3.0 feet wide. Inlet 2.0 feet below original grade. Bottom maximum 4' depth <del>2</del> feet below original grade. Effective area begins at 2.0 feet below original grade. <del>2</del> feet of stone below distribution pipe. |
| LOCATION: | Begin trenches 185 feet off the 338.79' lot line and 170 feet off the 480.03' lot line. Run trenches on contour toward the 338.79' lot line.   |
| NOTES:    | 10' CTC (7' Edge to Edge) <u>SRK</u>   |

PLANS APPROVED: Amy Mc Millen 7/11/01 OK (BB) DATE: 7-11-01


- NOTE: PERMIT VOID AFTER 2 YEARS
- NOTE: CONTRACTOR RESPONSIBLE FOR SCHEDULING A PRE-CONSTRUCTION INSPECTION FOR ALL INSTALLATIONS
- NOTE: WATERTIGHT SEPTIC TANKS REQUIRED
- NOTE: ALL PARTS OF SEPTIC SYSTEM SHALL BE 100 FEET FROM ANY WATER WELL
- NOTE: MANHOLE RISERS REQUIRED ON ALL SEPTIC TANKS AND PUMP CHAMBERS

**NEITHER THE HOWARD COUNTY COUNCIL NOR THE HEALTH DEPARTMENT IS RESPONSIBLE FOR THE SUCCESSFUL OPERATION OF ANY SYSTEM PERMITTEE RESPONSIBLE FOR OBTAINING FINAL APPROVAL ON THIS PERMIT CALL 410-313-2640 FOR INSPECTION OF SEPTIC SYSTEM**

ALL PERMITS SIGNED AND RETURNED 1-3-2002  
B00133808  
16x12 DECK + 21x16 Sep. Porch  
1/23/03 B00140080 INGROUND POOL

1 2 16008-D

NOT TO SCALE

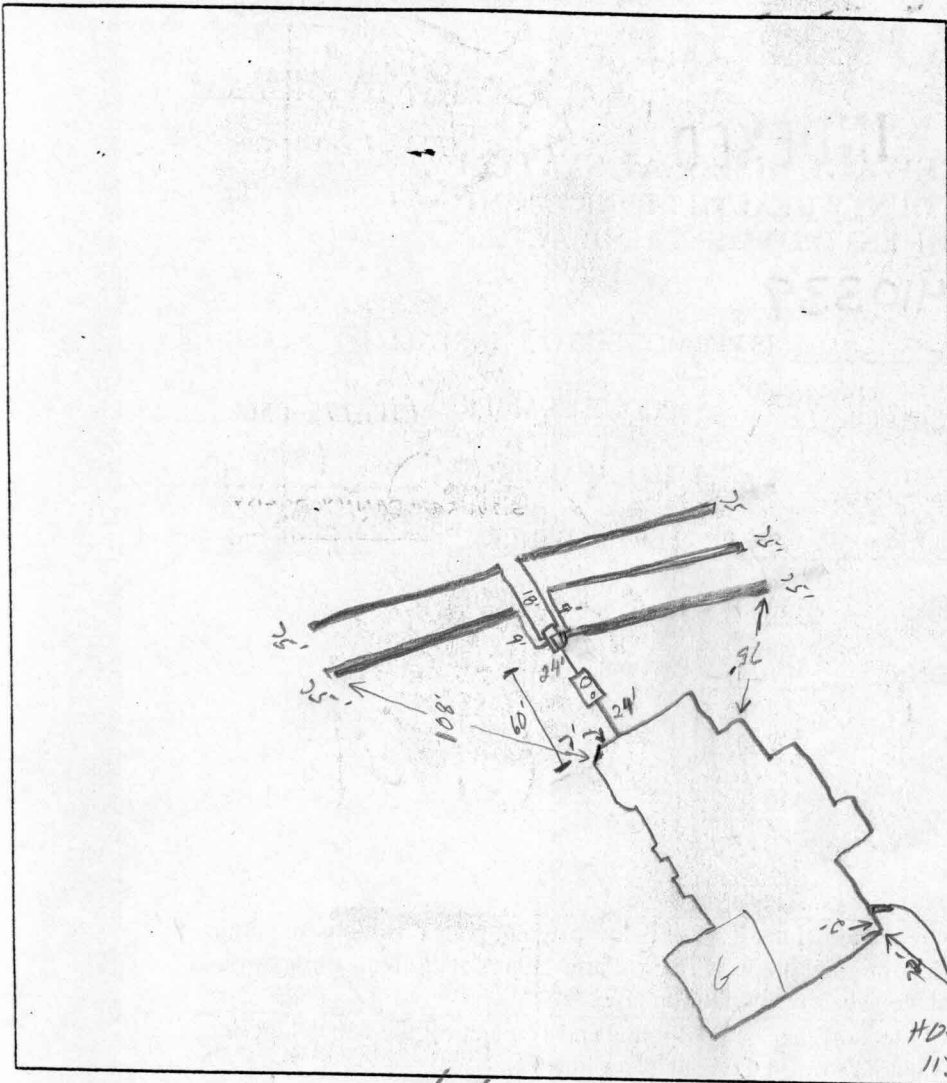

**TRENCH DATA**

TRENCH WIDTH 3'  
 TRENCH INLET DEPTH 2'  
 TRENCH BOTTOM DEPTH 4'  
 DEPTH OF STONE 2'  
 NUMBER OF TRENCHES 5  
 TOTAL TRENCH LENGTH 350'  
 ABSORBENT AREA 1050 #  
 DISTRIBUTION BOX LEVEL ✓  
 BAFFLE IN DISTRIBUTION BOX ✓

**SEPTIC TANK DATA**

SEPTIC TANK 1500 TS GALLONS  
 MANHOLE RISER 3'  
 6 INCH INSPECTION PORT 3'

**PUMP CHAMBER DATA**

PUMP CHAMBER GALLONS                       
 MANHOLE RISER                       
 ALARM                       
 PUMP PERFORMANCE TEST                     

PRE-CONSTRUCTION INSPECTION: 10/20/01 Contractor requested to move 2 trenches to left side of reserve area. Call to Steve K. to discuss. OK'd move (SO) OK to cover to D.B.

INSPECTION COMMENTS: 10/21/01 OK to cover all work. Permit signed (SO)

INSPECTOR Steve K. DATE SYSTEM APPROVED 10/21/01