

5/3/71
Randy

516100-A

PERMIT

P 15926
A _____

SEWAGE DISPOSAL SYSTEM

MARYLAND STATE DEPARTMENT OF HEALTH

HOWARD COUNTY

ELLICOTT CITY
DISTRICT 6
DATE 5/3/71

INDEXED

Jenkins Brothers IS PERMITTED TO INSTALL _____ ALTER X
ADDRESS Wallis Park, Ellicott City, Md. PHONE HO 5-6646
A SEWAGE DISPOSAL SYSTEM LOCATED AT _____

SUBDIVISION _____ ROAD Gorsean - 1st big LOT _____
PROPERTY OWNER Mrs. C. Y. Stephens white house off Rt. 29 before bridge at I-95
ADDRESS _____

SPECIFICATIONS - **REPAIR**

DRAIN FIELD _____ DEPTH _____ FEET. BOTTOM AREA _____ SQ. FT.
SEEPAGE PITS _____ ABSORBENT SIDE-WALL AREA _____ SQ. FT.
SEPTIC TANK CAPACITY 750 GALLONS

PLAN PERMITS
10/3/2001
BDD 133019
Construct Temp. Handicap Ramp

FOR GARBAGE GRINDER, INCREASE DISPOSAL AREA 22% & TANK CAPACITY 50%.


OTHER REPAIR - Connect line into existing system.

PLANS APPROVED BY Palmer F. Wine DATE 5/3/71

FILL SEPTIC TANK AND DISTRIBUTION BOX WITH WATER BEFORE CALLING FOR AN INSPECTION. COVER NO WORK UNTIL INSPECTED AND APPROVED.

NEITHER THE HOWARD COUNTY COMMISSIONERS NOR THE HEALTH DEPARTMENT IS RESPONSIBLE FOR THE SUCCESSFUL OPERATION OF ANY SYSTEM.

HOWARD COUNTY
 HEALTH DEPT.
 DIVISION OF
 ENVIRONMENTAL
 HEALTH
 APR 4 2 50 PM '71

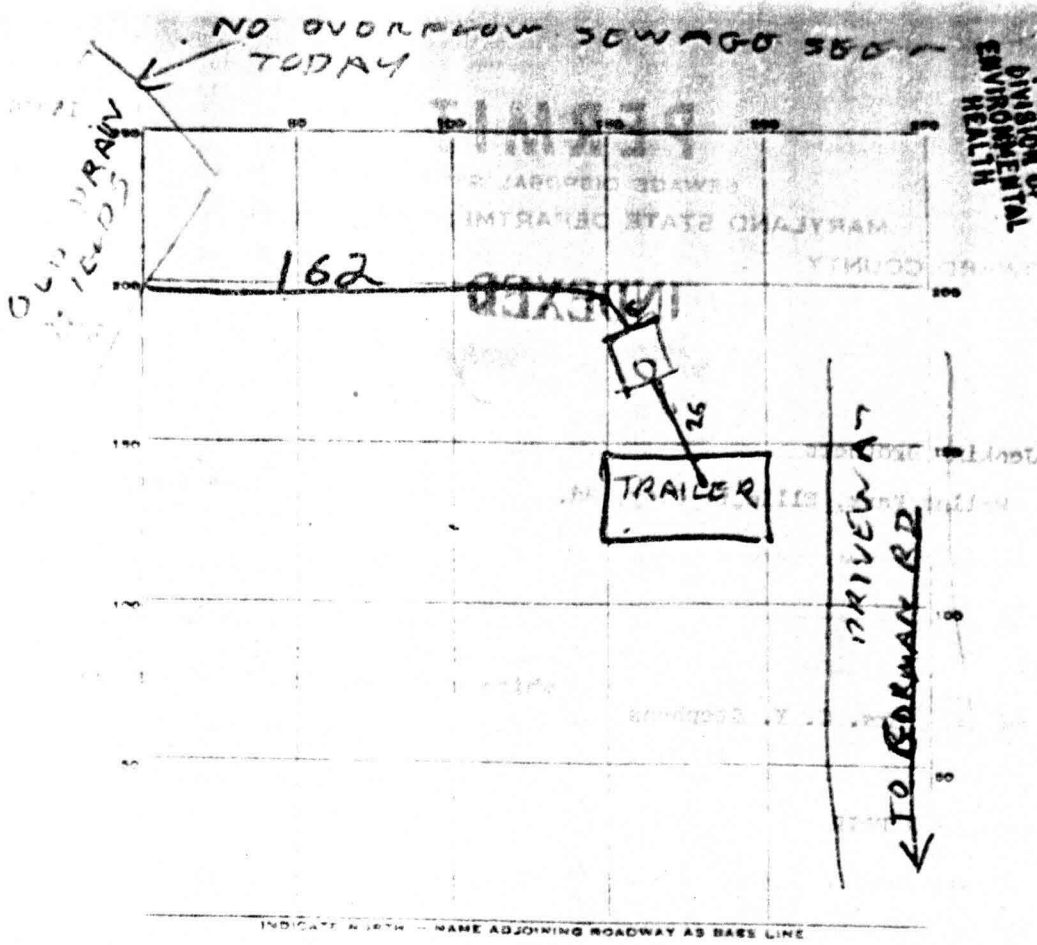

PERMIT CARD _____

SEPTIC TANK LEVEL OK concrete 750 CLEANOUTS condablock users
 TOP 1-2 ft below grade
 DISTRIBUTION BOX LEVEL _____

TILE FIELD DEPTH _____ FT. TRENCH WIDTH _____ FT.

GRAVEL DEPTH _____ IN. TOTAL LENGTH _____ FT.

NUMBER OF TRENCHES _____ TOTAL BOTTOM AREA _____

TEEPAGE FITS INSIDE DIAMETER _____ FT. DEPTH BELOW INLET _____ FT.

ABSORBENT AREA _____ SQ. FT.

REMARKS Trailer obtains water from
spring which also supplies Big
Spring well near septic system

DATE SYSTEM APPROVED 5/5/71 INSPECTOR Raymond Hod

7/25/86

FILE NO

NOTE

SHOWS TR

EXISTING WELL
BE A J. MAYNE
EASTRDAY (OFF)

S. AREAS

9801 German Rd

HP 732

S. AREAS

2ND HOUSE

150'

AREA
OF
SEPTIC
FIELD
(NO 40'S
SEEN)


MAIN HOUSE

400'

= 5'

OK
↑
WELL
BY A
POOL

OP
FI

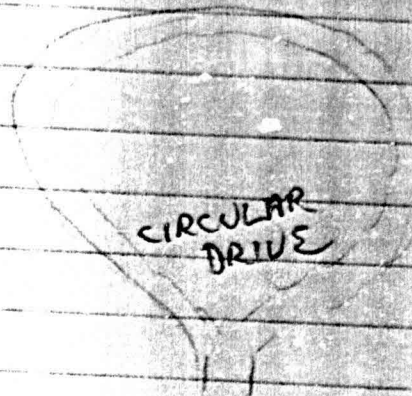

CIRCULAR
DRIVE

FOR
POOL
ONLY
WOODEN F
CRUISE DRY
PERIODICALLY
(DON'T KNOW IF
THIS IS ONLY WELL)

GERMAN ROAD

SITE IS ≈ 80

1000' FROM MAIN
HOUSE WELL
TO SERVE ALL
3 DWELLINGS