
 WATER WELL ABANDONMENT-SEALING REPORT FORM

SUBMIT COPIES OF COMPLETED FORM TO:

- * COUNTY ENVIRONMENT AGENCY (contact MDE, WMA if address needed)
- * WELL OWNER
- * MDE, WATER MANAGEMENT ADMINISTRATION, WELL PROGRAM

DATE WELL ABANDONED: 05/07/03 (month/day/year)

* PERMIT NUMBER OF ABANDONED WELL (if any) unknown

* PERMIT NUMBER OF REPLACEMENT WELL N/A


* PERSON ABANDONING WELL: KAMES

WELL DRILLERS LICENSE NUMBER: M60 063
 CIRCLE: MWD/MSD/MGD

* OWNER'S NAME: Roux Company

* WELL LOCATION:
 COUNTY: Harard
 NEAREST TOWN: Columbia
 TAX MAP _____ BLOCK _____ PARCEL _____
 SUBDIVISION: _____
 SECTION: _____ LOT: _____
 NEAREST ROAD: 9801 Gorman Road

SITE LOCATION MAP

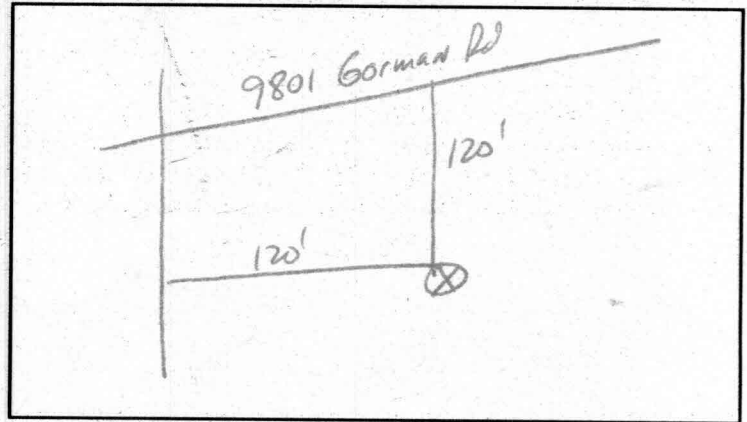

* TYPE OF WELL BEING ABANDONED:

- DRILLED JETTED
- BORED/AUGERED HAND DUG
- OTHER (specify) _____

* USE CODE:

- DOMESTIC MUNICIPAL/PUBLIC
- IRRIGATION INDUSTRIAL
- TEST/OBSERVATION GEOTHERMAL

* TYPE OF CASING:

- STEEL PLASTIC
- CONCRETE OTHER (specify) _____

* SIZE OF CASING: 6 INCHES IN DIAMETER

* DEPTH OF WELL: 140 FEET DEEP

* WAS ANY CASING REMOVED? YES NO
 if yes, length removed, in feet: _____

* WAS CASING RIPPED OR PERFORATED? YES NO

LOG OF SEALING MATERIAL

| MATERIAL | FEET | |
|-------------------------|------|-----|
| | FROM | TO |
| Bentonite Cement | 0 | 140 |
| VOLUME OF MATERIAL USED | | |
| 80 gallons | | |