

# PERMIT

P 25966

A23770

8/12/77

SEWAGE DISPOSAL SYSTEM

MARYLAND STATE DEPARTMENT OF HEALTH

HOWARD COUNTY

ELLICOTT CITY

DISTRICT 2nd

**INDEXED**

DATE 6/1/77

Emerson Feaga

IS PERMITTED TO INSTALL  ALTER

ADDRESS Old Frederick Road, Woodstock, Md.

PHONE 328-2481

A SEWAGE DISPOSAL SYSTEM LOCATED AT \_\_\_\_\_

SUBDIVISION Allenford

ROAD Green Clover Drive

LOT 68, Blk, Sec. 8  
old Lot no. 64

PROPERTY OWNER Robert D. Crawford

ADDRESS 105 N. Beechwood Ave., Baltimore, Md. 21228

SPECIFICATIONS 3 bedrooms

DRAIN FIELD \_\_\_\_\_ DEPTH \_\_\_\_\_ FEET, BOTTOM AREA \_\_\_\_\_ SQ. FT.

SEEPAGE PITS \_\_\_\_\_ ABSORBENT SIDE-WALL AREA \_\_\_\_\_ SQ. FT.

SEPTIC TANK CAPACITY 1000 GALLONS

FOR GARBAGE GRINDER, INCREASE DISPOSAL AREA 22% & TANK CAPACITY 50%.

OTHER DRY WELL-120 sq. feet sidewall area below inlet per bedroom. Dry Well inlet to be 3 feet deep and bottom of dry well to be 13 feet deep. Place the dry well 20 feet from the lot line along Hobson's Choice Drive and 65 feet from the lot line along Green Clover Drive. Install manhole type cleanout to grade level.

NOTE: ALL PIPE FROM HOUSE TO DISPOSAL AREA MUST BE CAST IRON. PERMIT VOID AFTER THREE YEARS.

NOTE: INSTALL STAND PIPES ON SEPTIC TANK AND DRY WELL. STAND PIPES MUST BE 6 INCHES IN DIAMETER. CAST IRON, CONCRETE OR TERRA COTTA ACCEPTED.

PLANS APPROVED BY Raymond Hodges


DATE 10/22/76

FILL SEPTIC TANK AND DISTRIBUTION BOX WITH WATER BEFORE CALLING FOR AN INSPECTION. COVER NO WORK UNTIL INSPECTED AND APPROVED.

NEITHER THE HOWARD COUNTY COMMISSIONERS NOR THE HEALTH DEPARTMENT IS RESPONSIBLE FOR THE SUCCESSFUL OPERATION OF ANY SYSTEM.

*serial 37894  
pool signed  
12/4/78*

A23770

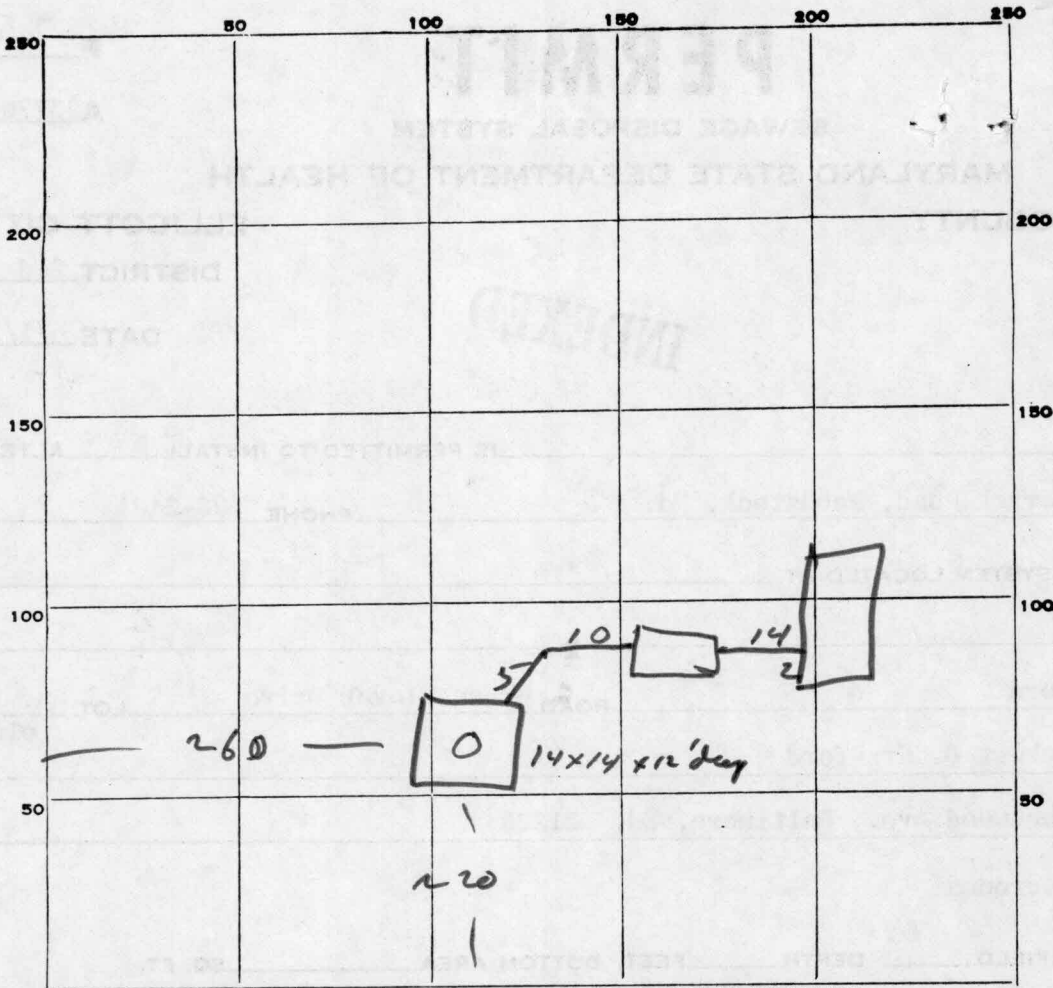

INDICATE NORTH. - NAME ADJOINING ROADWAY AS BASE LINE.

← Hobson's →

PERMIT CARD

SEPTIC TANK, LEVEL  CLEANOUTS

DISTRIBUTION BOX, LEVEL

TILE FIELD, DEPTH \_\_\_\_\_ FT. TRENCH WIDTH \_\_\_\_\_ FT.

GRAVEL DEPTH \_\_\_\_\_ IN. TOTAL LENGTH \_\_\_\_\_ FT.

NUMBER OF TRENCHES \_\_\_\_\_ TOTAL BOTTOM AREA \_\_\_\_\_

SEEPAGE PITS, INSIDE DIAMETER Perimeter 56 FT. DEPTH BELOW INLET 8.5 FT.

ABSORBENT AREA 476 SQ. FT.

56  
8.5  
28.0  
448  
476

17 Aug 77  
REMARKS

- 1) re cement sewage pipe to S.T.
- 2) cover all work
- 3) call me to confirm R.M.

18 Aug - recementing all R.M.

DATE SYSTEM APPROVED 18 Aug 77 INSPECTOR R Monoful