

APPLICATION

PERCOLATION TESTING

A 515958

P _____

HOWARD COUNTY HEALTH DEPARTMENT
BUREAU OF ENVIRONMENTAL HEALTH
3525-H ELLICOTT MILLS DRIVE/ELLICOTT CITY, MARYLAND 21043
TELEPHONE: 313-2840

DISTRICT _____

DATE 7/26/01

TO: THE COUNTY HEALTH OFFICER
ELLICOTT CITY, MARYLAND

I HEREBY APPLY FOR THE NECESSARY TEST PRIOR TO APPLICATION FOR PERMIT TO CONSTRUCT (OR RECONSTRUCT) A SEWAGE DISPOSAL SYSTEM.

PROPERTY OWNER Melissa Owens

ADDRESS 1065 Arbor Hill Rd. PHONE _____
Staunton, VA 24401

AGENT OR PROSPECTIVE BUYER SECURITY DEVELOPMENT, LLC

ADDRESS P.O. BOX 417 ELLICOTT CITY MD 21041 PHONE 410-465-4844

PROPERTY LOCATION:

SUBDIVISION JACKSON PROPERTY LOT NO. 4

ROAD AND DESCRIPTION BURNT WOODS ROAD EAST OF SNOW CHIEF ROAD

TAX MAP 22 PARCEL # 2

SIZE OF LOT 1 Ac ± TYPE BLDG. SINGLE FAMILY DETACHED
(SINGLE FAMILY DWELLING OR COMMERCIAL)

THE SYSTEM INSTALLED UNDER THIS APPLICATION IS ACCEPTABLE ONLY UNTIL PUBLIC FACILITIES BECOME AVAILABLE. I FULLY UNDERSTAND THE FEE CONNECTED WITH THE FILING OF THIS PERC TEST APPLICATION IS NON-REFUNDABLE UNDER ANY CIRCUMSTANCES. I ALSO AGREE TO COMPLY WITH ALL M.O.S.H.A. REQUIREMENTS IN TESTING THIS LOT.

Melissa Owens
(SIGNATURE OF APPLICANT)

APPROVED BY _____ FOR _____ DATE _____

DISAPPROVED BY _____ FOR _____ DATE _____

HOLD PENDING FURTHER TESTS _____

REASONS FOR REJECTION OR HOLDING _____

PERCOLATION TEST PLAT/PRELIMINARY PLAT - TITLE OR I.D. # _____ DATE _____

SITE DEVELOPMENT PLAN/FINAL PLAT - TITLE OR I.D. # _____ DATE _____

THIS IS NOT A PERMIT

515 958

NOT TO SCALE

COUNTY #

SOIL PROFILE

12

tan-brn structured silt loam

tan-beige micaceous sandy loam 0-5% decayed parent material



12'

13

SEE HOLE

12

No evidence of matting


12'

14

SEE HOLE


12

12'

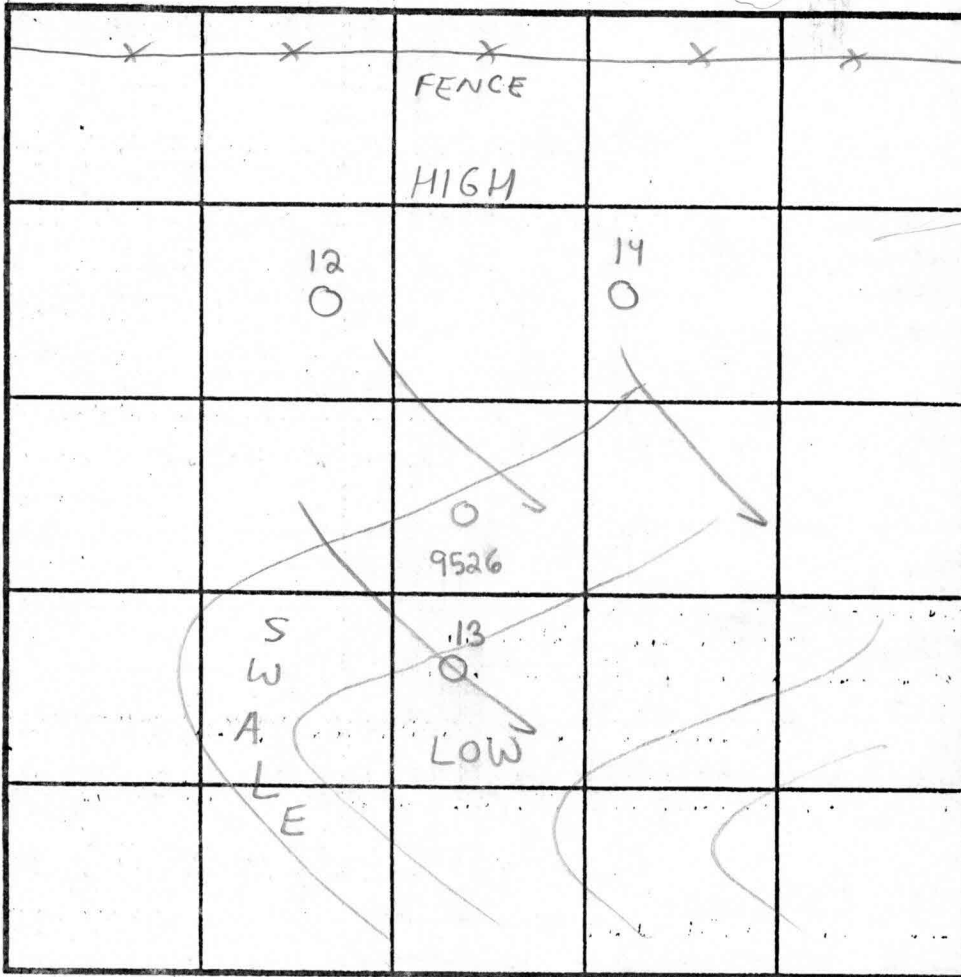

SOIL PROFILE

0'

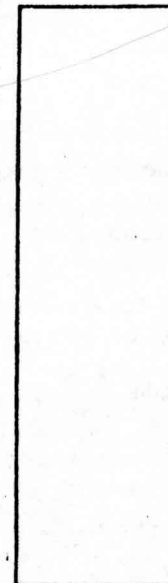

INDICATE NORTH - NAME ADJOINING ROADWAY AS BASE LINE.

RT. 32

DATE	TEST NO.	DEPTH	PRE-WET		TEST - 1" DROP		TIME	
			START	STOP	START	STOP		
9/20/02	12	4' T / 12' V	12:37pm	12:39pm	12:39pm	12:41pm	2min	OK
	13	3'6" T / 12' V	1:06pm	1:08pm	1:08pm	1:15pm	7min	OK
	14	12' V	(VISUAL OK SEE PROFILE)				NA	OK
4/14/98	9526	(OBSERVED PREVIOUSLY BY GLEN SAVAGE)						OK

REMARKS (SHALLOW SYSTEM ONLY)

TYPE OF SOIL Chester

TESTED BY SRK John Goodman's Backhoe ALSO PRESENT Clark Sperry

TRENCH DESIGN DATA: AVERAGE PERCOLATION TIME 4min TRENCH WIDTH 3'

INLET DEPTH 2' MAXIMUM BOTTOM DEPTH 4' SQ. FT./BEDROOM 180

Foxtail Run
Signed perc cert
5-14-03

- SOILS CLASSIFICATION
- SOILS DELINEATION
- EXISTING CONTOUR
- LIMIT OF WETLAND
- EXISTING WOODS
- PROPOSED WOODS
- EXISTING STRUCTURE
- PROPOSED STRUCTURE
- PROPOSED WELL
- SPECIMEN TREE
- EXISTING SEPTIC
- PROPOSED SEPTIC
- FOREST CONSERVATION EASEMENT
- PERCOLATION TEST
- PERCOLATION TEST
- PERCOLATION TEST



EX. POND

GREYFOX RUN
 PUBLIC ACCESS PLACE

FOREBAY

PAV. 8'

40' R.W.

9527 MARGINAL

9524 MARGINAL

P. 11 C.