

LAYOUT 2/17/07 INSP 4 _____
 INSP 2 3/15/07 INSP 5 _____
 INSP 3 _____ INSP 6 _____

ISSUE DATE: 01/23/2007

APPROVAL DATE: 3/20/2007

P 526202
 A 515958

PERMIT
INDEXED
TAX ID #03-342352
ON-SITE SEWAGE DISPOSAL SYSTEM
HOWARD COUNTY HEALTH DEPARTMENT
BUREAU OF ENVIRONMENTAL HEALTH

Rylea Homes, Inc. IS PERMITTED TO INSTALL ALTER

ADDRESS: P.O. Box 68, Glenwood 21738 PHONE NUMBER: _____

SUBDIVISION: Foxtail Run LOT NUMBER: 4

ADDRESS: 13712 ~~Gray Fox~~ ^{Greyfox} Run PROPERTY OWNER: Rylea Homes, Inc.

SEPTIC TANK CAPACITY (GALLONS): 1500 OUTLET BAFFLE FILTER REQUIRED

PUMP CHAMBER CAPACITY (GALLONS): n/a COMPARTMENTED TANK REQUIRED

NUMBER OF BEDROOMS: 5

SQUARE FEET PER BEDROOM: 180


LINEAR FEET OF TRENCH REQUIRED: 249 HOUSE SERVED BY PUBLIC WATER

TRENCHES:	Trench to be 3.0 feet wide. Inlet 2.0 feet below original grade. Bottom maximum depth 4.0 feet below original grade. Effective area begins at 3.0 feet below original grade. 2.0 feet of stone below distribution pipe.
LOCATION:	Install the septic system as shown on the approved building permit plan.
NOTES:	Basement not serviced by gravity. House moved toward SDA (not) Garage

PLANS APPROVED: Sara Fegel DATE: 5/19/06

NOTES: PERMIT VOID AFTER 2 YEARS
 CONTRACTOR IS RESPONSIBLE FOR SCHEDULING A PRE-CONSTRUCTION INSPECTION FOR ALL INSTALLATIONS
 WATERTIGHT SEPTIC TANKS REQUIRED
 ALL PARTS OF SEPTIC SYSTEM SHALL BE 100 FEET FROM ANY WATER WELL UNLESS SPECIFICALLY AUTHORIZED
 MANHOLE RISERS REQUIRED ON ALL SEPTIC TANKS AND PUMP CHAMBERS UNLESS SPECIFICALLY AUTHORIZED
 CONTRACTOR RESPONSIBLE FOR COMPLIANCE WITH APPLICABLE REGULATIONS, GUIDELINES AND THE TERMS OF THIS PERMIT

NEITHER THE HOWARD COUNTY COUNCIL NOR THE HEALTH DEPARTMENT IS RESPONSIBLE FOR THE SUCCESSFUL OPERATION OF ANY SYSTEM PERMITTEE RESPONSIBLE FOR OBTAINING FINAL APPROVAL ON THIS PERMIT CALL 410-313-1771 FOR INSPECTION OF SEPTIC SYSTEM

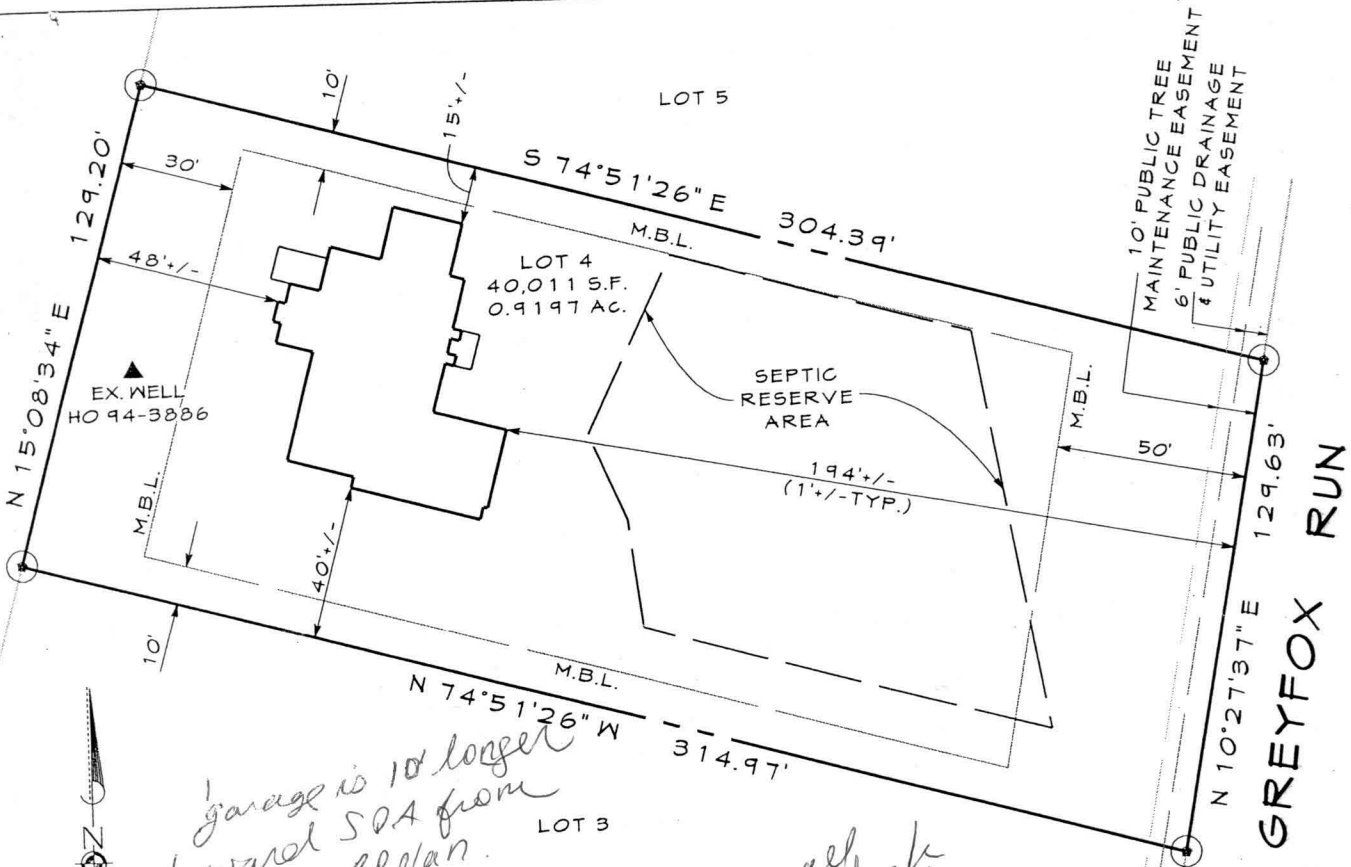


10' PUBLIC TREE
MAINTENANCE EASEMENT
6' PUBLIC DRAINAGE
& UTILITY EASEMENT



*Garage is 10' longer
extending toward
original B.P. plan.*

*wall
check
of
1/26/07
SP*

*Bldg. Permit # B001546
13712 Greyfox Run
Glenely, MD 21737*

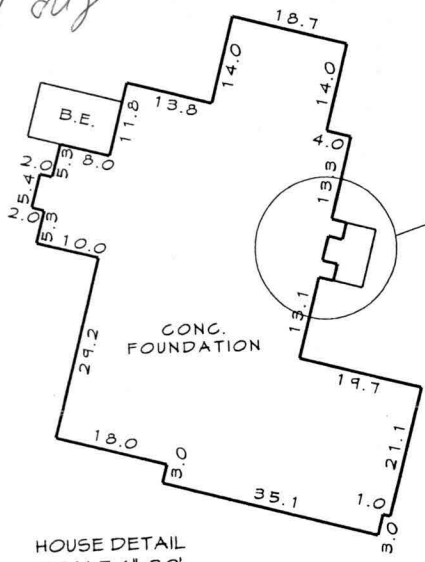

HOUSE DETAIL
SCALE: 1"=30'



FOUNDATION CERTIFICATION
LOT 4
FOXTAIL RUN
3RD ELECTION DISTRICT HOWARD COUNTY, MD.
PLAT NO. 17125

A licensed Maryland Surveyor either personally prepared this Location Drawing, or was in responsible charge over its preparation and the surveying work reflected in it, in compliance with the Maryland Minimum Standards of Practice for Land Surveyors.

I hereby certify that I have surveyed the property shown hereon for the sole purpose of locating the improvements. This plan is a benefit to the consumer only in so far as it is required by a lender or a title insurance company or its agent in connection with contemplated transfer, financing or refinancing. It is not to be relied upon for the establishment of boundary, easement or right-of-way lines for any reason, such as the location of fences, garages, buildings, or other existing or future improvements.

By Dennis E. Meckley Date 12/12/06
Dennis E. Meckley Property Line Surveyor No. 10844



FREDERICK OFFICE:
8445 Progress Drive, Suite BB
Frederick, MD 21701-4879
(301) 662-1799
FAX (301) 662-8004

WESTMINSTER OFFICE:
439 East Main Street
Westminster, MD 21157-5539
(410) 848-1790
FAX (410) 848-1791

DRAWN BY:	CDD
DESIGN BY:	
REVIEW BY:	DEM
DATE:	12-08-06
SCALE:	1"=50'
JOB NO:	2005003
SHEET:	1 OF 1