

preliminary
4-13-76
EX 10, 2004

APPLICATION

A 24173

SEWAGE DISPOSAL TESTING

P _____

STATE OF MARYLAND - DEPARTMENT OF HEALTH AND MENTAL HYGIENE

HOWARD COUNTY HEALTH DEPARTMENT
ENVIRONMENTAL HEALTH SERVICES

DISTRICT 3rd

P. O. BOX 476, ELLICOTT CITY, MARYLAND 21043
TELEPHONE: 465-5000, EXT. 356

DATE 9/21/76

TO: THE COUNTY HEALTH OFFICER
ELLICOTT CITY, MARYLAND

I, HEREBY, APPLY FOR THE NECESSARY TEST IN ORDER TO CONSTRUCT (OR RECONSTRUCT) A SEWAGE DISPOSAL SYSTEM.

PROPERTY OWNER Fred James Pipes Ronald F. Schrauder

ADDRESS 13555 Old Frederick Road, Sykesville, Md. 4111 Buckingham Road
Rockvale, 21784 Md PHONE 484-9506

PROPERTY LOCATION:
SUBDIVISION Annandale LOT NO. 16

ROAD AND DESCRIPTION 13374 Grinstead Road

SIZE OF LOT 40,600 sq. ft. TYPE BLDG. 3 or 4

IF NOT SINGLE RESIDENCE DESCRIBE single family dwelling

THE SYSTEM INSTALLED UNDER THIS APPLICATION IS ACCEPTABLE ONLY UNTIL PUBLIC FACILITIES BECOME AVAILABLE.

SIGNATURE OF APPLICANT /s/ Fred James Pipes

APPROVED BY Paul J. O'Neil FOR DW + T. and DATE 12/19/79
(KIND OF SYSTEM)


REJECTED BY _____ FOR _____ DATE _____
(KIND OF SYSTEM)

HOLD PENDING FURTHER TESTS F. Schrauder DATE 10/22/76

REASONS FOR REJECTION OR HOLDING _____

BLDG. PERMIT SIGNED
AND RETURNED 12/18/79
Serial # 60216 SF10

THIS IS NOT A PERMIT

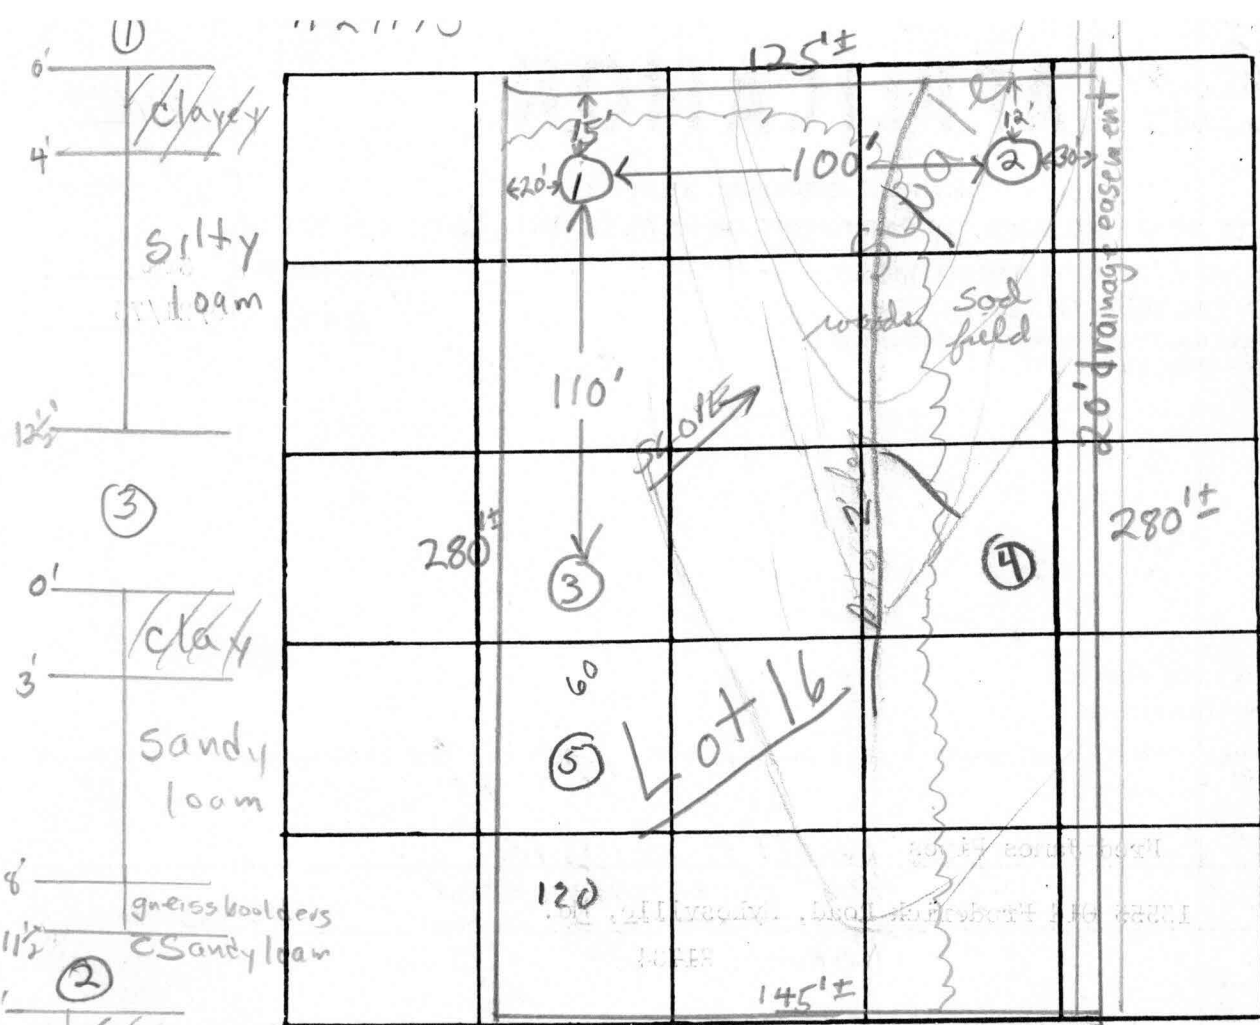

INDICATE NORTH. - NAME ADJOINING ROADWAY AS BASE LINE

Grinstead Court

DATE	TEST NO.	DEPTH	PRE-WET		TEST - 1" DROP		TIME
			START	STOP	START	STOP	
10/22/76	1	4 1/2'	10:00	10:03	10:03	10:07	4 min
	1A	12 1/2'	10:01	10:08	10:08	10:19	10 min
	2	5'	10:11	10:21	10:21	10:33	12 min
	2A	13'	10:13	~11:05	pulled peg overdrill		FAILS
	3	3 1/2'	11:22	11:25	11:25	11:30	5 min
	3A	11 1/2'	11:20	11:32	11:32	pulled peg at 12:18 1/2" drop	Sandy loam at 3'
	3B	11 1/2'	11:57	pulled peg 12:20	1/2" drop		FAILS

REMARKS _____

TYPE OF SOIL sandy loam & clay loam below top 3' clay

TESTED BY F.S. ALSO PRESENT: Pipes et al

APPLICATION

A 24173

SEWAGE DISPOSAL TESTING

P _____

STATE OF MARYLAND - DEPARTMENT OF HEALTH AND MENTAL HYGIENE

HOWARD COUNTY HEALTH DEPARTMENT
ENVIRONMENTAL HEALTH SERVICES
P. O. BOX 476, ELLICOTT CITY, MARYLAND 21043
TELEPHONE: 465-5000, EXT. 356

DISTRICT 3rd

DATE 9/21/76

TO: THE COUNTY HEALTH OFFICER
ELLICOTT CITY, MARYLAND

I, HEREBY, APPLY FOR THE NECESSARY TEST IN ORDER TO CONSTRUCT (OR RECONSTRUCT) A SEWAGE DISPOSAL SYSTEM.

PROPERTY OWNER Fred James Pipes

ADDRESS 13555 Old Frederick Road, Sykesville, Md. PHONE _____

21784

PROPERTY LOCATION:

SUBDIVISION Annandale LOT NO. 16

ROAD AND DESCRIPTION Grinstead Road

SIZE OF LOT 40,600 sq. ft. TYPE BLDG. 3 or 4

NUMBER OF BEDROOMS

IF NOT SINGLE RESIDENCE DESCRIBE single family dwelling

THE SYSTEM INSTALLED UNDER THIS APPLICATION IS ACCEPTABLE ONLY UNTIL PUBLIC FACILITIES BECOME AVAILABLE.

SIGNATURE OF APPLICANT /s/ Fred James Pipes

APPROVED BY _____ FOR _____ DATE _____
(KIND OF SYSTEM)


REJECTED BY _____ FOR _____ DATE _____
(KIND OF SYSTEM)

HOLD PENDING FURTHER TESTS _____ DATE _____

REASONS FOR REJECTION OR HOLDING _____

THIS IS NOT A PERMIT

A 24113

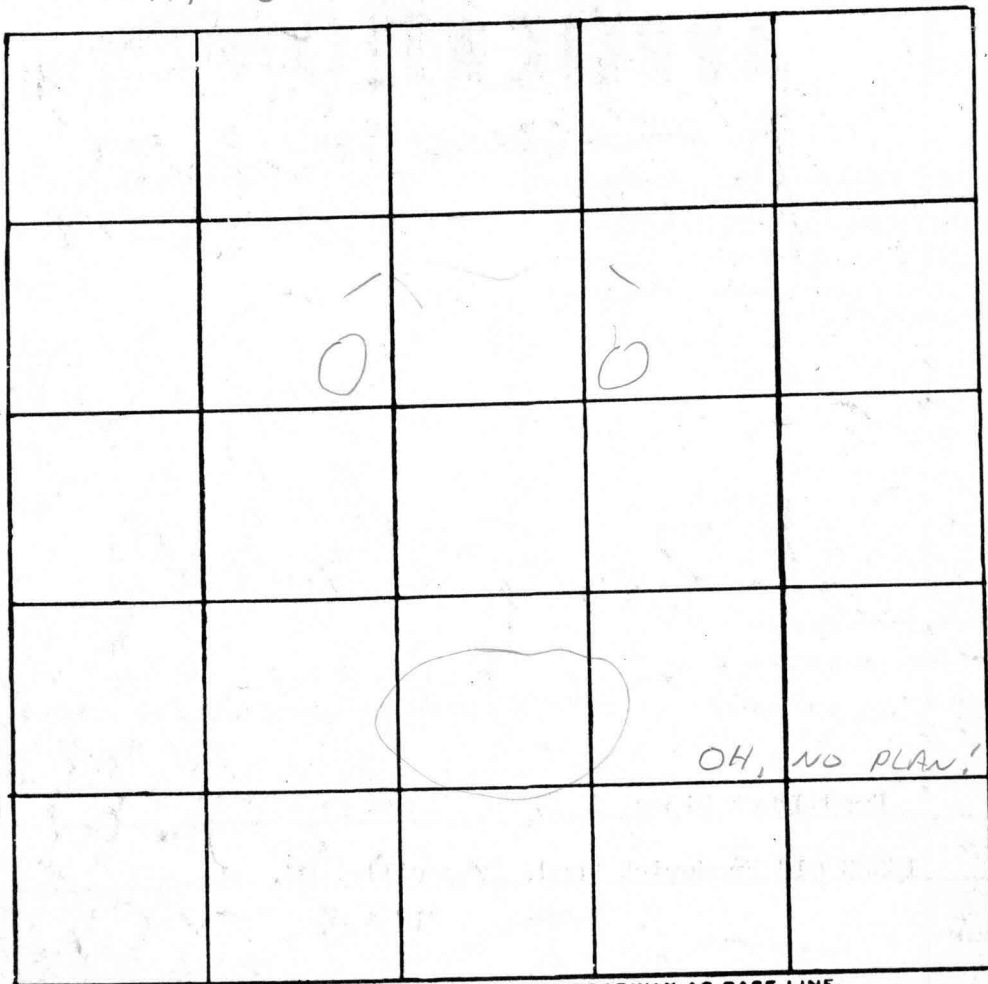

INDICATE NORTH. - NAME ADJOINING ROADWAY AS BASE LINE.

DATE	TEST NO.	DEPTH	PRE-WET		TEST - 1" DROP		TIME
			START	STOP	START	STOP	
3/3/9	23	3'6"	1025	1036	1036	1044	8
	d	11'6"	1025	1036	1036	1055	19
	45	8'	1026	1036	1036	1036	4
	d	13'	1026	1036	1036	1104	28
	5	11'	have				

REMARKS _____

TYPE OF SOIL _____

TESTED BY _____ ALSO PRESENT: _____

