

12/17/84
3:30 P.M.
12/10/84
2 Sept

Septic Spn
Approved
12-10-84
S.Mel

PERMIT

P 34295
A 24173

SEWAGE DISPOSAL SYSTEM

MARYLAND STATE DEPARTMENT OF HEALTH*

HOWARD COUNTY
BUREAU OF ENVIRONMENTAL HEALTH
992-2330

ELLICOTT CITY
DISTRICT 3rd
DATE 8/30/84

INDEXED

Paul Schissler IS PERMITTED TO INSTALL ALTER

ADDRESS 4410 Salembottom Road, Westminster, MD 21157 PHONE 975-4197

SUBDIVISION Annandale ROAD 13374 Grinstead Road LOT 13, Sec. 2

PROPERTY OWNER Ronald F. Schrauder Kevin O'BRIEN
ADDRESS 4111 Buckingham Road
Rockvale, Maryland

IF GARBAGE GRINDER IS USED INCREASE SEPTIC TANK CAPACITY BY 50% AND ABSORPTION AREA BY 22%.

GARBAGE GRINDER? YES NO

SEPTIC TANK CAPACITY 1250 GALLONS NUMBER OF BEDROOMS 4

BLDG. PERMIT SIGNED
AND RETURNED 8/20/84
Serial # 60216 - SFD

Absorbant area per bedroom 140 sq. ft. Dry well inlet 2' - 4' below original grade. Maximum depth 7' - 10' below original grade. Absorbant area in dry well 288 sq. ft. Locate the dry well 130 feet from rear of lot. No more or less than 10 feet from lot 14. Trench inlet 3 feet below original grade. Maximum depth 9 feet and 70 feet long. Start the trench 28 feet from lot 14 and run on contour towards left rear lot. Call for two inspections - before and after gravel is installed.

JG. PERMIT SIGNED
AND RETURNED 12-1-98
Serial # 10115221
In Law Addition

BLDG. PERMIT SIGNED
AND RETURNED 8/19/92
Serial # 45066
addition -

PLANS APPROVED BY David J. O'Neill DATE 12/19/77

COVER NO WORK UNTIL INSPECTED AND APPROVED.

NEITHER THE HOWARD COUNTY COUNCIL NOR THE HEALTH DEPARTMENT IS RESPONSIBLE FOR THE SUCCESSFUL OPERATION OF ANY SYSTEM.

NOTE: IF TRENCH IS USED CALL FOR INSPECTION BEFORE AND AFTER PLACING GRAVEL IN TRENCH.

NOTE: NO DRY WELL SHALL EXCEED 15 FOOT IN DIAMETER. NO ABSORPTION TRENCH TO EXCEED 100 FEET IN LENGTH.

NOTE: ALL PIPE FROM HOUSE TO SEPTIC TANK MUST BE CAST IRON OR SCHEDULE 40 PVC OR ABS.

PERMIT VOID AFTER THREE YEARS.


NOTE: INSTALL STAND PIPE ON SEPTIC TANK AND DRY WELL. STAND PIPES MUST BE 6 INCHES IN DIAMETER. CAST IRON, CONCRETE OR TERRA COTTA, OR PVC OR ABS ACCEPTED. IF TOP OF SEPTIC TANK IS DEEPER THAN 3 FEET MANHOLE TO GRADE REQUIRED.

***INSTALLER IS RESPONSIBLE FOR OBTAINING FINAL APPROVAL ON THIS PERMIT**

*CALL 992-2330 FOR INSPECTION OF SEPTIC SYSTEMS.

EH - 2-1082

A
24173

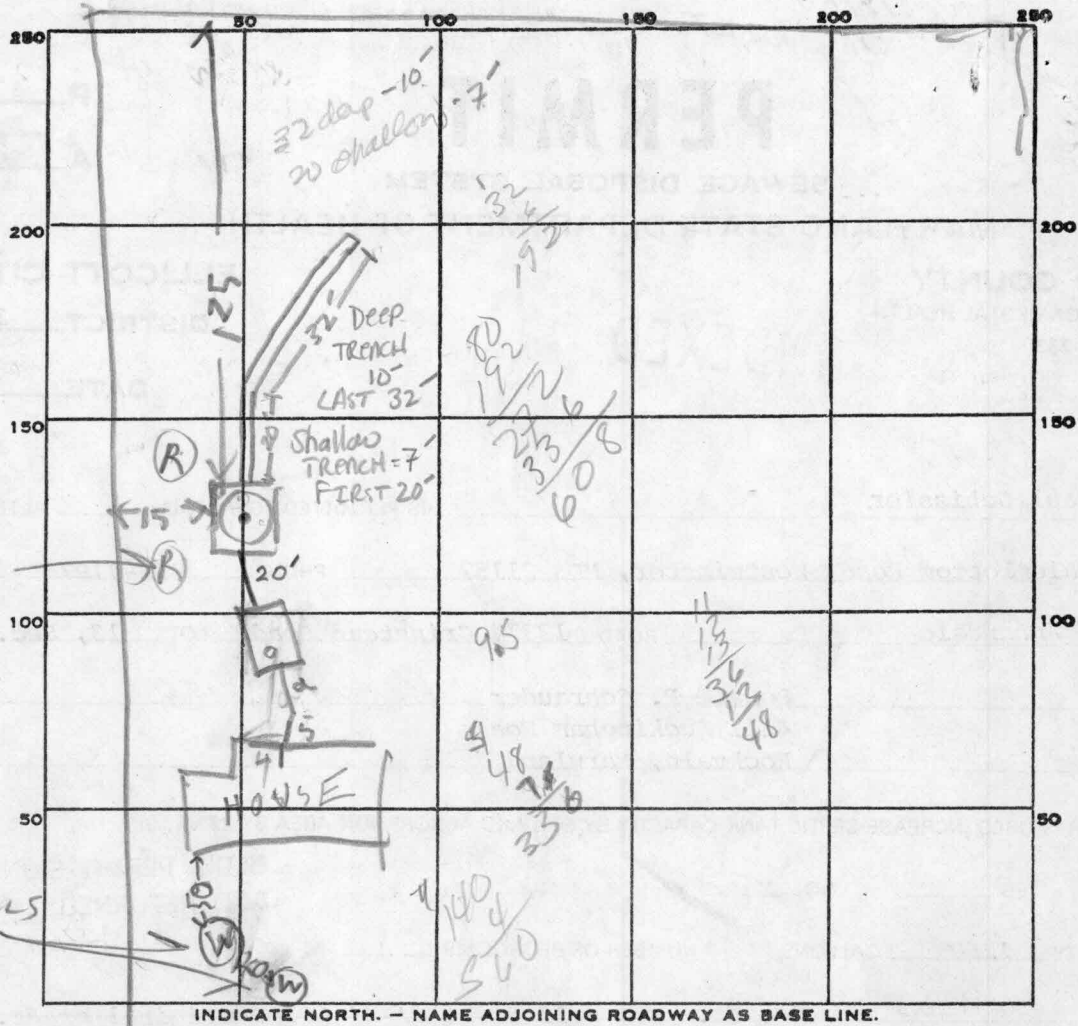

INDICATE NORTH. - NAME ADJOINING ROADWAY AS BASE LINE.

GRINSTEAD CT

PERMIT CARD

SEPTIC TANK, LEVEL OK 1500
 TOP 1 FT BELOW GRADE
 DISTRIBUTION BOX, LEVEL

CLEANOUTS OK

TILE FIELD, DEPTH 7-10 FT. TRENCH WIDTH 2 FT.

GRAVEL DEPTH 4-6 FT. TOTAL LENGTH 52 FT.

NUMBER OF TRENCHES 1 TOTAL BOTTOM AREA 272

dry well 336 ft²

SEEPAGE PITS, INSIDE DIAMETER 48 FT. DEPTH BELOW INLET 7 FT.

ABSORBENT AREA 608 SQ. FT.

REMARKS 12/7/84 - DW MOVED SLIGHTLY BECAUSE OF ROCK
DRY WELL HOLE 9 1/2 FT IS OK. COVER TANK
FINISH DW & DIG DITCH RH

DATE SYSTEM APPROVED

12-10-84

Site Alol