

10/19/99  
LATE

# PERMIT

## SEWAGE DISPOSAL SYSTEM

### DEPARTMENT OF HEALTH AND MENTAL HYGIENE

P 512734

A 58533A

DISTRICT \_\_\_\_\_

DATE 9-28-99

DATE SYSTEM APPROVED 10/19/99

INSPECTOR DKS

HOWARD COUNTY HEALTH DEPARTMENT

BUREAU OF ENVIRONMENTAL HEALTH

~~XXXXXXX~~ 410-313-2640

#325563

INDEXED

Jack Fyock Septic Service

IS PERMITTED TO INSTALL X ALTER \_\_\_\_\_

ADDRESS P.O. Box 89, Triadelphia Road, Glenelg, Maryland 21737 PHONE 410-988-9270

SUBDIVISION Buckskin Lake Overlook LOT 5 ROAD 13040 Folly Quarter Road

PROPERTY OWNER Rosemark Custom Homes - Robert & Donna Johnson

ADDRESS \_\_\_\_\_

#### TOP SEAMED TANK REQUIRED

SEPTIC TANK CAPACITY 1250 GALLONS

NUMBER OF BEDROOMS 4

180 SQUARE FEET PER BEDROOM

LINEAR FEET OF TRENCH REQUIRED 240

#### PUMPED SEPTIC SYSTEM REQUIRED

INSTALL: 1-1250 Gallon Top Seamed Pump Chamber

NOTES: - Septic pump detail to be provided by installer prior to issuance of septic permit.  
- Pump performance test is necessary prior to Health Department approval of pump septic system.

10/18/99  
Spoke to Jack Fyock - I confirmed that a pumped septic system is not required (see approved site plan)

TRENCHES - Trench to be 3 feet wide. Inlet 2.5 feet below original grade. Bottom maximum depth 4.5 feet below original grade. Effective area begins at 2.5 feet below original grade. 2 feet of stone below distribution pipe.

LOCATION - Starting from the intersection of the 54.82' and the 270.00' lot lines, place the distribution box 140 feet down the 270.00' line and 100 feet off this same lot line.

Run trenches on contour toward 608.45' lot line.

NOTES - No trench to exceed 100 feet in length. Provide 6" - 8" diameter cleanout and cap to grade or above on septic tank. 5/12/99 OK AU

PLANS APPROVED BY Mark Rifkin

DATE 5-03-1999

COVER NO WORK UNTIL INSPECTED AND APPROVED

NEITHER THE HOWARD COUNTY COUNCIL NOR THE HEALTH DEPARTMENT IS RESPONSIBLE FOR THE SUCCESSFUL OPERATION OF ANY SYSTEM

NOTE: CLEANOUT REQUIRED EVERY 70 FEET OF SEWER LINE AND/OR AT 90° SWEEPS IN LINES FROM HOUSE TO DRAIN FIELDS. 90° ELBOWS NOT ACCEPTABLE.

NOTE: ALL PARTS OF SEPTIC SYSTEMS (I.E. TANK, DISTRIBUTION BOX TRENCHES) TO BE 100 FEET FROM WELL (UNLESS OTHERWISE SPECIFICALLY AUTHORIZED)

NOTE: IF DEEP TRENCH(ES) ARE USED CALL FOR INSPECTION BEFORE AND AFTER PLACING GRAVEL IN TRENCH(ES)

NOTE: NO DRY WELL SHALL EXCEED 15 FOOT IN DIAMETER NO ABSORPTION TRENCH TO EXCEED 100 FEET IN LENGTH

NOTE: ALL PIPE FROM HOUSE TO SEPTIC TANK MUST BE CAST IRON OR SCHEDULE 35/40 PVC OR ABS

PERMIT VOID AFTER TWO YEARS

NOTE: INSTALL STAND PIPE ON SEPTIC TANK AND DRY WELL STAND PIPES MUST BE 6 INCHES IN DIAMETER CAST IRON, CONCRETE OR TERRA COTTA OR PVA OR ABS ACCEPTED. IF TOP OF SEPTIC TANK IS DEEPER THAN 3 FEET, MANHOLE TO GRADE REQUIRED.

NOTE: DISTRIBUTION BOXES MUST HAVE BAFFLES

OLD PERMIT SIGNED AND RETURNED 7/30/01  
300131691-2 decks, no steps


OLD PERMIT SIGNED AND RETURNED 12-27-99  
Serial # 121863

Retaining Wall

\*INSTALLER IS RESPONSIBLE FOR OBTAINING FINAL APPROVAL ON THIS PERMIT

\*CALL 461-9933 FOR INSPECTION OF SEPTIC SYSTEM.

NOT TO SCALE

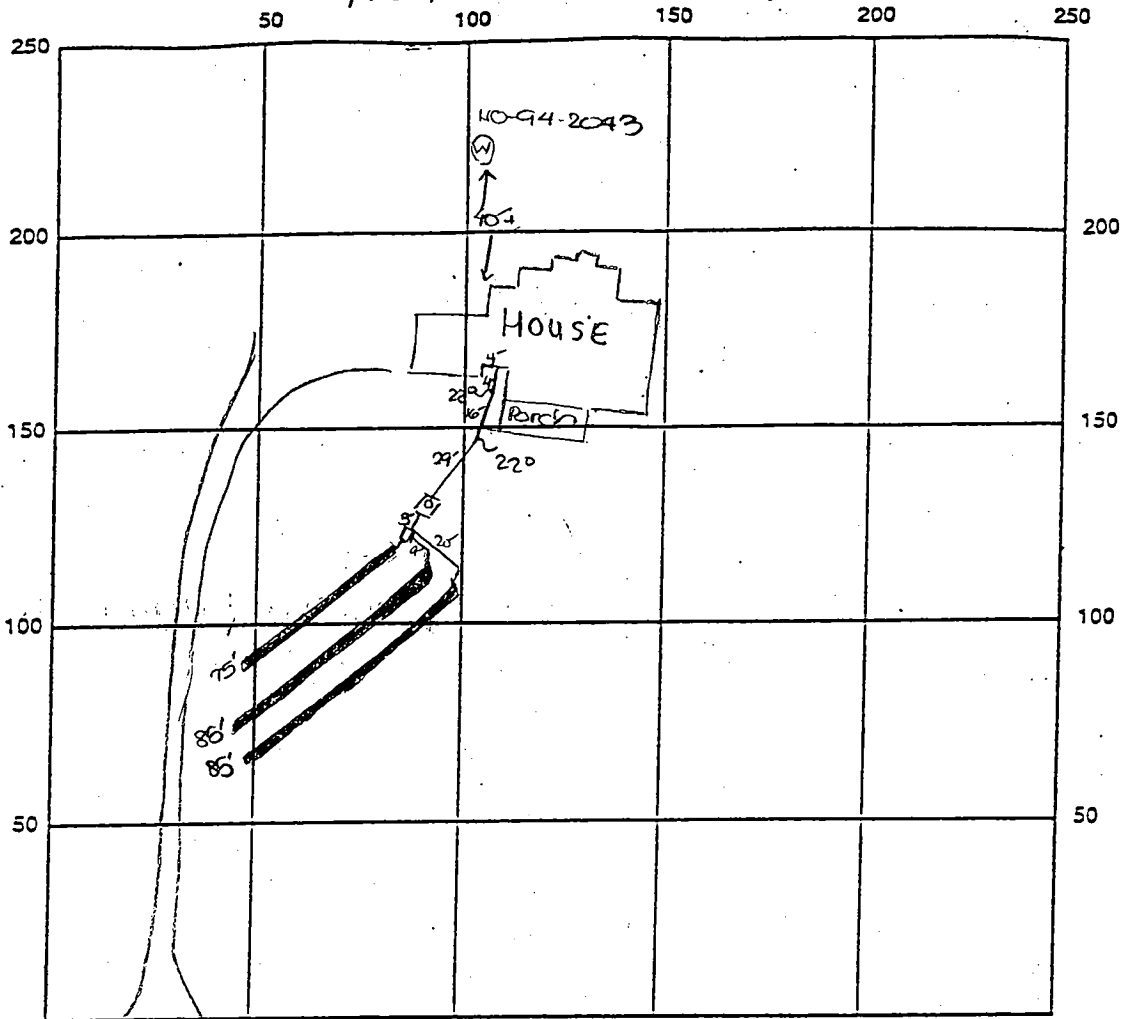

INDICATE NORTH - NAME ADJOINING ROADWAY AS BASE LINE

Folly Quarter Road

SEPTIC TANK LEVEL OK - 1250 gal top sealed CLEANOUTS one on site

DISTRIBUTION BOX LEVEL OK - w/levelers

TILE DRAIN FIELD/TILE DEPTH 4.5 FT. TRENCH WIDTH 3 FT. INLET DEPTH 2.5 FT.

EFFECTIVE GRAVEL DEPTH 2 FT. TOTAL LENGTH 2x85' FT. → 240'

NUMBER OF TRENCHES 3 ~~ONE SIDEWALL~~ BOTTOM AREA 720 SQ. FT.

DRYWELL DRYWALL INSIDE DIAMETER \_\_\_\_\_ FT. EFFECTIVE DEPTH BELOW INLET \_\_\_\_\_ FT.

ABSORBENT AREA \_\_\_\_\_ SQ. FT.

REMARKS: 10/19/99 FINAL INSP - OK TO COVER ALL SEPTIC WORK. DKS

10/21/99 WPI - No INSP sheet - Pitless adaptor 3.5' below grade - PVC conduit 18" below grade - 2 piece cap - OK to cover

DATE SYSTEM APPROVED 10/19/99 INSPECTOR [Signature]

