

7/14/01
4/18/01
4/19/01
PM

PERMIT

SEWAGE DISPOSAL SYSTEM
HOWARD COUNTY HEALTH DEPARTMENT
BUREAU OF ENVIRONMENTAL HEALTH
410-313-2640

P 515040-A

A 57610-Y

ISSUE DATE 4/12/2001

APPROVAL DATE 4/19/01

INDEXED
04-362969

Whitworth Excavating IS PERMITTED TO INSTALL ALTER

ADDRESS 12680 Clarksville Pike, Clarksville, MD 21029 PHONE 410-531-5033

SUBDIVISION Spring Hollow LOT NUMBER 22 ADDRESS 1225 Haleys Court

PROPERTY OWNER Catoctin Homes Inc PROPERTY OWNER'S ADDRESS P.O. Box 512, EC 21041

SEPTIC TANK CAPACITY 1500 GALLONS * TOP SEAMED SEPTIC TANK REQUIRED *

PUMP CHAMBER CAPACITY N/A GALLONS

NUMBER OF BEDROOMS 5

SQUARE FEET PER BEDROOM 180

LINEAR FEET OF TRENCH REQUIRED 300

TRENCHES: Trenches to be 3 feet wide. Inlet 4 feet below original grade. Bottom maximum depth
6 feet below original grade. 2 feet of stone below distribution box pipe

LOCATION: Starting from the intersection of the 178.97'/306.22' lot lines, place the
distribution box 95 feet down the 306.22' lot line and 120 feet off this same lot line.
Run (3) trenches on contour toward the 306.22' lot line. 1/10/01 OK (BB)

SEE WELL LINE LOCATION HIGHLIGHTED ON
ATTACHED PLAN (SLEEVED UNDER DRIVEWAY)

PLANS APPROVED Mark Rifkin, R.S. DATE 1/9/2001

PERMIT VOID AFTER 2 YEARS

NOTE: CONTRACTOR RESPONSIBLE FOR SCHEDULING A PRE-CONSTRUCTION INSPECTION FOR ALL INSTALLATIONS

NOTE: TOP OF SEPTIC TANKS ARE TO BE NO DEEPER THAN 3.0 FEET BELOW FINISH GRADE

NOTE: WATERTIGHT SEPTIC TANKS REQUIRED

NOTE: CLEANOUT REQUIRED EVERY 70 FEET OF SEWER LINE AND/OR AT 90° SWEEPS IN LINES FROM HOUSE TO DRAIN FIELDS, 90° ELBOWS ARE NOT ACCEPTABLE

NOTE: ALL PARTS OF SEPTIC SYSTEMS (I.E. TANK, DISTRIBUTION BOX, DRAINFIELDS) TO BE 100 FEET FROM ANY WATER WELL UNLESS OTHERWISE SPECIFICALLY AUTHORIZED

NOTE: NO ABSORPTION TRENCH TO EXCEED 100 FEET IN LENGTH UNLESS SPECIFICALLY AUTHORIZED

NOTE: ALL PIPE FROM HOUSE TO SEPTIC TANK MUST BE CAST IRON OR SCHEDULE 35/40 PVC OR ABS

NOTE: MANHOLE RISERS REQUIRED ON ALL SEPTIC TANKS AND PUMP CHAMBERS

NOTE: DISTRIBUTION BOXES MUST HAVE BAFFLES

NOTE: IF PUMPED SEPTIC SYSTEM REQUIRED, (1) SEPTIC PUMP DETAIL TO BE PROVIDED BY INSTALLER PRIOR TO ISSUANCE OF SEPTIC PERMIT (2) PUMP PERFORMANCE TEST IS NECESSARY PRIOR TO HEALTH DEPARTMENT APPROVAL OF SEPTIC PERMIT


BLDG. PERMIT SIGNED
AND RETURNED 10/11/01
B00132776 - deck w/stairs &

BLDG. PERMIT SIGNED
AND RETURNED 10/2/01
B00132429 Installation
of 1000 gal underground
lp tank

NEITHER THE HOWARD COUNTY COUNCIL NOR THE HEALTH DEPARTMENT IS RESPONSIBLE FOR THE
SUCCESSFUL OPERATION OF ANY SYSTEM
PERMITTEE RESPONSIBLE FOR OBTAINING FINAL APPROVAL ON THIS PERMIT
CALL 410-313-2640 FOR INSPECTION OF SEPTIC SYSTEM

PERMIT

NOT TO SCALE

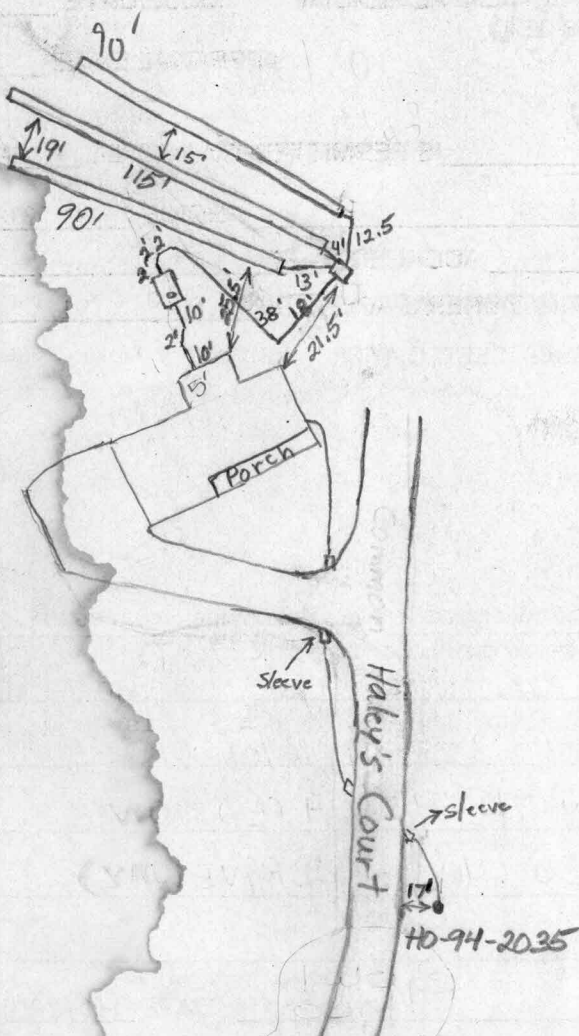

TRENCH DATA

TRENCH WIDTH 3
 TRENCH INLET DEPTH 4
 TRENCH BOTTOM DEPTH 60
 DEPTH OF STONE 2
 NUMBER OF TRENCHES 3
 TOTAL TRENCH LENGTH 295
 ABSORBENT AREA 885
 DISTRIBUTION BOX LEVEL Yes
 BAFFLE IN DISTRIBUTION BOX

SEPTIC TANK DATA

SEPTIC TANK 1500 TS GALLONS
 MANHOLE RISER _____
 6 INCH INSPECTION PORT

PUMP CHAMBER DATA

~~PUMP CHAMBER GALLONS _____
 MANHOLE RISER _____
 ALARM _____
 PUMP PERFORMANCE TEST _____~~

PRE-CONSTRUCTION INSPECTION: 4/12/01 layout confirmed - SDA staked - OK to install system as specified. DKC

INSPECTION COMMENTS: 4/17/01 P.M. Installer to use transit to check trench grades to assure proper installation. DKC 4/18/01 O.K. to cover first two trenches. Told installer that trenches have to be closer in future systems, regardless of trees. (BB) 4/19/01 S.T. C/O ~ 1/2' FROM S.T. EDGE; OK TO FINISH TRENCH, ADD D.B. BAFFLE & COVER (MR)

INSPECTOR M. Reifkin DATE SYSTEM APPROVED 4/19/01