

APPLICATION

PERCOLATION TESTING

A _____

P _____

HOWARD COUNTY HEALTH DEPARTMENT
BUREAU OF ENVIRONMENTAL HEALTH
PO BOX 476 ELLICOTT CITY, MARYLAND 21043
TELEPHONE 461-9933

DISTRICT _____

DATE _____

TO: THE COUNTY HEALTH OFFICER
ELLICOTT CITY, MARYLAND

I, HEREBY, APPLY FOR THE NECESSARY TEST IN ORDER TO CONSTRUCT (OR RECONSTRUCT) A SEWAGE DISPOSAL SYSTEM.

PROPERTY OWNER Lambert Cissel

ADDRESS 3425 Hipsley Mill Road, Woodbine, MD 21797 PHONE (410) 442-5671

PROSPECTIVE BUYER Developer, Land Marketing Consultants, Inc., Timothy W. Feaga

ADDRESS 3243 Bethany Lane, Ellicott City, MD 21042 PHONE (410) 313-8808

PROPERTY LOCATION:

SUBDIVISION Cissel Property LOT NO 23

ROAD AND DESCRIPTION Intersection of Hardy & St. Michael's Road

TAX MAP 7 PARCEL # 394, 4, 341, 144

SIZE OF LOT 1 Acre TYPE BLDG _____
(SINGLE FAMILY DWELLING OR COMMERCIAL)

THE SYSTEM INSTALLED UNDER THIS APPLICATION IS ACCEPTABLE ONLY UNTIL PUBLIC FACILITIES BECOME AVAILABLE. I FULLY UNDERSTAND THE

FEE CONNECTED WITH THE FILING OF THIS PERC TEST APPLICATION IS NON-REFUNDABLE UNDER ANY CIRCUMSTANCES. I ALSO AGREE TO COMPLY

WITH ALL M.O.S.H.A. REQUIREMENTS IN TESTING THIS LOT. Willis Lambert Cissel JR
(SIGNATURE OF APPLICANT)

APPROVED BY _____ FOR _____ DATE _____

REJECTED BY _____ FOR _____ DATE _____

HOLD PENDING FURTHER TESTS _____ DATE _____

REASONS FOR REJECTION OR HOLDING _____

THIS IS NOT A PERMIT

HD-216

COUNTY #

SOIL PROFILE

521

bright orange silclm

2.0

pink to orange silm <5% pockets of saprolite white quartz

20

519

bright orange silclm

2

dk orange silm

5% shale

8

yel tan sisalm

5% shale

12

645


dk orange silclm

2

pink sisalm

20% saprolite

2

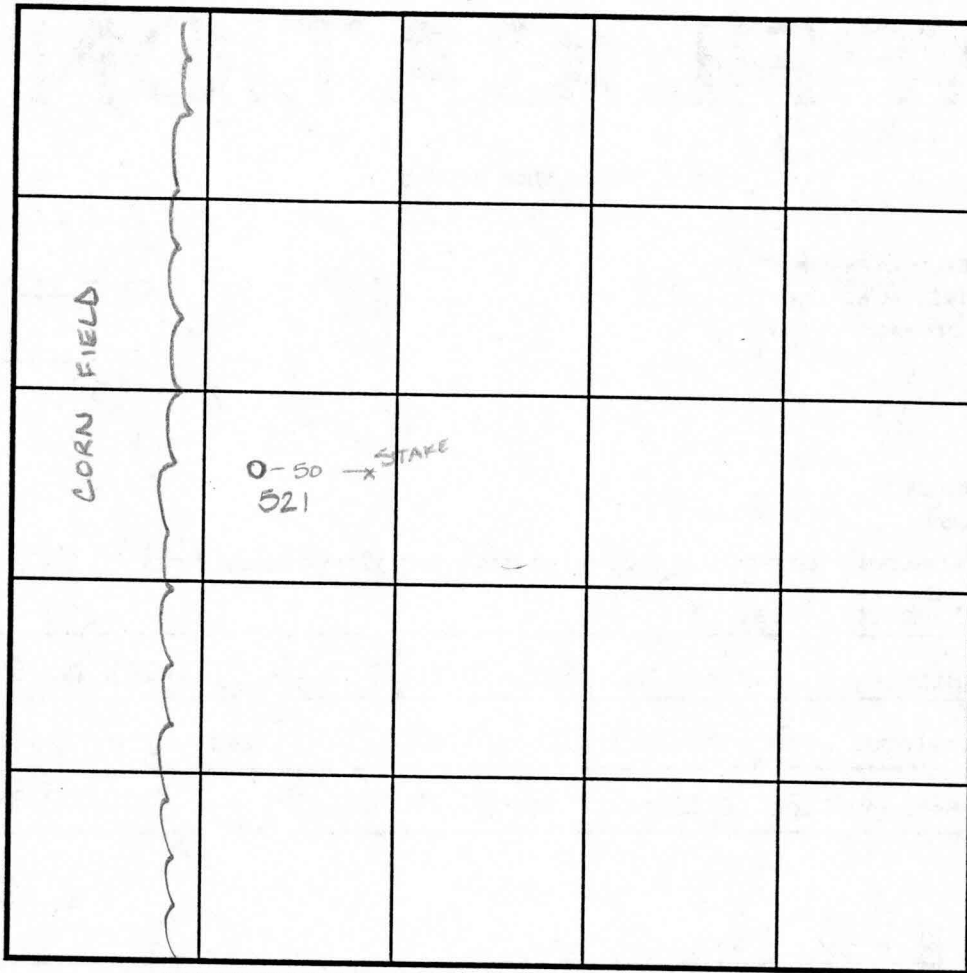

INDICATE NORTH - NAME ADJOINING ROADWAY AS BASE LINE.

520

SOIL PROFILE

0'

bright orange silclm

1.5

20% saprolite pink to yel sisalm

12

DATE	TEST NO.	DEPTH	PRE-WET		TEST - 1" DROP		TIME
			START	STOP	START	STOP	
8-23-96	521	3.5 / 12.0	Visual	to 12.0	-sec	profik	OK
	519	4 / 12.5					3
	519	7 / 12					2
	645	3 / 12					3
	520	4 / 12					2


REMARKS _____


TYPE OF SOIL _____

TESTED BY _____ ALSO PRESENT _____

TRENCH DESIGN DATA: AVERAGE PERCOLATION TIME _____ TRENCH WIDTH _____

INLET DEPTH _____ MAXIMUM BOTTOM DEPTH _____ SQ. FT./BEDROOM _____

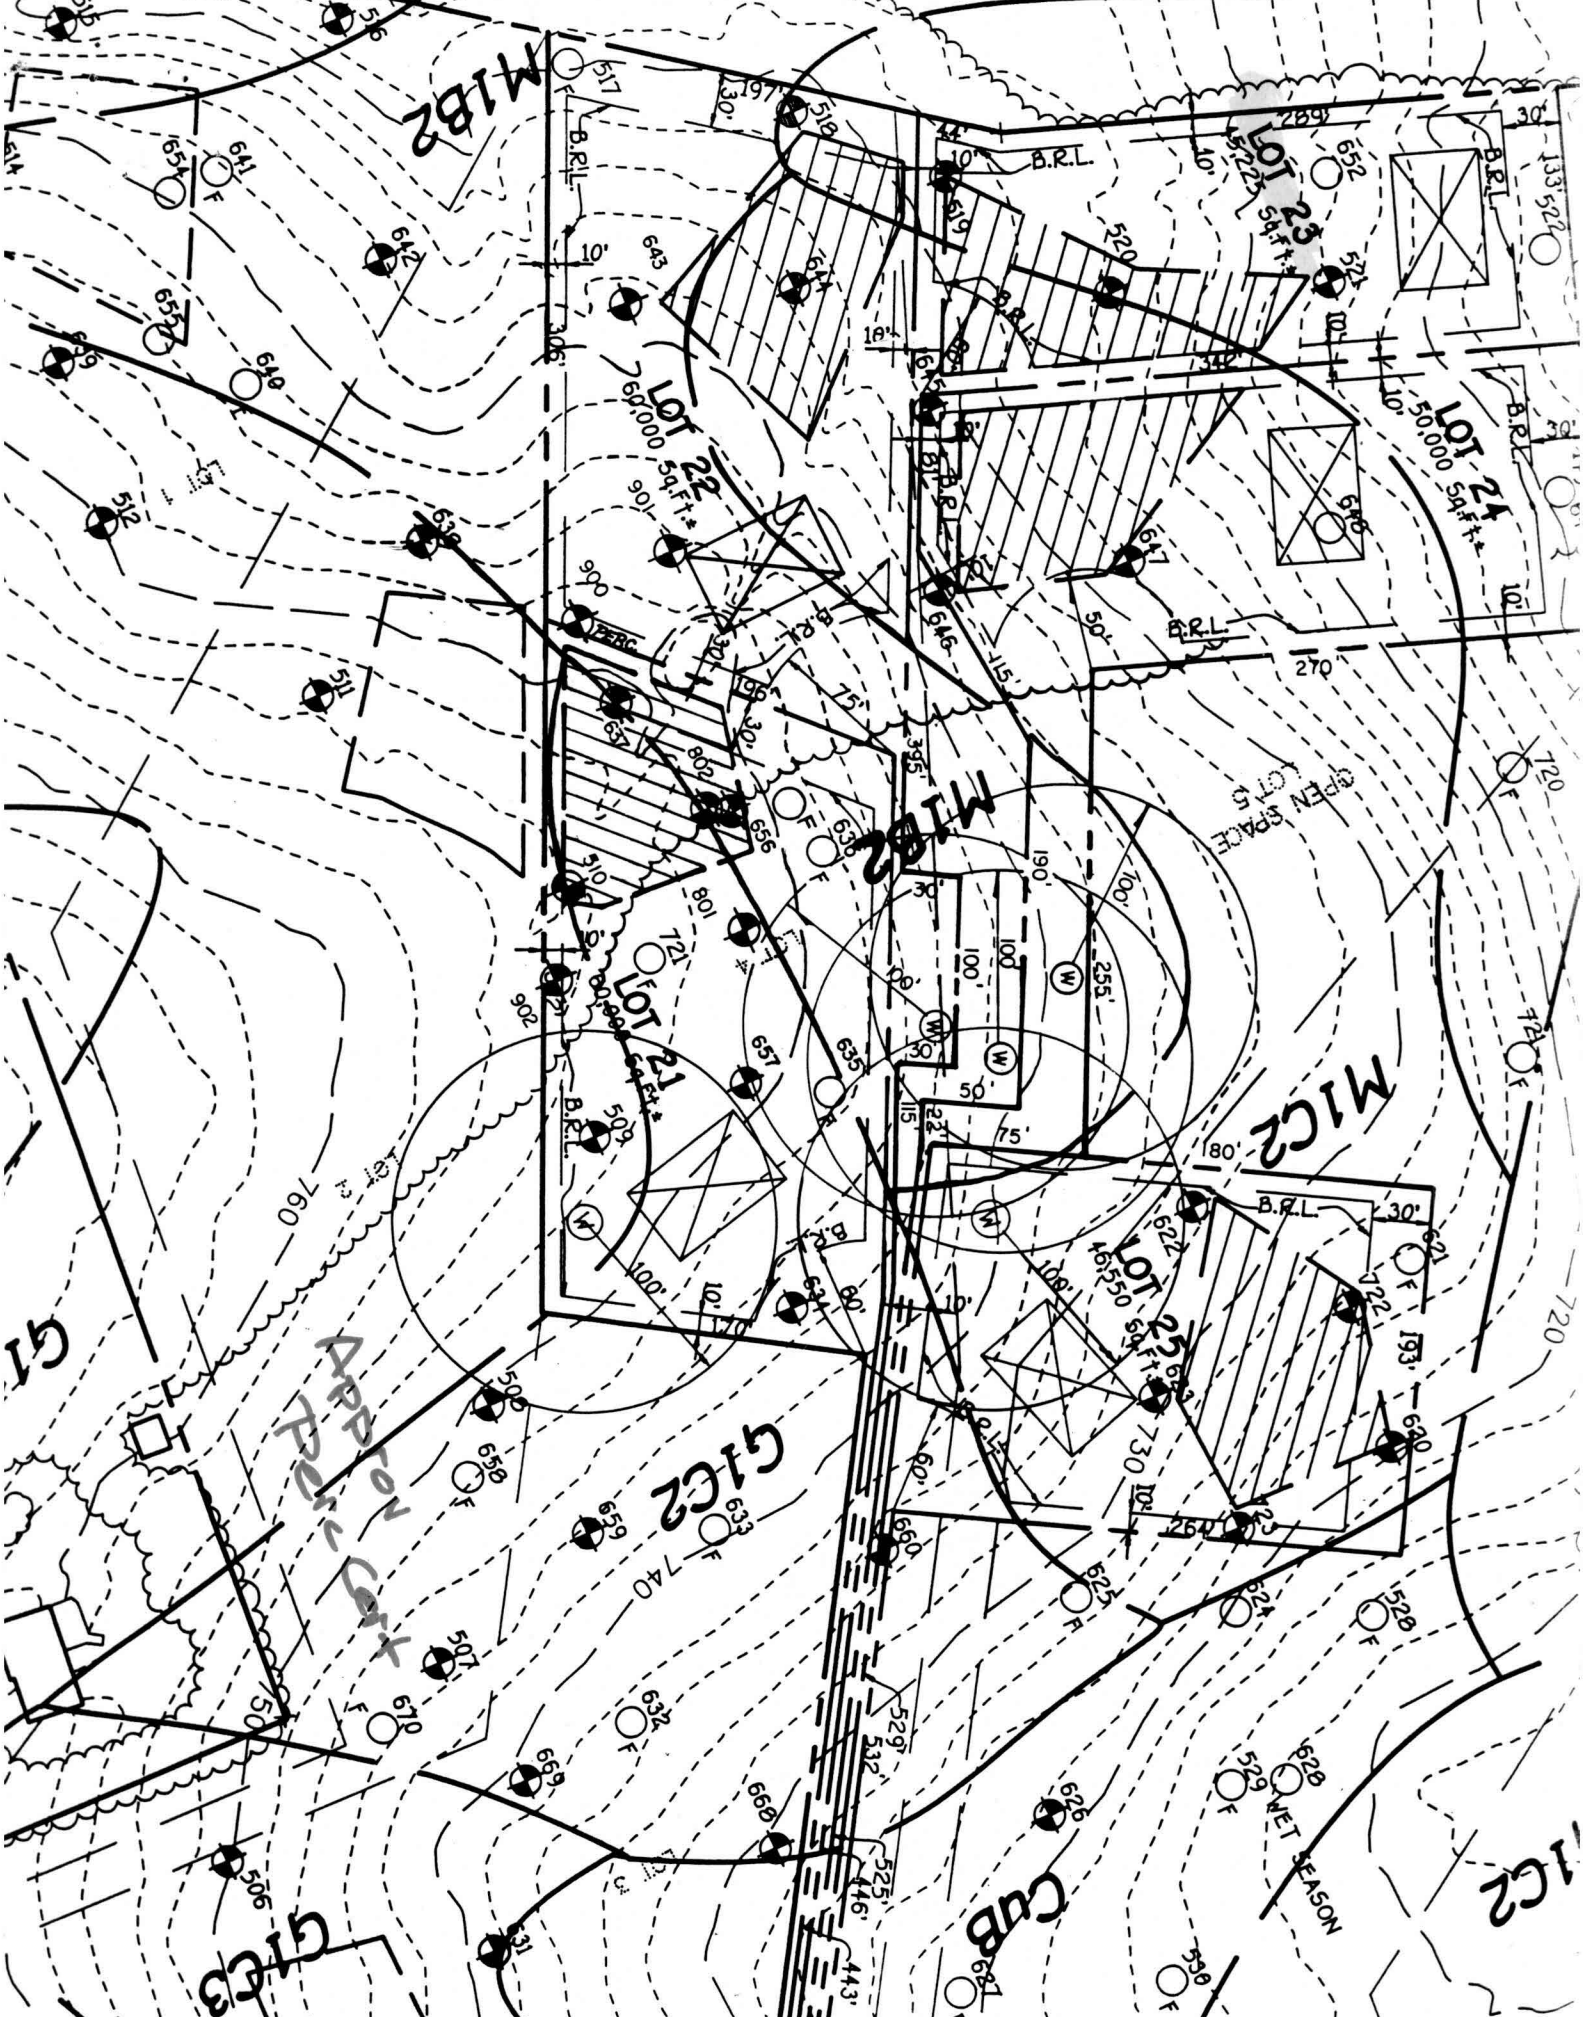

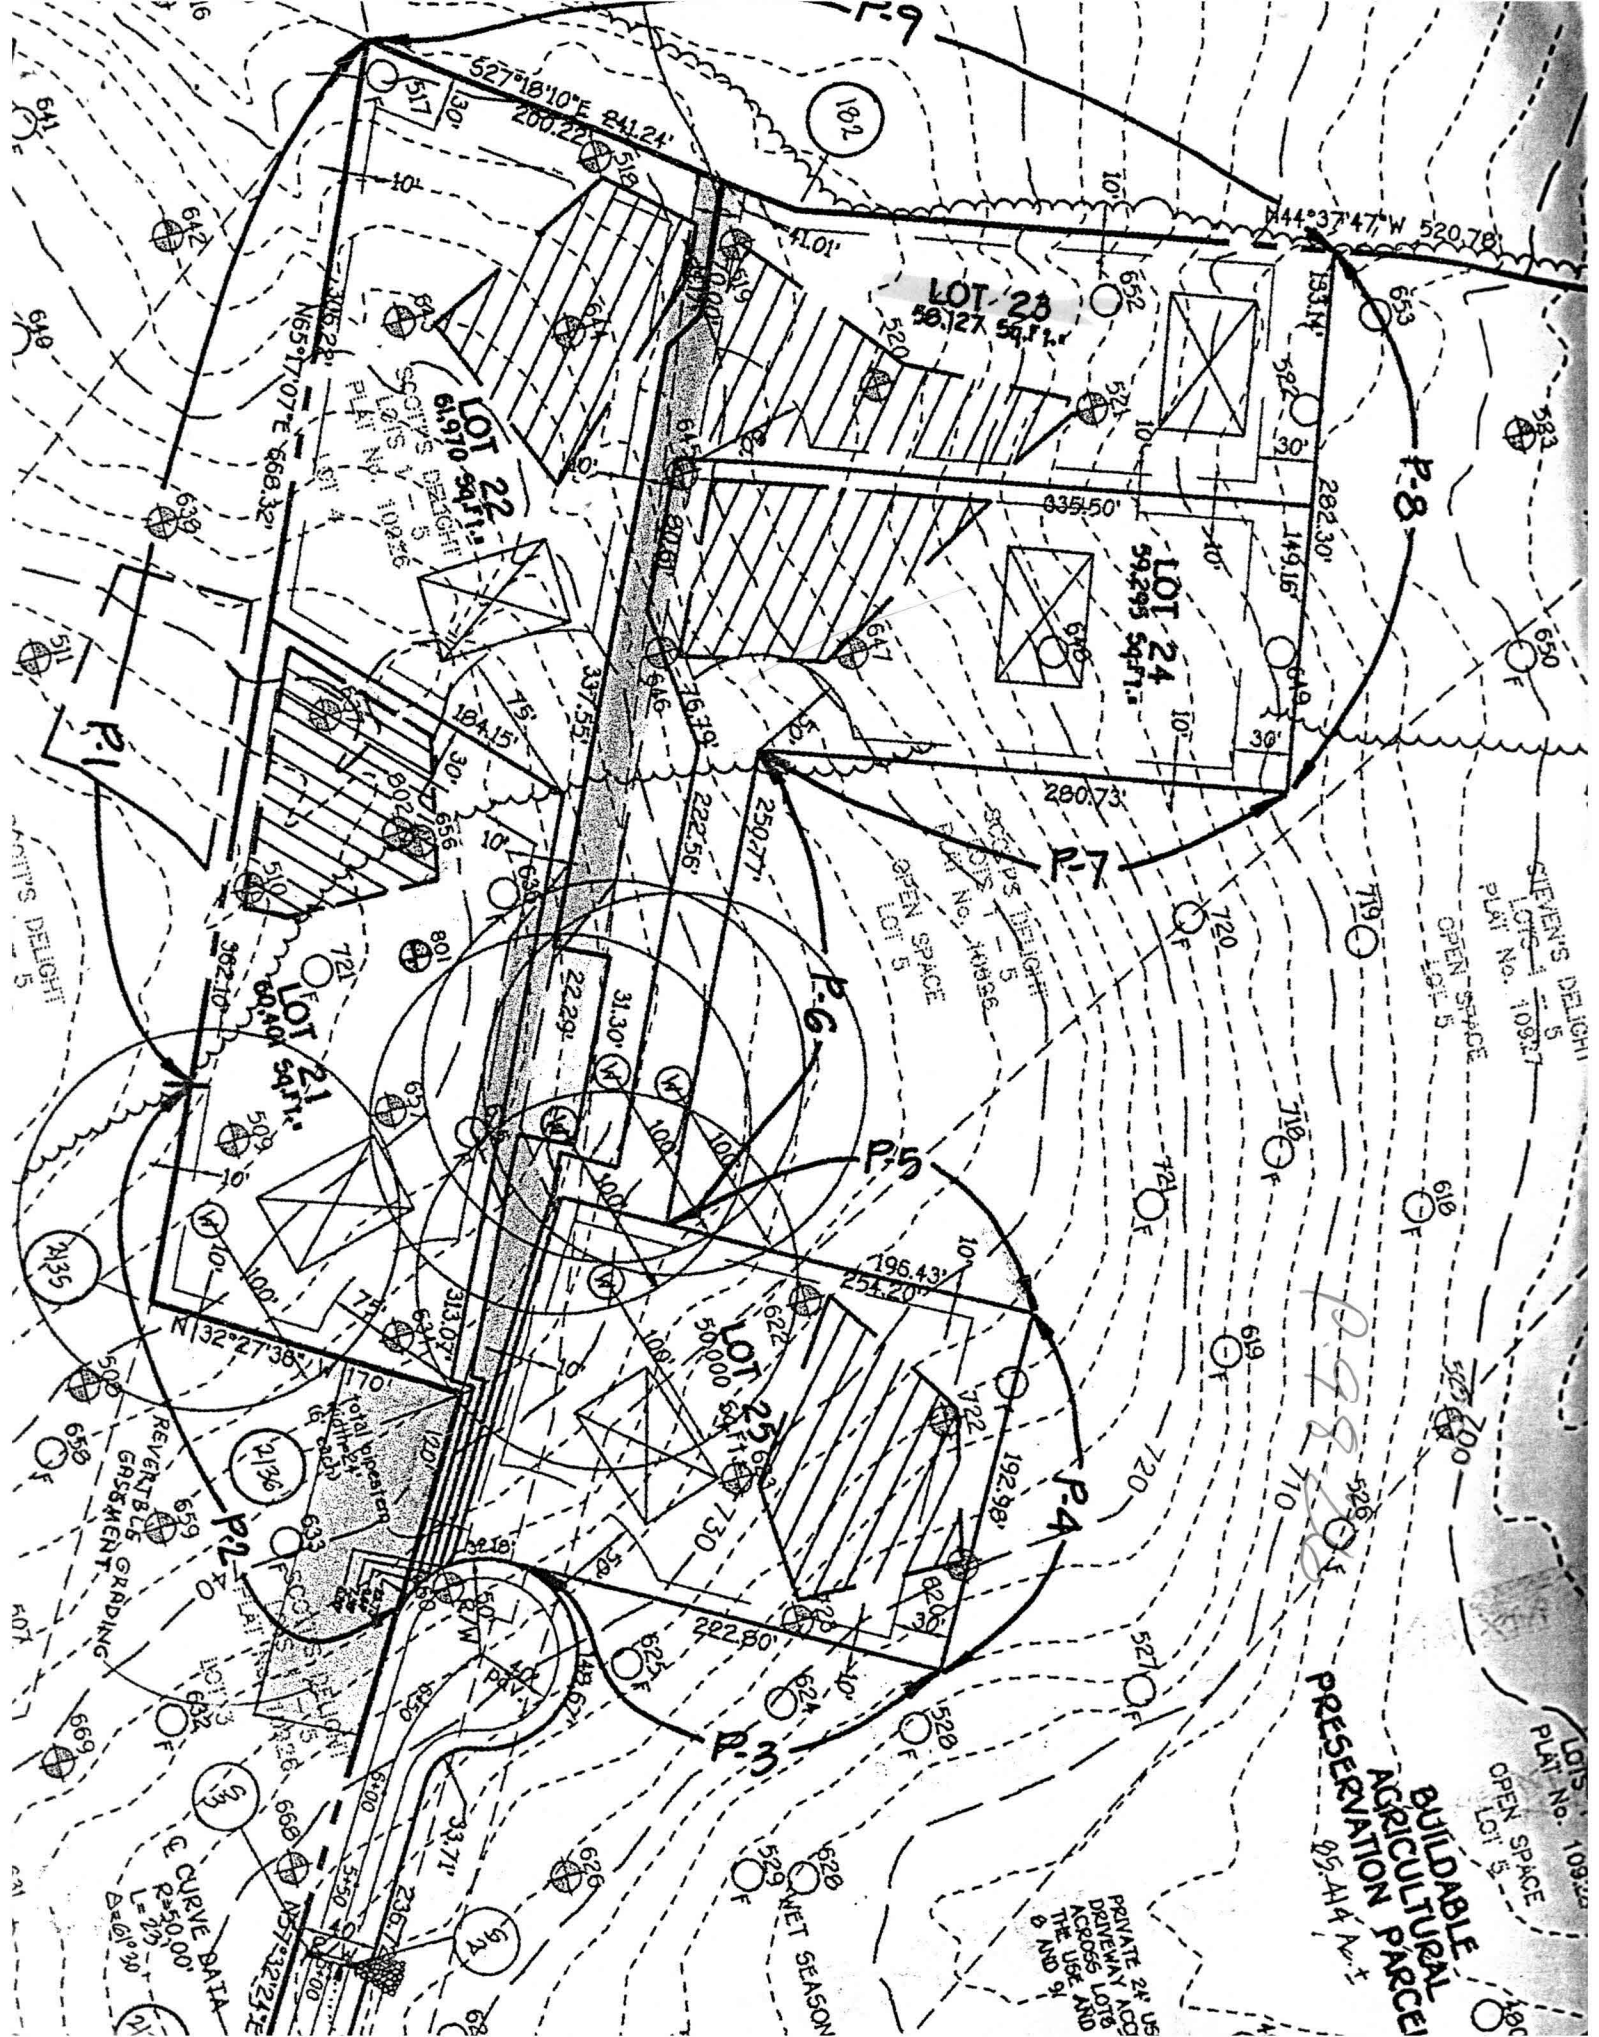

BUILDABLE AGRICULTURAL PRESERVATION PARCEL
PLAN No. 10927
OPEN SPACE LOT 5
95-414 N.T.

US PRIVATE 24' ACC
DRAINAGE LOT 6
DITCHES 655
ACCESS AND
THE USE 91
AND 91

REVERTIBLE GRASSMANT

CURVE DATA
L=200'
R=5000'
D=60°30'

SCOTT'S DELIGHT
PLAN No. 10926

SCOTT'S DELIGHT
PLAN No. 10926


SCOTT'S DELIGHT
PLAN No. 10926

SCOTT'S DELIGHT
PLAN No. 10926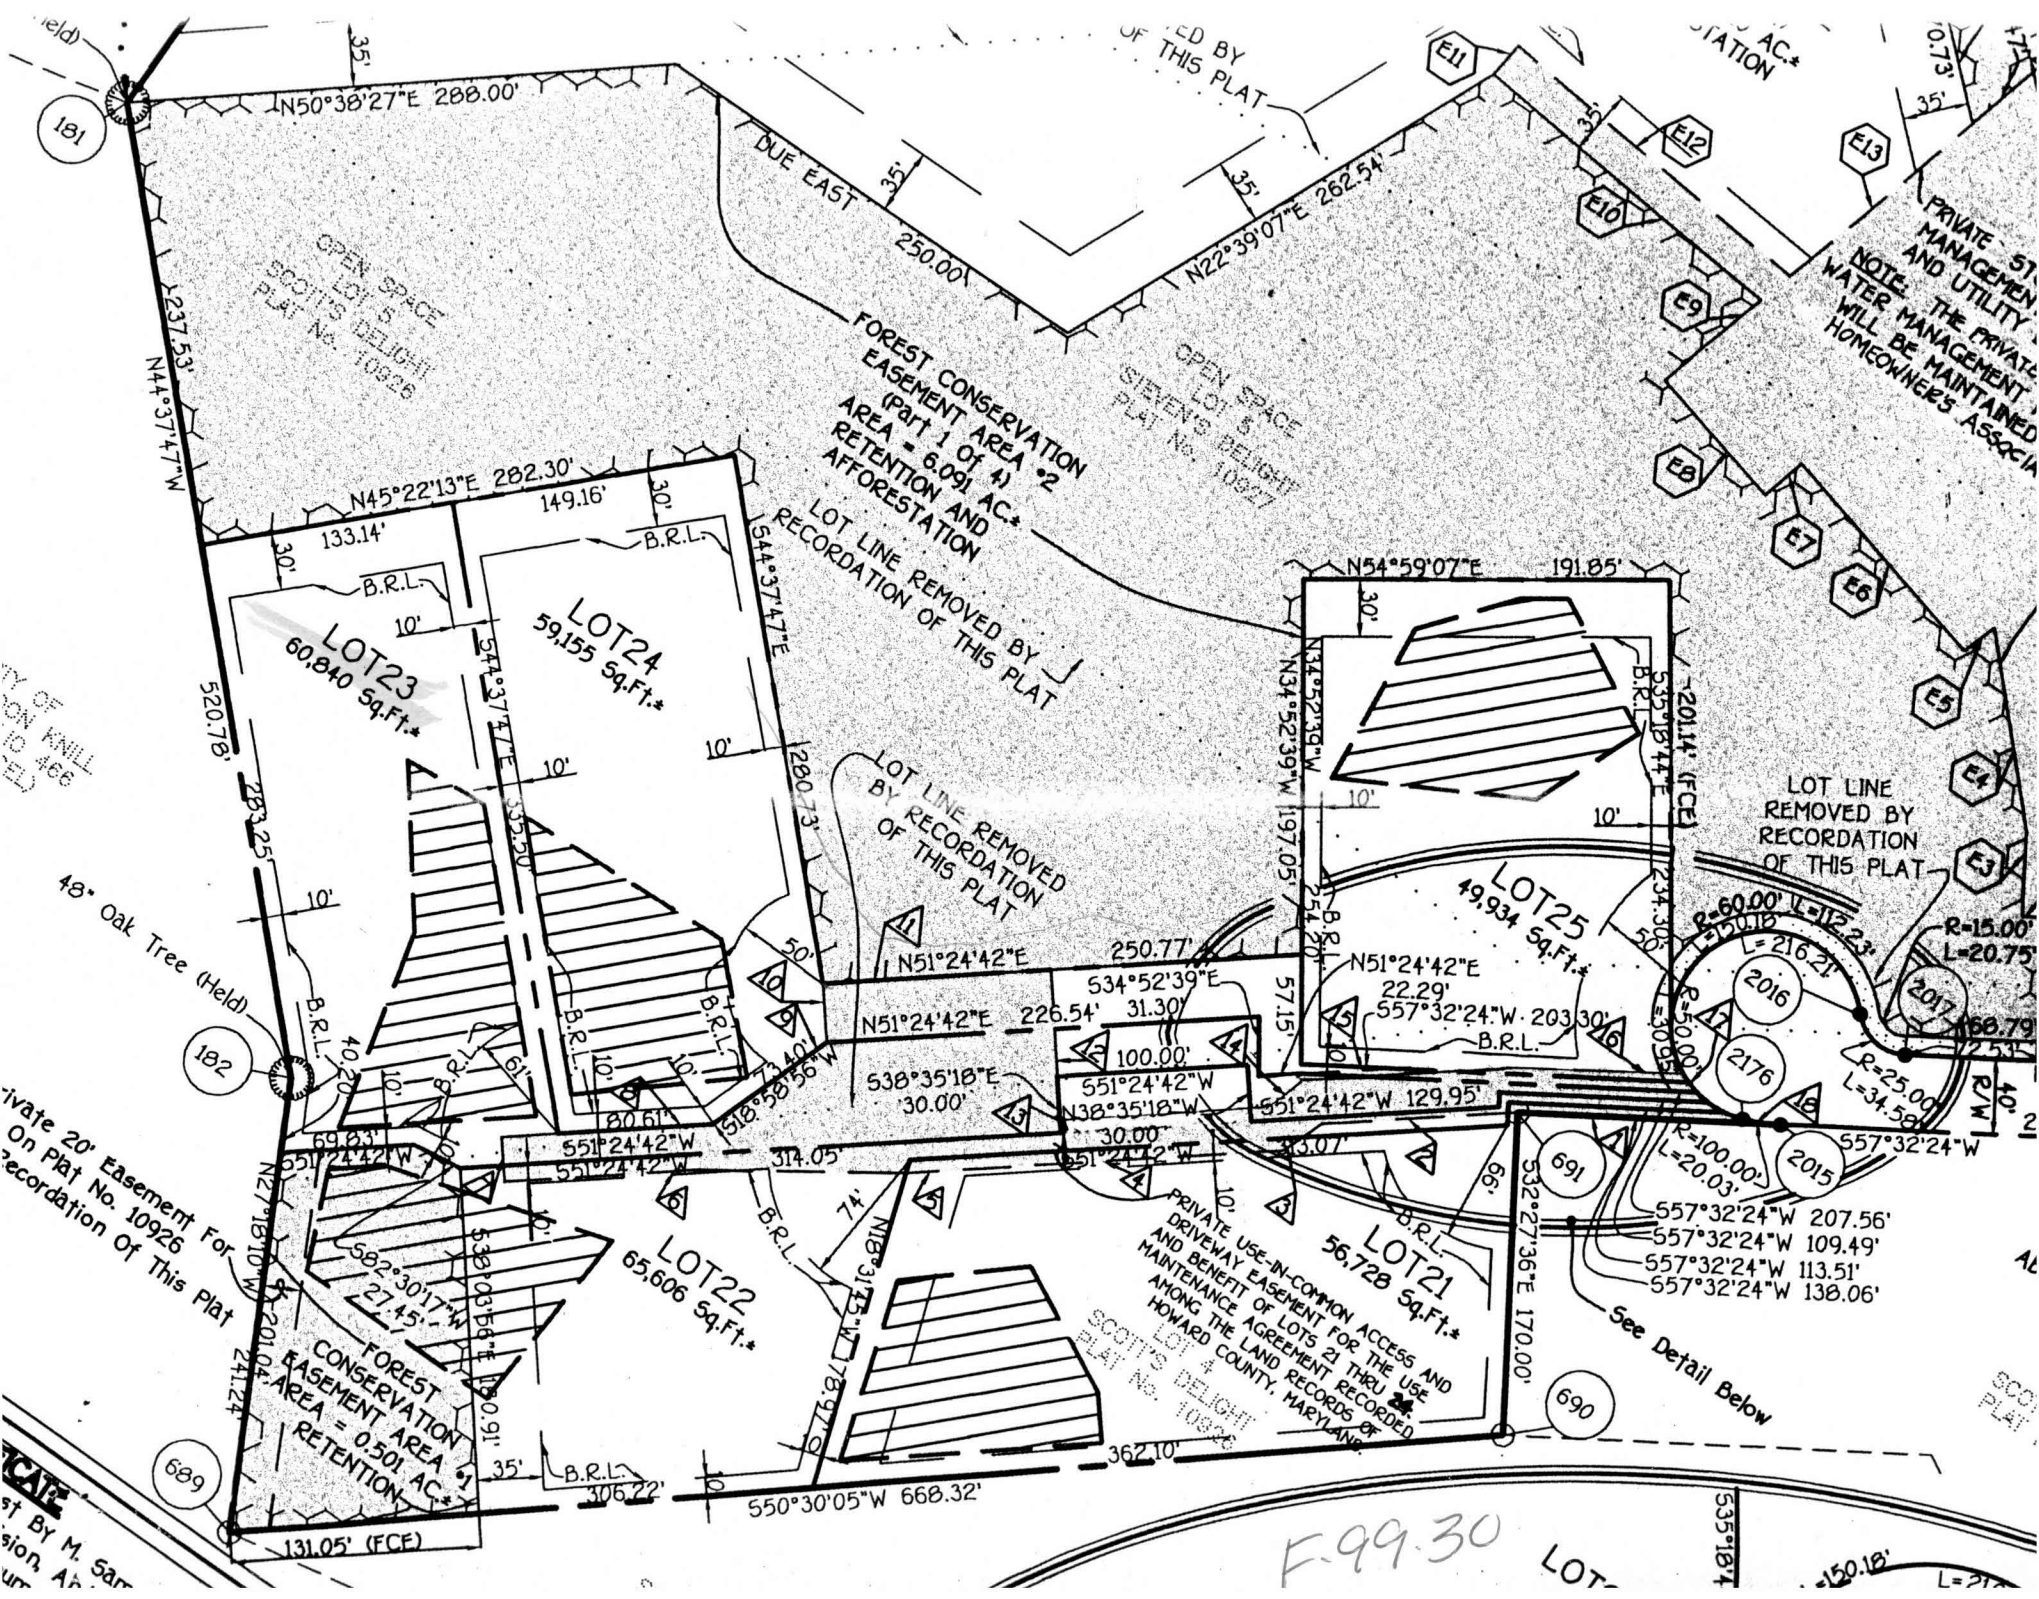

N50°38'27"E 288.00'

DUE EAST 250.00'

ED BY
OF THIS PLAT

AC*
STATION

OPEN SPACE
SCOTT'S DELIGHT
PLAT No. 10926

FOREST CONSERVATION
EASEMENT AREA #2
(PART 1 OF 4)
AREA = 6.091 AC*
RETENTION AND
AFFORESTATION


OPEN SPACE
STEVENS DELIGHT
PLAT No. 10927

PRIVATE ST
MANAGEMENT
AND UTILITY
NOTE: THE PRIVATE
WATER MANAGEMENT
WILL BE MAINTAINED
HOMEOWNERS ASSOCIATION

LOT 23
60,840 Sq.Ft.*

LOT 24
59,155 Sq.Ft.*

LOT LINE REMOVED BY
RECORDATION
OF THIS PLAT

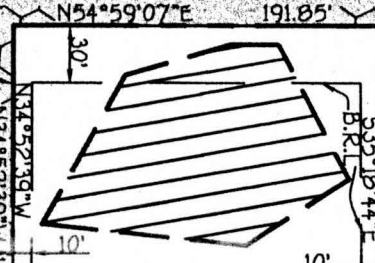

LOT 25
49,934 Sq.Ft.*

LOT LINE REMOVED BY
RECORDATION
OF THIS PLAT

CITY OF KNILL
PLAT No. 466
HELD


48" Oak Tree (Held)

Private 20' Easement For
On Plat No. 10926
Recordation of This Plat

FOREST
CONSERVATION
EASEMENT AREA
AREA = 0.501 AC*
RETENTION

PRIVATE USE-IN-COMMON ACCESS AND
DRIVEWAY EASEMENT FOR THE USE
AND BENEFIT OF LOTS 21 THRU 25
MAINTENANCE OF THE AGREEMENT RECORDED
AMONG THE LAND RECORDS OF
HOWARD COUNTY, MARYLAND

LOT 21
56,728 Sq.Ft.*

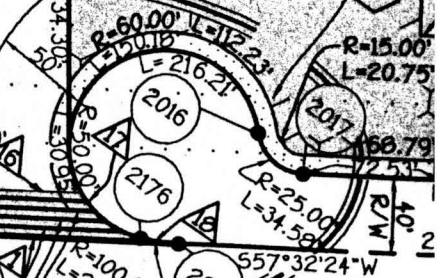

See Detail Below


BY M. Sar
Division, Ar

F-99-30

LOT

150.18'

L=21

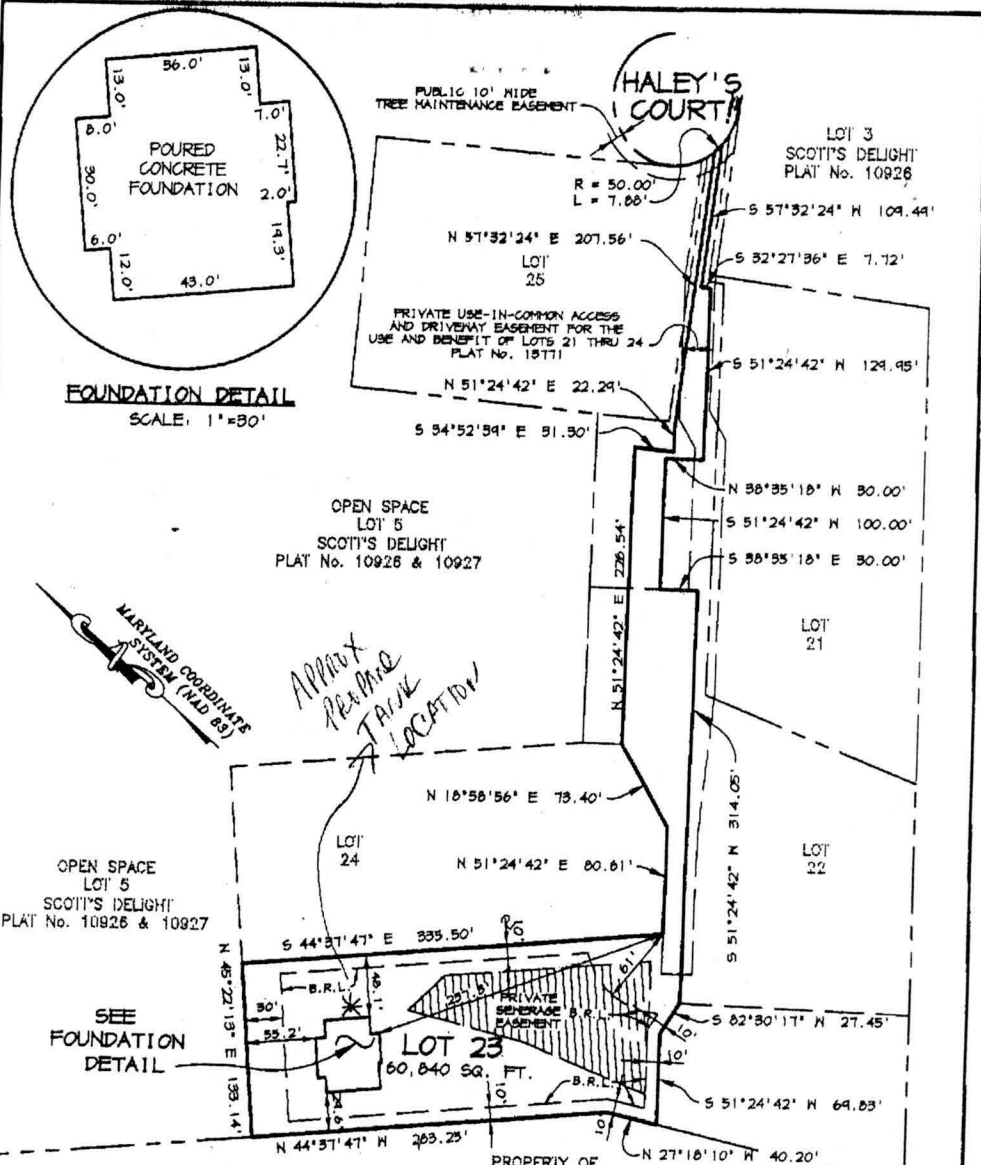

FOUNDATION DETAIL
SCALE: 1"=30'




OPEN SPACE
LOT 5
SCOTT'S DELIGHT
PLAT No. 10926 & 10927

SEE
FOUNDATION
DETAIL

TOP FOUNDATION ELEVATION = 717.6'
B.R.L. DENOTES BUILDING RESTRICTION LINE
PROPERTY OF CHARLES GORIXON KNILL
L. 346, F. 466
(SECOND PARCEL)

- NOTE:
- THIS PLAT IS OF BENEFIT TO A CONSUMER ONLY INsofar AS IT IS REQUIRED BY A LENDER OR A TITLE COMPANY OR ITS AGENT IN CONNECTION WITH CONTEMPLATED TRANSFER, FINANCING, OR RE-FINANCING;
 - THE PLAT IS NOT TO BE RELIED UPON FOR THE ESTABLISHMENT OR LOCATION OF FENCES, GARAGES, BUILDINGS, OR OTHER EXISTING OR FUTURE IMPROVEMENTS; AND
 - THE PLAT DOES NOT PROVIDE FOR THE ACCURATE IDENTIFICATION OF PROPERTY BOUNDARY LINES, BUT SUCH IDENTIFICATION MAY NOT BE REQUIRED FOR THE TRANSFER OF TITLE.

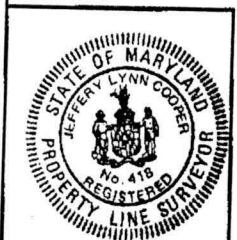

THIS IS TO CERTIFY THAT I HAVE SURVEYED THE PROPERTY SHOWN HEREON FOR THE PURPOSE OF LOCATING THE IMPROVEMENTS ON SAID PROPERTY AND THAT THE IMPROVEMENTS ARE LOCATED AS SHOWN; AND FURTHER CERTIFY THAT THE SUBJECT PROPERTY LIES IN ZONE 'C' (AREA OF MINIMAL FLOODING) AS SHOWN ON F.I.R.M. MAP No. 240044 0007B DATED 12-04-86 FOR HOWARD COUNTY, MARYLAND.

Jeffrey L. Cooper
JEFFREY L. COOPER #418

02/02/01
DATE

RIEMER MUEGGE
a division of:
Patton Harris Rust & Associates, pc
SUITE 200
8818 CENTRE PARK DRIVE
COLUMBIA, MARYLAND 21045
TELEPHONE (410) 987-8900
FAX (410) 987-9282

LOCATION DRAWING
LOT 23
SPRING HOLLOW LOTS 1 THRU 30
AND PRESERVATION PARCEL 'A'
4TH ELECTION DISTRICT, HOWARD COUNTY, MARYLAND
PLAT Nos. 15770 THRU 15774
SCALE: 1"=100' PROJ. No. 00318 DRAWN BY: R.A.H DATE: 02/02/01