

8/21/02

SITE INSPECTION SHEET

Map 35, Par 123

OWNER: Richard Myers

DATE REQUESTED: \_\_\_\_\_

PHONE #: 410-531-6666


CONTRACTOR: \_\_\_\_\_

ADDRESS: 7951 Harriet Tubman La  
Columbia, 21044

WELL TAG #: \_\_\_\_\_

COUNTY #: \_\_\_\_\_

PROPOSAL: Emergency Inclusion Request - well is dry;  
owner is elderly & somewhat handicapped

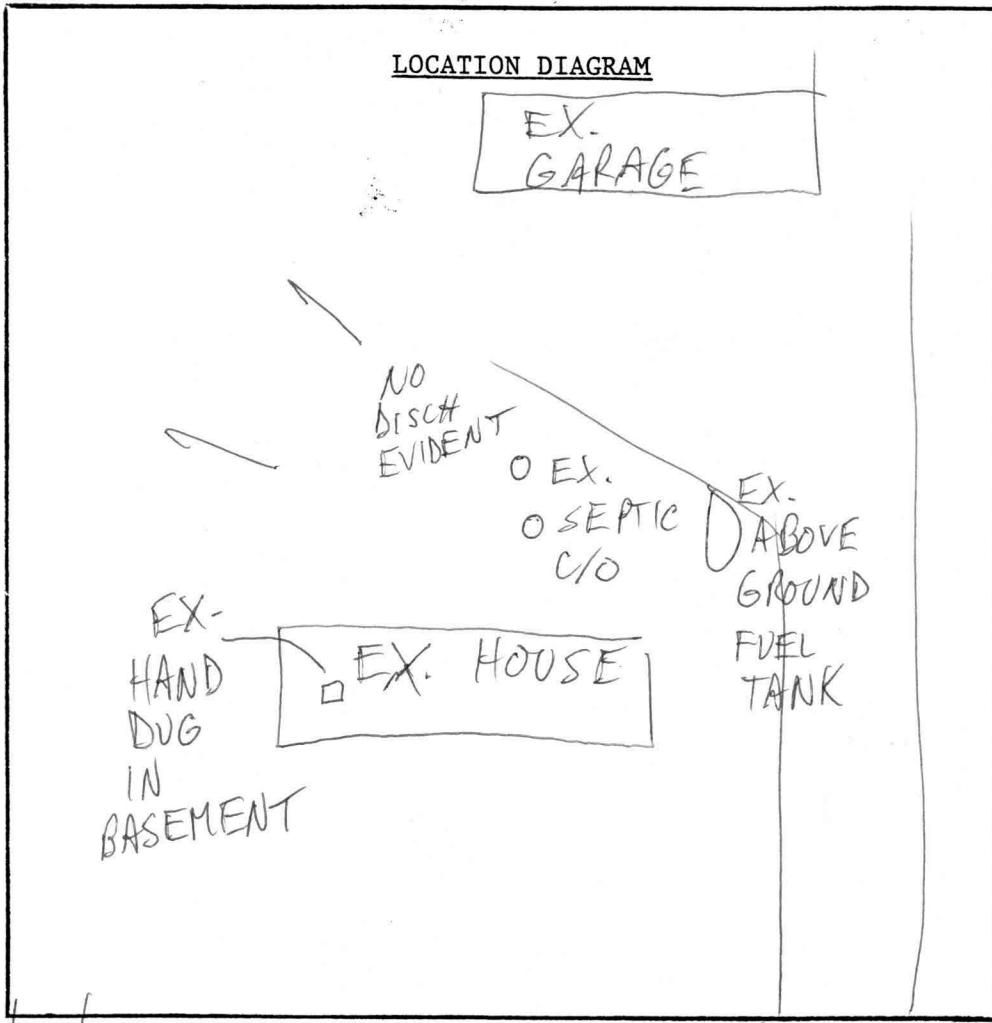

COMMENTS: 8/21/02 MET OWNER, PLBR, & NEIGHBOR AT SITE; NO H<sub>2</sub>O  
@ BATH TAP; OWNER REPORTS WELL IS 24' HAND DUG W/ 20'  
DRILLED EXTENSION IN CENTER; OK TO ISSUE LETTER (MR)

DATE: \_\_\_\_\_

INSPECTOR: \_\_\_\_\_



## HOWARD COUNTY HEALTH DEPARTMENT

Bureau of Environmental Health  
3525-H Ellicott Mills Drive, Ellicott City, Maryland 21043-4544  
(410) 313-2640 Fax (410) 313-2648  
TDD (410) 313-2323 Toll Free 1-877-4MD-DHMH

*Penny E. Borenstein, M.D., M.P.H., Howard County Health Officer*

August 21, 2002

INDEXED

### MEMORANDUM

TO: Charlotte Dryden  
Division of Real Estate Services

FROM: Mark Rifkin *MR*  
Well and Septic Program

RE: Property of Richard Myers  
7951 Harriet Tubman Lane  
Tax Map 35, Parcel 123

The Howard County Health Department recommends emergency inclusion of the referenced property into the Metropolitan Service District.

An inspection conducted this date revealed the well is located under the basement floor; the owner reports the well is 44 feet deep. Based on the fact that opening the bath tap in the basement produced no water, the existing well is incapable of meeting any sanitary needs.

Provision of an alternate water supply should be completed as soon as possible.

MR  
File

H516000-11