

APPLICATION

10/22/75

SEWAGE DISPOSAL TESTING

STATE OF MARYLAND - DEPARTMENT OF HEALTH AND MENTAL HYGIENE

HOWARD COUNTY HEALTH DEPARTMENT
ENVIRONMENTAL HEALTH SERVICES
P. O. BOX 476, ELLICOTT CITY, MARYLAND 21043
TELEPHONE: PL 3000, EXT. 356

DISTRICT 5th
DATE 10/22/75

TO: THE COUNTY HEALTH OFFICER
ELLICOTT CITY, MARYLAND

I, HEREBY, APPLY FOR THE NECESSARY TEST IN ORDER TO CONSTRUCT (OR RECONSTRUCT) A SEWAGE DISPOSAL SYSTEM.

Allan Weintraub

PROPERTY OWNER

@ Richard Hollowell

ADDRESS Highland, Md. 20722

PHONE 266-2983

PROPERTY LOCATION:

SUBDIVISION

LOT NO. Parcel 192

ROAD AND DESCRIPTION

W side of intersection of Highland Rd & Ten Oaks Rd

SIZE OF LOT

2.442 ac ± 712/15h 2/13/75

TYPE BLDG.

3 bedrm single fam. dwg

NUMBER OF BEDROOMS

IF NOT SINGLE RESIDENCE DESCRIBE

THE SYSTEM INSTALLED UNDER THIS APPLICATION IS ACCEPTABLE ONLY UNTIL PUBLIC FACILITIES BECOME AVAILABLE.

SIGNATURE OF APPLICANT

Richard Hollowell

APPROVED BY

FOR

(KIND OF SYSTEM)

DATE

REJECTED BY

FOR

(KIND OF SYSTEM)

DATE

HOLD PENDING FURTHER TESTS

DATE

REASONS FOR REJECTION OR HOLDING

THIS IS NOT A PERMIT

Property known as:

THIS PLAT CAN NOT BE USED TO ESTABLISH PROPERTY LINES OR CORNERS.

Lot 17A

Liber 2119 Folio 79


Ho. Co. Dept. of Public Works
Plat No. J-407B-66-1

5th Election District
Howard County, Md.



*sp. 0.21
100' width
road
4-13-94*

*waste
system*

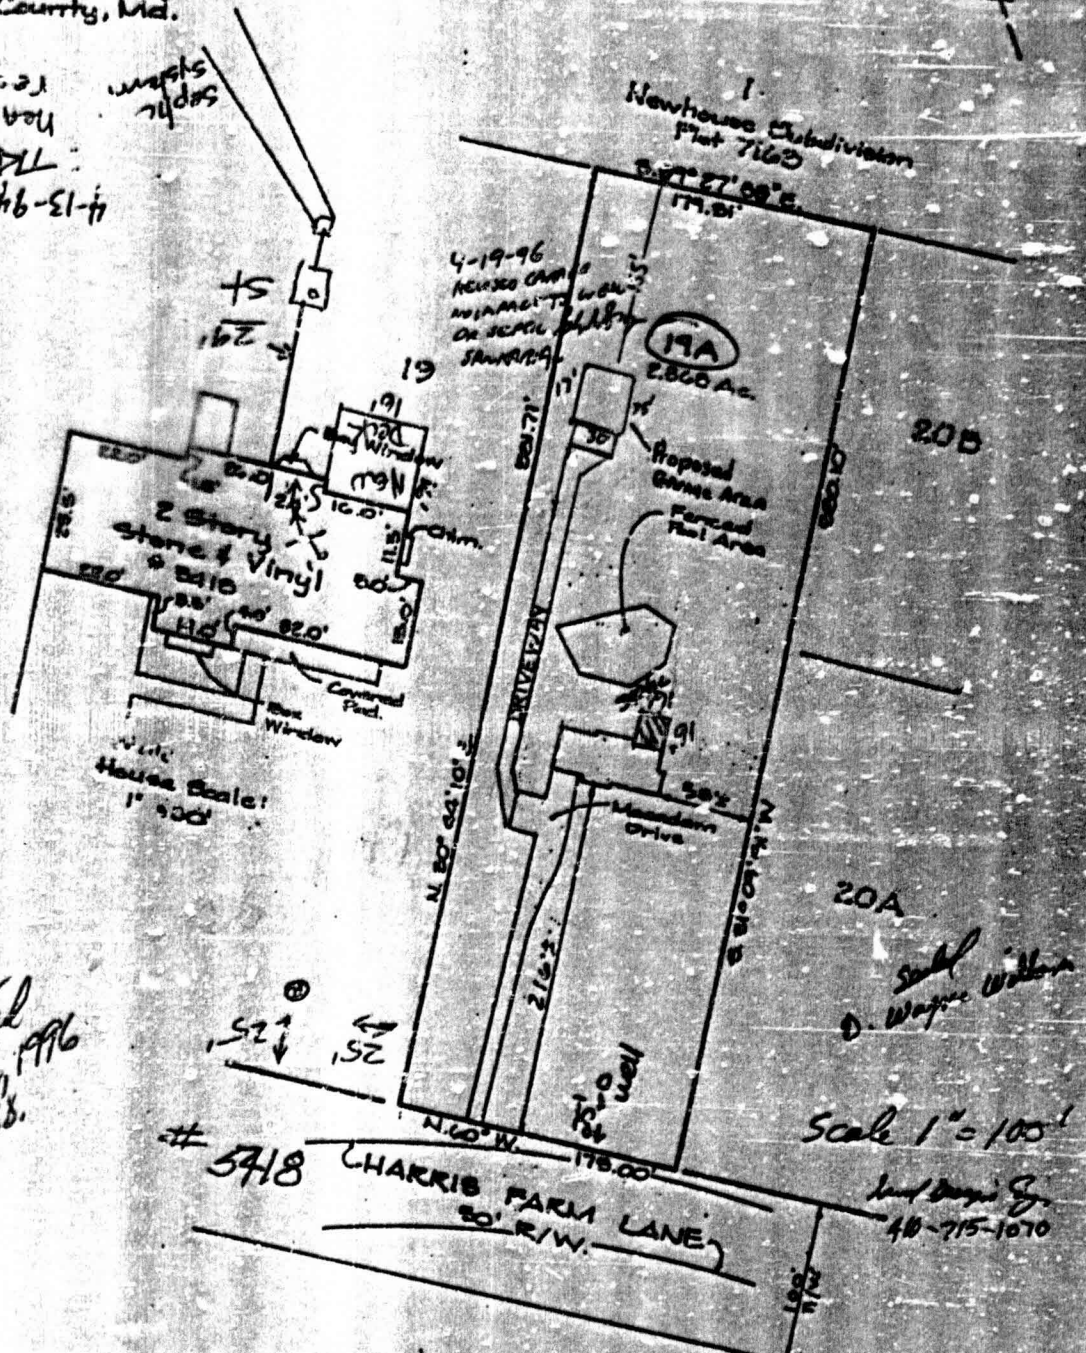

*4-19-96
HOUSE OWNER
WISHING TO
OR SEPARATE
SAVING*

*House Scale:
1" = 50'*

Scale 1" = 100'
D. Wayne Walker

*Revised
Apr. 19, 1996
H.C. #5.*

*Land Survey
40-715-1070*

5718 HARRIS FARM LANE
80' R/W.