

LAYOUT 9/12/11 INSP 4 10/5/11 RB
 INSP 2 9/13/11 INSP 5 10/7/11 RB
 INSP 3 10/4/11 RB INSP 6 _____

ISSUE DATE: 9/9/11

PERMIT

P 5 35971

APPROVAL DATE: 10/11/11

A _____

Tax ID # 05-448379

**ON-SITE SEWAGE DISPOSAL SYSTEM
 HOWARD COUNTY HEALTH DEPARTMENT
 BUREAU OF ENVIRONMENTAL HEALTH**

Charles A. Klein & Son

IS PERMITTED TO INSTALL ALTER

ADDRESS: 5220 Klees Mill Rd. PHONE NUMBER: 410-549-6960

SUBDIVISION: The Preserve at Clarksville LOT NUMBER: 23

ADDRESS: 6247 Heather Glen Way PROPERTY OWNER: Dayton Oaks LLC

SEPTIC TANK CAPACITY (GALLONS): 2000 OUTLET BAFFLE FILTER REQUIRED

PUMP CHAMBER CAPACITY (GALLONS): _____ COMPARTMENTED TANK REQUIRED

NUMBER OF BEDROOMS: 5 APPLICATION RATE: 0.8

SQUARE FOOTAGE OF HOUSE: >3500

LINEAR FEET OF TRENCH REQUIRED: 194' 2' wide
180 3'-7'

TRENCHES:	Trenches to be 3.0 feet wide. Inlet 4.0 feet below original grade. Bottom maximum depth 6.0 feet below original grade. Effective area begins at 4.0 feet below original grade with 2.0 feet of stone below distribution pipe.
LOCATION:	Run 2x97' trenches on contour. Place d box per plan. Basement will not sewer by gravity.
NOTES:	Do not order the septic tank until after layout inspection and Sanitarian approval. Stake easement corners. Call for layout inspection. Mark utilities. Gravel tickets must be available for Environmental Sanitarians. Stone must be approved by the Howard County Health Department. A written variance request is required for tanks deeper than 3 feet. A traffic bearing lid is required for tanks deeper than 4 feet.

PLANS APPROVED: Heidi Scott Kw DATE: 7/25/11


- NOTE: PERMIT VOID AFTER 2 YEARS
- NOTE: CONTRACTOR RESPONSIBLE FOR SCHEDULING A PRE-CONSTRUCTION INSPECTION FOR ALL INSTALLATIONS
- NOTE: WATERTIGHT SEPTIC TANKS REQUIRED
- NOTE: ALL PARTS OF SEPTIC SYSTEM SHALL BE 100 FEET FROM ANY WATER WELL
- NOTE: MANHOLE RISERS REQUIRED ON ALL SEPTIC TANKS AND PUMP CHAMBERS

NEITHER THE HOWARD COUNTY COUNCIL OR THE HEALTH DEPARTMENT IS RESPONSIBLE FOR THE SUCCESSFUL OPERATION OF ANY SYSTEM
PERMITTEE RESPONSIBLE FOR OBTAINING FINAL APPROVAL ON THIS PERMIT
CALL 410-313-1771 FOR INSPECTION OF SEPTIC SYSTEM

140-95-0266

30

NOT TO SCALE

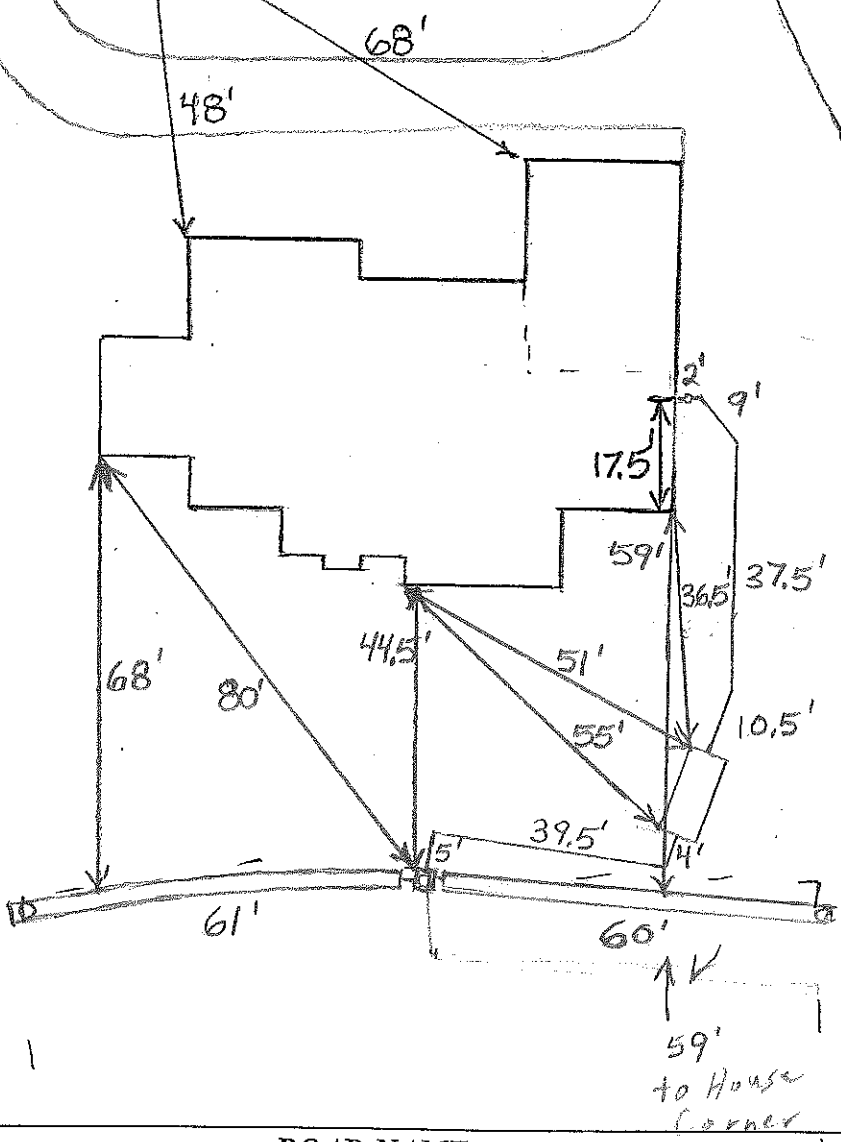

ROAD NAME

TRENCH/DRAINFIELD DATA		
WIDTH	INLET	BOTTOM
2	3'	7'
NUMBER OF TRENCHES		3
TOTAL LENGTH _____		
ABSORPTION AREA _____		
DISTRIBUTION BOX LEVEL _____		
DISTRIBUTION BOX BAFFLE		Yes
DISTRIBUTION BOX PORT		Yes

SEPTIC TANK DATA	
SEPTIC TANK I LEVEL	Yes
MANUFACTURER	Babylon
CAPACITY	2000 GAL
SEAM LOC	Top
TANK LID DEPTH	0.5/1.5
BAFFLES	Yes
BAFFLE FILTER	No
MANHOLE LOC	
6" PORT LOC	Rear
WATERTIGHT TEST	No
SLOTTED	Yes
DATE ON LID	7/22/2011
PUMP/SEPTIC TANK LEVEL N/A	
MANUFACTURER _____	
CAPACITY _____ GAL	
SEAM LOC _____	
TANK LID DEPTH _____	
BAFFLES _____	
BAFFLE FILTER _____	
MANHOLE LOC _____	
6" PORT LOC _____	
WATERTIGHT TEST _____	
SLOTTED _____	
DATE ON LID _____	

PRE-CONSTRUCTION:


9/12/11 Need to remove fill from top part of SRA.
 OK to set tanks per approved bp plan (KW)
 9/13/11 Fill removed. Contact chert. Run along top stakes.
 Cut D box in top middle part of SRA. Run 3x60' trenches
 in both directions (1x60' towards Lot 22 and 2x60' toward Lot 24).
 call for f/c insp. (KW) 10/4/2011 Tank and dist. box set. House

INSTALLATION:

connection made. Starting on 1st trench. Need tank cleanouts
 and baffles (BB) 10/5/2011 Lot 22 trench done. (BB)
 10/7/2011 Other top trench done. (BB)
 10/11/11 System complete. OK to cover (KW)

FINAL INSPECTOR K. Wolf DATE OF APPROVAL 10/14/11


120

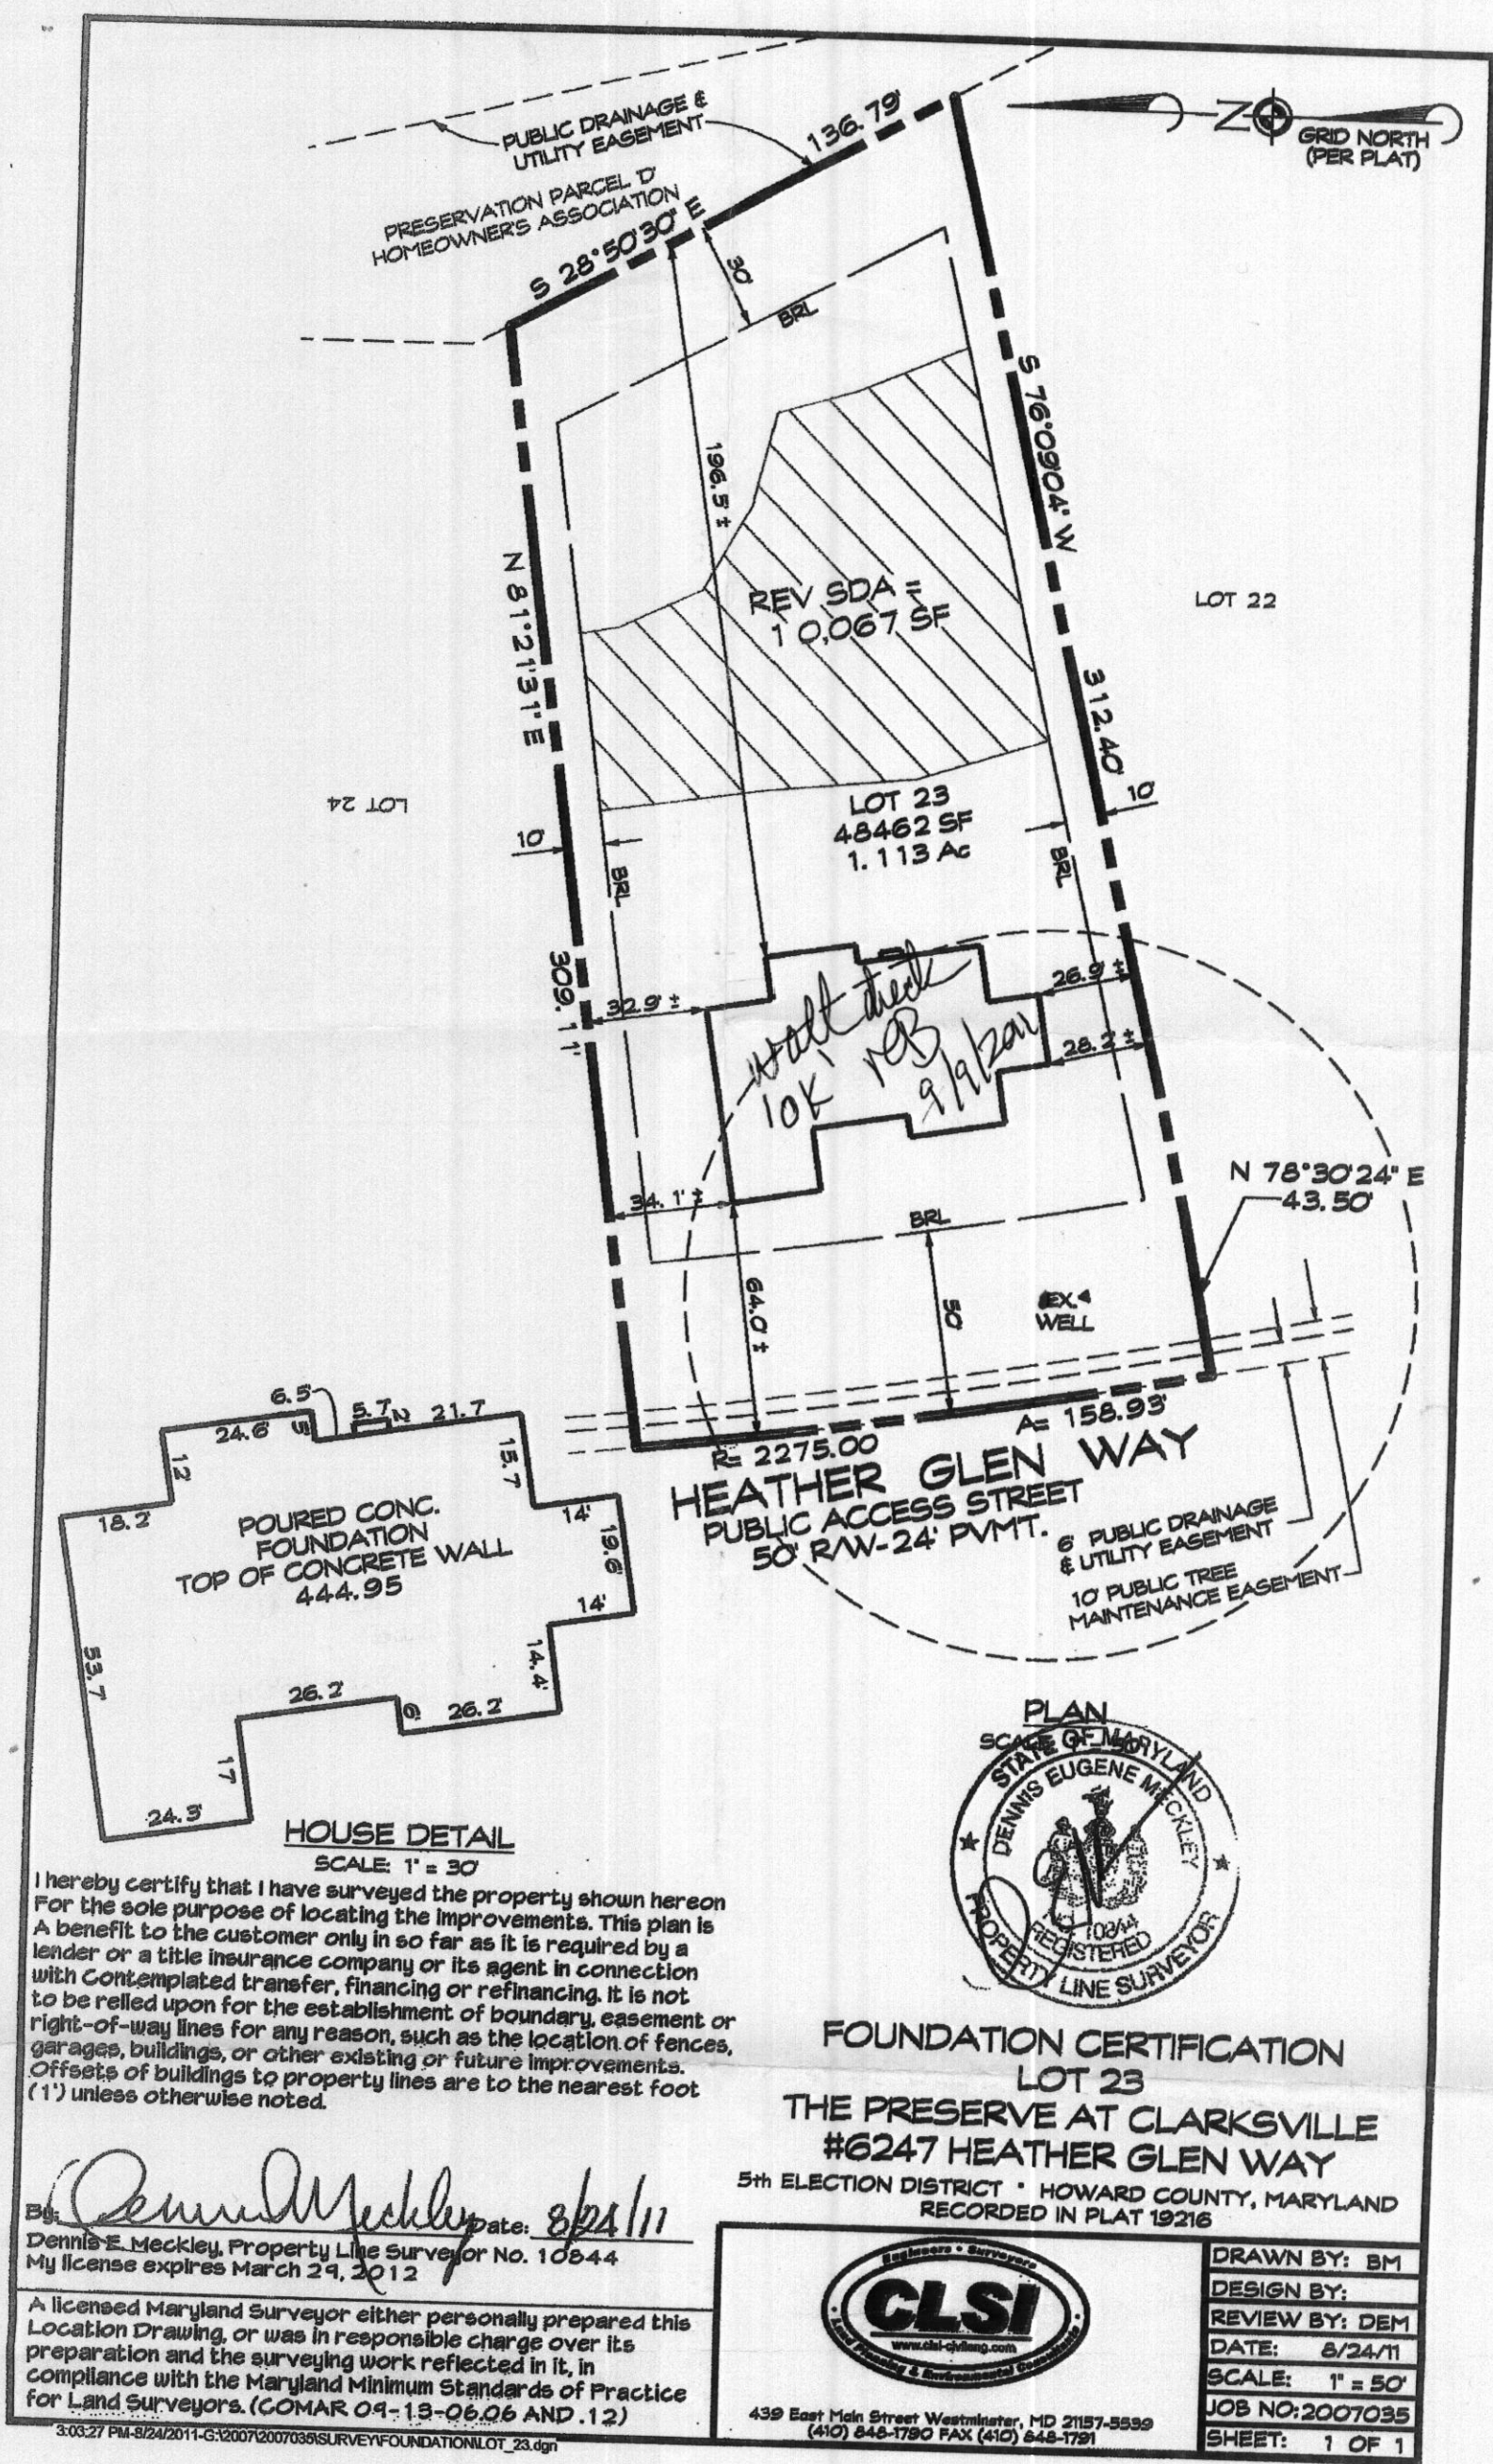

I hereby certify that I have surveyed the property shown hereon for the sole purpose of locating the improvements. This plan is a benefit to the customer only in so far as it is required by a lender or a title insurance company or its agent in connection with contemplated transfer, financing or refinancing. It is not to be relied upon for the establishment of boundary, easement or right-of-way lines for any reason, such as the location of fences, garages, buildings, or other existing or future improvements. Offsets of buildings to property lines are to the nearest foot (1') unless otherwise noted.

Dennis E. Meckley Date: *8/24/11*
 By: *Dennis E. Meckley*, Property Line Surveyor No. 10844
 My license expires March 24, 2012

A licensed Maryland Surveyor either personally prepared this Location Drawing, or was in responsible charge over its preparation and the surveying work reflected in it, in compliance with the Maryland Minimum Standards of Practice for Land Surveyors. (COMAR 09-13-06.06 AND .12)

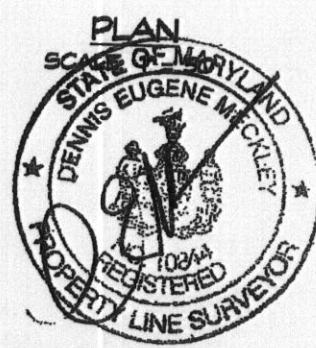

FOUNDATION CERTIFICATION
LOT 23
THE PRESERVE AT CLARKSVILLE
#6247 HEATHER GLEN WAY
 5th ELECTION DISTRICT • HOWARD COUNTY, MARYLAND
 RECORDED IN PLAT 19216



439 East Main Street Westminster, MD 21157-5599
 (410) 848-1790 FAX (410) 848-1791

DRAWN BY:	BM
DESIGN BY:	
REVIEW BY:	DEM
DATE:	8/24/11
SCALE:	1" = 50'
JOB NO:	2007035
SHEET:	1 OF 1

*Lot # 23; Preserves @ Clarksville
 6247 Heather Glen Way
 Clarksville, MD 21029*