

4/13/87

APPLICATION

PERCOLATION TESTING

A 39049

P _____

HOWARD COUNTY HEALTH DEPARTMENT
BUREAU OF ENVIRONMENTAL HEALTH
P.O. BOX 476 ELLICOTT CITY, MARYLAND 21043
TELEPHONE: 461-9933

DISTRICT 3

DATE 3/4/87

TO: THE COUNTY HEALTH OFFICER
ELLICOTT CITY, MARYLAND

I, HEREBY, APPLY FOR THE NECESSARY TEST IN ORDER TO CONSTRUCT (OR RECONSTRUCT) A SEWAGE DISPOSAL SYSTEM.

PROPERTY OWNER George Arrington Grayson Homes, Inc

ADDRESS 1050 Sykesville Rd. West Friendship MD PHONE 301-776-7454
461-5908

PROSPECTIVE BUYER Amberwoods Limited Partnership

ADDRESS 1420 Fenwick Lane Silver Spring MD PHONE 301-587-5455

PROPERTY LOCATION:

SUBDIVISION Amberwoods (5-87-42) LOT NO. 17 16

ROAD AND DESCRIPTION Rt 32 north of Rt 99 (12828 Forestview Court)

TAX MAP 9 PARCEL # 144

SIZE OF LOT 3.29 Ac TYPE BLDG. Single Family
(SINGLE FAMILY DWELLING OR COMMERCIAL)

THE SYSTEM INSTALLED UNDER THIS APPLICATION IS ACCEPTABLE ONLY UNTIL PUBLIC FACILITIES BECOME AVAILABLE. I FULLY UNDERSTAND THE FEE CONNECTED WITH THE FILING OF THIS PERC TEST APPLICATION IS NON-REFUNDABLE UNDER ANY CIRCUMSTANCES. I ALSO AGREE TO COMPLY WITH ALL M.O.S.H.A. REQUIREMENTS IN TESTING THIS LOT.

Sam Negale
(SIGNATURE OF APPLICANT)

APPROVED BY C. Williams FOR _____ DATE 4/19/89

REJECTED BY _____ FOR _____ DATE _____


HOLD PENDING FURTHER TESTS _____ DATE _____

REASONS FOR REJECTION OR HOLDING _____




BLDG. PERMIT SIGNED
AND RETURNED 12/27/83
Serial # 52093
SFD-5Bms

THIS IS NOT A PERMIT

(17)

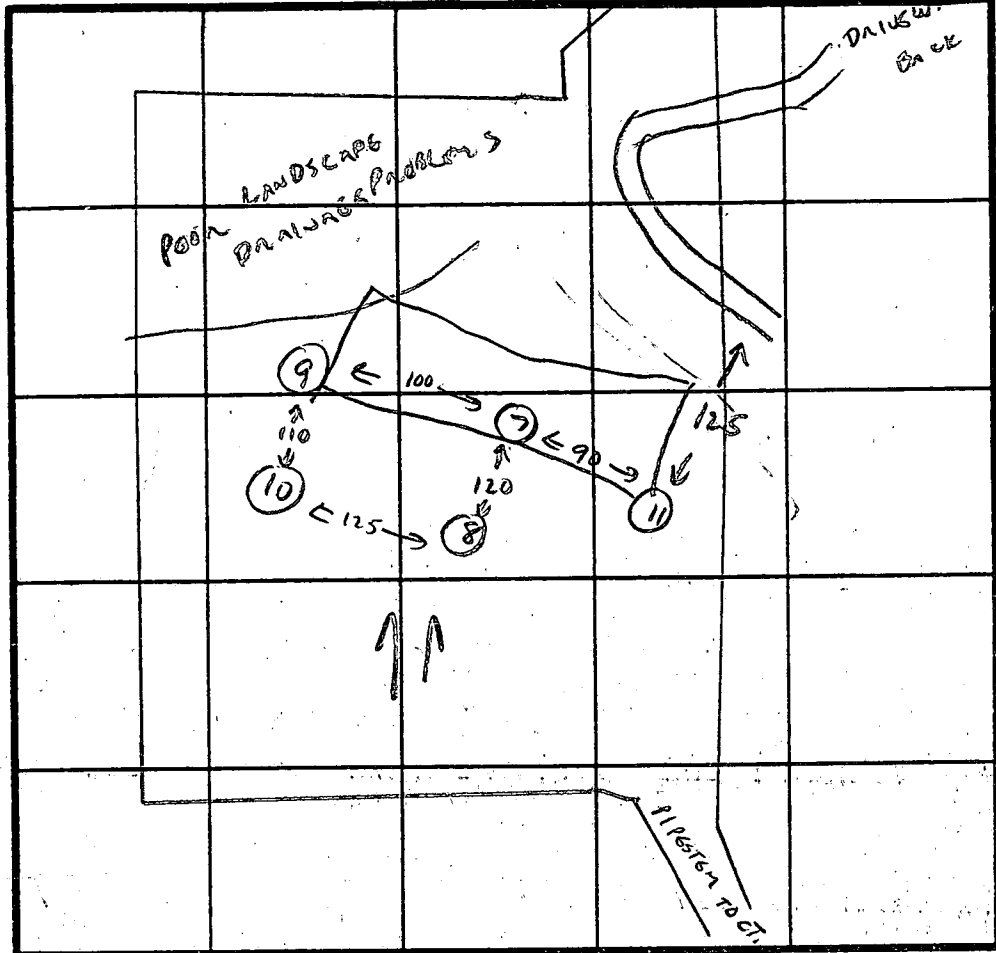

$\bar{X} = 5 \text{ MIN}$
 180' ϕ
 INEST. 2'
 BOTTOM 5'

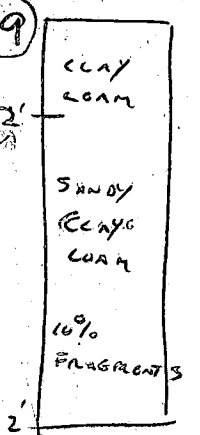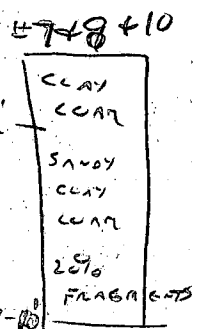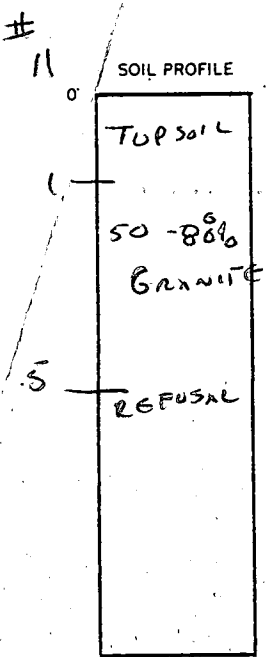

INDICATE NORTH - NAME ADJOINING ROADWAY AS BASE LINE.

DATE	TEST NO.	DEPTH	PRE-WET		TEST - 1" DROP		TIME
			START	STOP	START	STOP	
4/13/87	7	2 1/2' 5-10'	11:46 20-30%	11:48 FRACTURED GRANITE	11:48	11:50	2 MIN ✓
	8	10'	REFUSAL				-
4/13/87	8	2 1/2' 6 1/2'	11:32 11:32	11:39 11:34	11:39	11:36	6 MIN 2 MIN ✓
	11	9' REFUSAL					
4/13/87	9	23'	11:50	11:52	11:52	11:54	2 MIN ✓
		12' REFUSAL					
4/13/87	10	VLS OK	3-10'				SIMILAR TO (8) ✓
4/13/87	11	1' 5'	50%-80% REFUSAL	GRANITE			X

REMARKS _____

TYPE OF SOIL SANDY LOAM - VARIABLY DEPTN TO ROCK

TESTED BY CWILSON ALSO PRESENT SKIP

EH-12-1079