

1/24/01
Layout
Noon

1/25/01 - Follow up, Late pm
12/3/01 - Pump Test 1pm

12/5/01 P.M.
pumptest

ISSUE DATE: 9/24/2001

APPROVAL DATE: 12/5/01

PERMIT

INDEXED

P 516037

A 57679

ON-SITE SEWAGE DISPOSAL SYSTEM HOWARD COUNTY HEALTH DEPARTMENT BUREAU OF ENVIRONMENTAL HEALTH

04-364171

Union Paving Company, Inc IS PERMITTED TO INSTALL ALTER

ADDRESS: 5977 Sandy Ridge Road, Elkridge PHONE NUMBER: 410-379-6463

SUBDIVISION: Rosebar LOT NUMBER: 17

ADDRESS: 3070 Hobbs Road PROPERTY OWNER: George/Wanda Hudson

SEPTIC TANK CAPACITY (GALLONS): 1250

PUMP CHAMBER CAPACITY (GALLONS): ~~1250~~ 1250

NUMBER OF BEDROOMS: 3

SQUARE FEET PER BEDROOM: 210

LINEAR FEET OF TRENCH REQUIRED: 280

TRENCHES:	Trench to be 3.0 feet wide. Inlet 2.5 feet below original grade. Bottom maximum depth 4.5 feet below original grade. Effective area begins at 4.0 feet below original grade. 2.0 feet of stone below distribution pipe.
LOCATION:	Starting from the intersection of the 167.24' lot line and the 95.90' lot line, place the distribution box 75' down the 167.24' lot line and 10' off this same lot line. Run (3) trenches on contour toward front of lot as shown on plan.
NOTES:	40' Trench May Be Slightly Deeper Than 4.5' CAE

PLANS APPROVED: MER 8/13/01 OK (BB) DATE: 8/3/01

NOTE: PERMIT VOID AFTER 2 YEARS

NOTE: CONTRACTOR RESPONSIBLE FOR SCHEDULING A PRE-CONSTRUCTION INSPECTION FOR ALL INSTALLATIONS

NOTE: WATERTIGHT SEPTIC TANKS REQUIRED


NOTE: ALL PARTS OF SEPTIC SYSTEM SHALL BE 100 FEET FROM ANY WATER WELL

NOTE: MANHOLE RISERS REQUIRED ON ALL SEPTIC TANKS AND PUMP CHAMBERS

NEITHER THE HOWARD COUNTY COUNCIL NOR THE HEALTH DEPARTMENT IS RESPONSIBLE FOR THE SUCCESSFUL OPERATION OF ANY SYSTEM PERMITTEE RESPONSIBLE FOR OBTAINING FINAL APPROVAL ON THIS PERMIT CALL 410-313-2640 FOR INSPECTION OF SEPTIC SYSTEM

P 516037

NOT TO SCALE

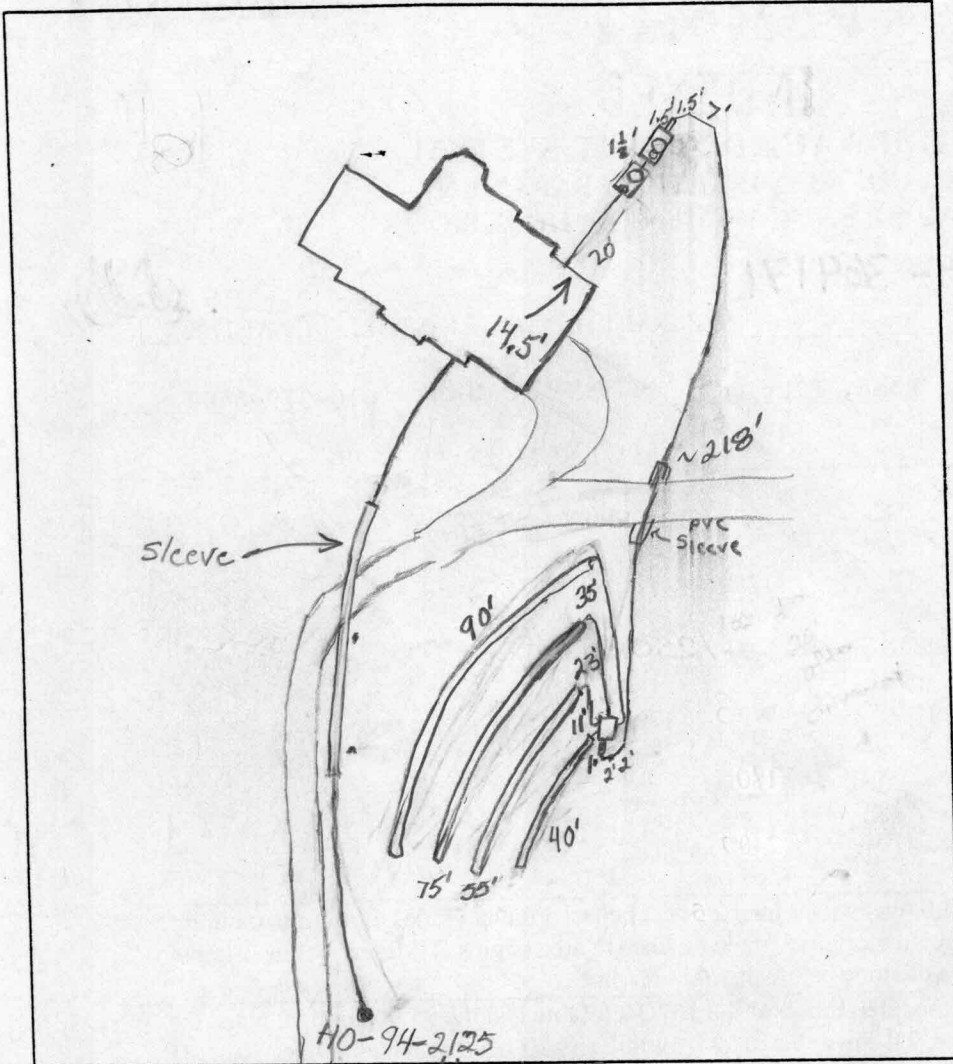

TRENCH DATA

TRENCH WIDTH 3'
 TRENCH INLET DEPTH 2.5'
 TRENCH BOTTOM DEPTH 4.5'
 DEPTH OF STONE 2'
 NUMBER OF TRENCHES 4
 TOTAL TRENCH LENGTH 260'
 ABSORBENT AREA 780 sq. ft.
 DISTRIBUTION BOX LEVEL Yes
 BAFFLE IN DISTRIBUTION BOX Yes

SEPTIC TANK DATA

SEPTIC TANK 1250 T.S. GALLONS
 MANHOLE RISER back
 6 INCH INSPECTION PORT Front

PUMP CHAMBER DATA

PUMP CHAMBER GALLONS 1250 T.S.
 MANHOLE RISER BACK 6" on front
 ALARM OPERATIONAL
 PUMP PERFORMANCE TEST ✓

PRE-CONSTRUCTION INSPECTION: Hobbs Road 9/24/01 OK TO COVER TRENKS (S.T. = 3 1/2' deep, Pump Tank 3' deep)

INSPECTION COMMENTS: 9/26/01 House only has 3 bedrooms. One bedroom converted into office space with no door. Unable to fit 280' of trench, so contractor made best use of area and installed 260' of trench. O.K. to cover everything. Need pump and alarm test for final approval. (BB) 12/3/01 Alarm working. Pump not working. (BB) 12/5/01 - PUMP & ALARM OPERATIONAL
 - (SRK)

INSPECTOR Steven R. Krieg DATE SYSTEM APPROVED 12/5/01