

LAYOUT 8-18-03 11AM INSP 4 8/25 11am
INSP 2 8-19-03 INSP 5 7/1/04-21-11:30
INSP 3 8/22/03 - 11AM INSP 6 _____

ISSUE DATE: 7/29/2003

APPROVAL DATE: 7/2/04

P 519070

A 515011

PERMIT

SANDMOUND SYSTEM ON-SITE SEWAGE DISPOSAL SYSTEM HOWARD COUNTY HEALTH DEPARTMENT BUREAU OF ENVIRONMENTAL HEALTH

INDEXED 03-301273

Fogles Septic Clean, Inc IS PERMITTED TO INSTALL ALTER

ADDRESS: 580 Obrecht Rd, Sykesville PHONE NUMBER: 410-795-5670

SUBDIVISION: Weisensel Property LOT NUMBER: 7-A-B

ADDRESS: 12342 Howard Lodge Road PROPERTY OWNER: Jacobsen Homes

SEPTIC TANK CAPACITY (GALLONS): 1500 OUTLET BAFFLE FILTER REQUIRED

PUMP CHAMBER CAPACITY (GALLONS): 1500 [↑] 1250 COMPARTMENTED TANK REQUIRED

NUMBER OF BEDROOMS: 4 (system sized for 5 bedrooms)

LOCATION:	Sand Mound to be installed. See Plans for Sand Mound approved on 7/17/2002.
NOTES:	All three(3) Sand Mound sites are to be staked. Heavy equipment is not allowed on or directly down hill of any of the three (3) Sand Mound sites.


PLANS APPROVED: Brian Baker OK MR DATE: 8/12/2002

NOTES: PERMIT VOID AFTER 2 YEARS
CONTRACTOR IS RESPONSIBLE FOR SCHEDULING A PRE-CONSTRUCTION INSPECTION FOR ALL INSTALLATIONS
WATERTIGHT SEPTIC TANKS REQUIRED
ALL PARTS OF SEPTIC SYSTEM SHALL BE 100 FEET FROM ANY WATER WELL UNLESS SPECIFICALLY AUTHORIZED
MANHOLE RISERS REQUIRED ON ALL SEPTIC TANKS AND PUMP CHAMBERS UNLESS SPECIFICALLY AUTHORIZED
CONTRACTOR RESPONSIBLE FOR COMPLIANCE WITH APPLICABLE REGULATIONS, GUIDELINES AND THE TERMS OF THIS PERMIT

**NEITHER THE HOWARD COUNTY COUNCIL NOR THE HEALTH DEPARTMENT IS
RESPONSIBLE FOR THE SUCCESSFUL OPERATION OF ANY SYSTEM
PERMITTEE RESPONSIBLE FOR OBTAINING FINAL APPROVAL ON THIS PERMIT
ALL 410-313-2640 FOR INSPECTION OF SEPTIC SYSTEM**

**BUILDING PERMIT SIGNED
AND RETURNED**

4-2805-800153545 - SHED
6-21-06 BOB 000247- DECK

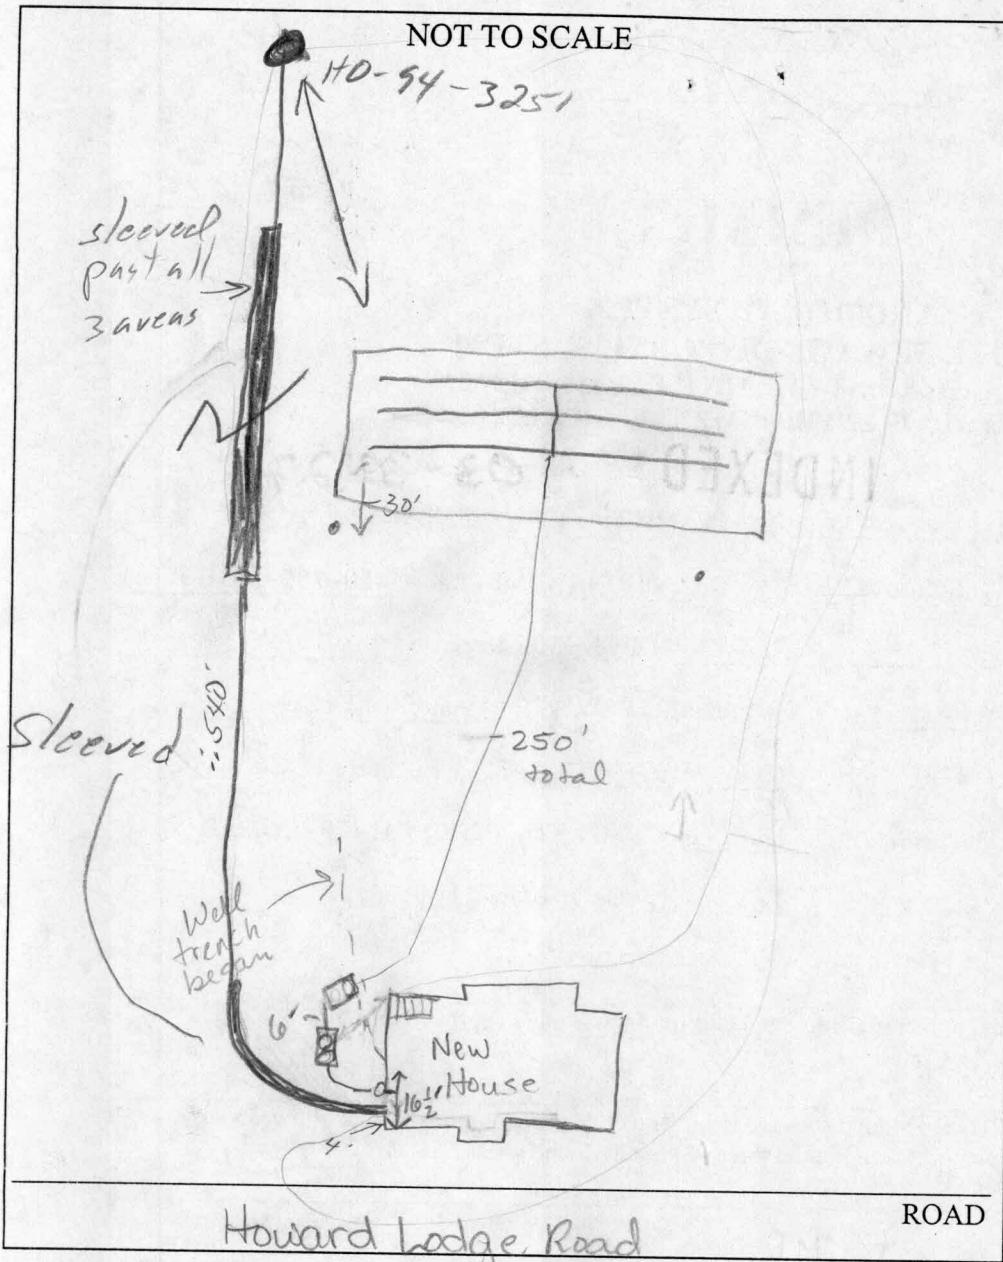

TRENCH/DRAINFIELD DATA

WIDTH	INLET	BOT
NUMBER OF TRENCHES		
TOTAL LENGTH		
ABSORPTION AREA		
DISTRIBUTION BOX LEVEL		
DISTRIBUTION BOX BAFFLE		
DISTRIBUTION BOX PORT		

SEPTIC TANK DATA *compartment*

SEPTIC TANK 1 LEVEL yes

CAPACITY 1500 GAL

SEAM LOC top

TANK LID DEPTH 18"

BAFFLES

BAFFLE FILTER yes

MANHOLE LOC front/back

6" PORT LOC none

WATERTIGHT TEST No

SEPTIC TANK 2 LEVEL top room

CAPACITY 1500 GAL

SEAM LOC top

TANK LID DEPTH 18"+

BAFFLES yes

BAFFLE FILTER

MANHOLE LOC back

6" PORT LOC None

WATERTIGHT TEST No

PRE-CONSTRUCTION 8/18/03-

INSTALLATION 8/19/03- T/C w/ KURT FROM FOGLES, INSTALL SAND MOUND PER APPROVED PLAN BY RJP ON 7/17/02 (SAND MOUND IN LOWEST PART OF SDA; USE 2" FORCE MAIN) (SRK) 8-19-03 Baffle filter installed. Fogles verified sleeving 10' prior to 1st S. mound to 10' past 3rd highest mound Sleeve @ cross connection of septic line & well line. Discussed method of S.M. layout. KN/FA. 8/20/03 Called Builder and left message to call back. 8/22/03 Sand & gravel bed installed. OK to proceed (SO) 8/25/03 - Laterals installed & covered (SO) 9/16/03 SEE BOTTOM

FINAL INSPECTOR [Signature] DATE OF APPROVAL 7/2/04

9/16/03 Contractor will sleeve the entire well line. The lot line and future septic SAND mound has only 10' sep. distance. Need to keep

12,342 Howard Lodge Rd

Page 2


7/1/64 - Alarm test OK. Pump producing way too much pressure. Needs in line valve and/or smaller pump. Also noted ground hog hole in side of sand mound? (SC)

7/2/64 - Valve installed. Pump test OK (SC)


NOTES:

THE PROPERTY SHOWN HEREON LIES IN NO SPECIAL FLOOD HAZARD AREAS AS SHOWN ON FLOOD INSURANCE RATE MAP NO: 240044 0009B(NOT PRINTED)


1. THIS PLAT IS OF BENEFIT TO A CONSUMER ONLY INSOFAR AS IT IS REQUIRED BY A LENDER OR TITLE INSURANCE COMPANY OR ITS AGENT IN CONNECTION WITH CONTEMPLATED TRANSFER, FINANCING, OR REFINANCING.
2. THIS PLAT IS NOT TO BE RELIED UPON FOR THE ESTABLISHMENT OR LOCATION OF FENCES, GARAGES BUILDINGS, POOLS, BUILDING ADDITIONS OR OTHER EXISTING OR FUTURE IMPROVEMENTS.
3. THIS PLAT DOES NOT PROVIDE FOR THE ACCURATE IDENTIFICATION OF PROPERTY BOUNDARY LINES, BUT SUCH IDENTIFICATION MAY NOT BE REQUIRED FOR THE TRANSFER OF TITLE OR SECURING FINANCING OR REFINANCING.
4. ACCURACY OF BUILDING MEASUREMENTS: 0.1'
5. ACCURACY OF SETBACK DIMENSIONS: 0.3'
6. ACCURACY OF ELEVATIONS: 0.2'

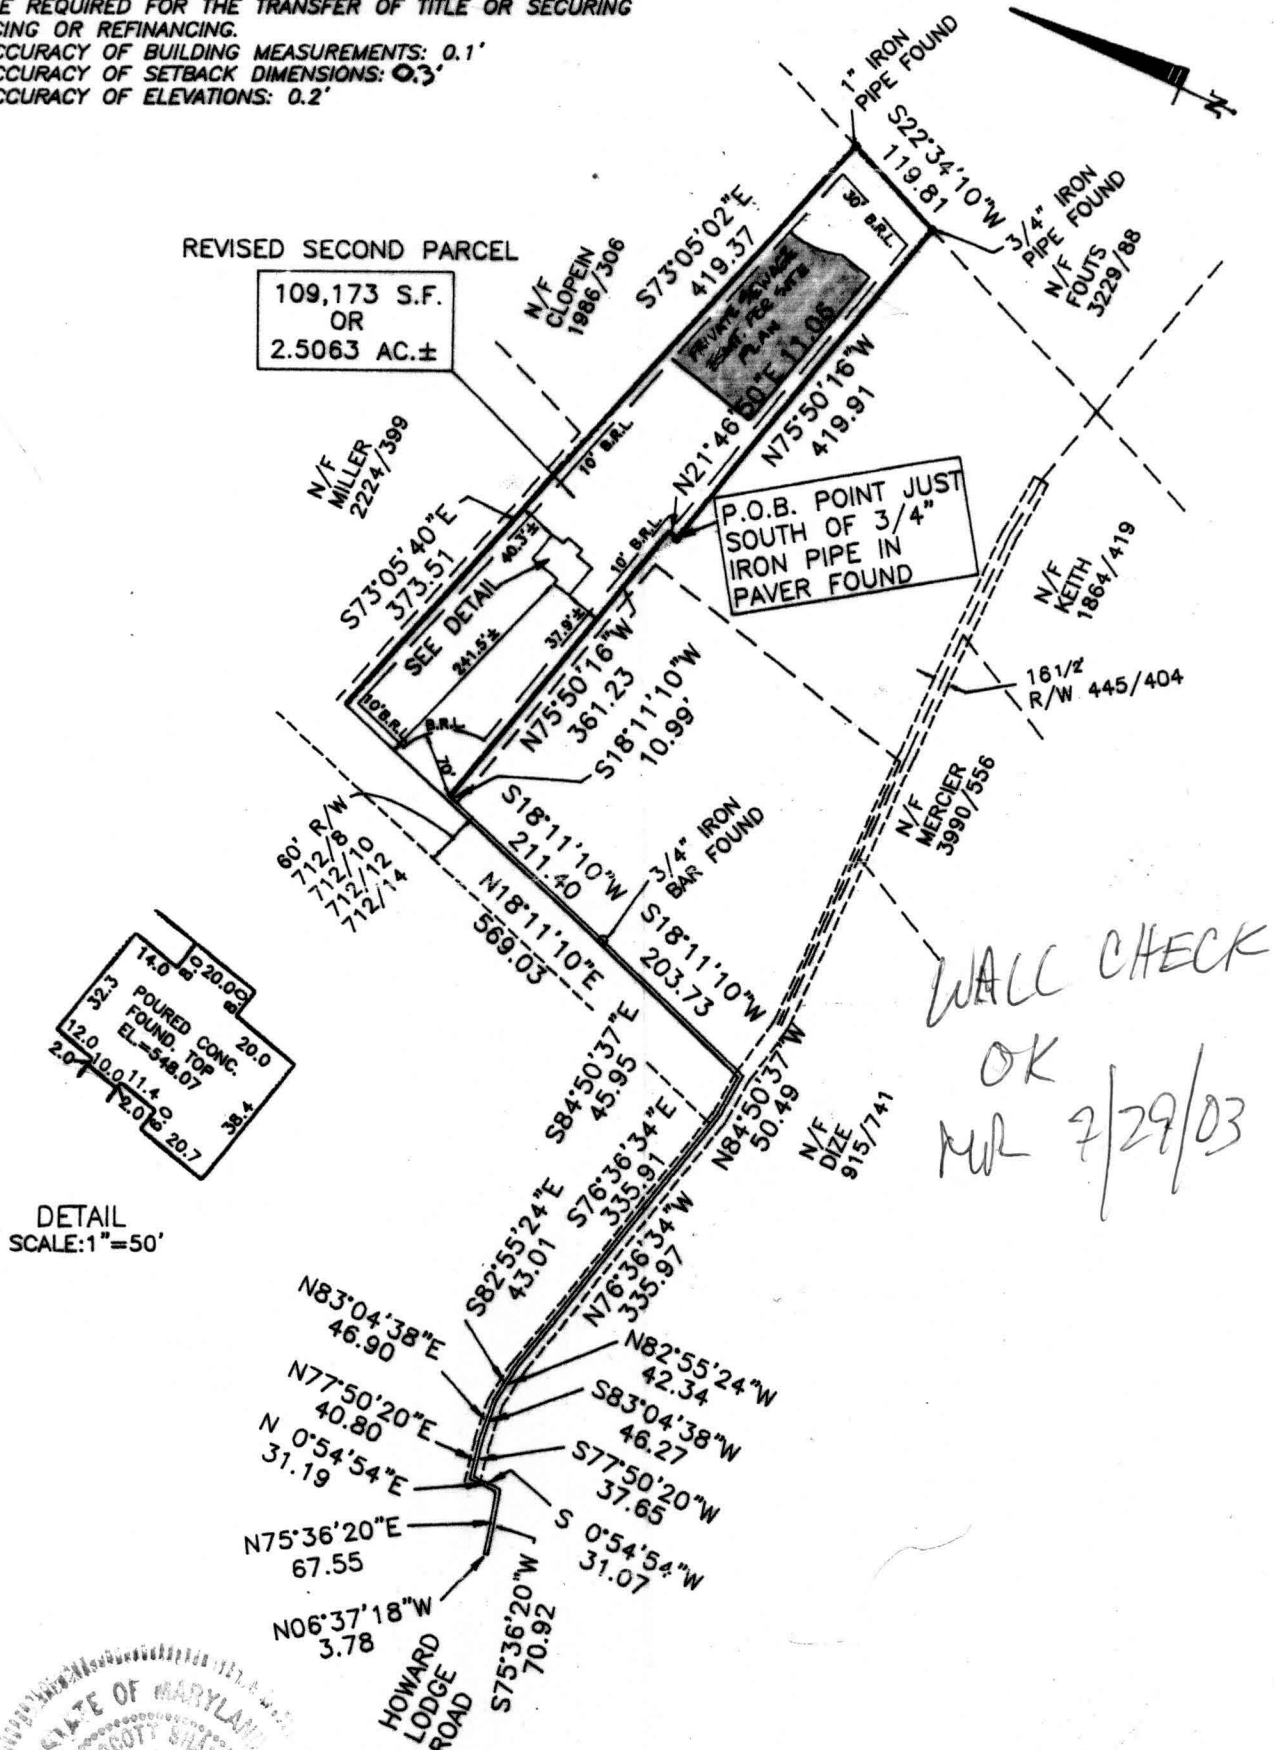

DETAIL SCALE: 1"=50'

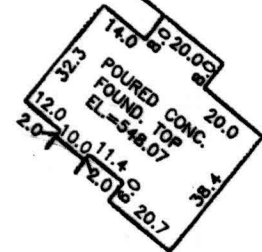

WALL CHECK
OK
MR 7/29/03

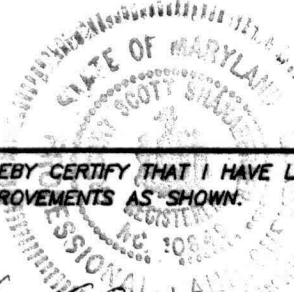

I HEREBY CERTIFY THAT I HAVE LOCATED THE IMPROVEMENTS AS SHOWN.

Shanabarger & Lane

SHANABERGER & LANE
8726 TOWN AND COUNTRY BLVD.
SUITE 201
ELLCOTT CITY, MD. 21043
(410)461-9563 FAX:461-9693

FOUNDATION LOCATION DRAWING
PROPERTY OF
JACOBSEN HOMES LLC

DEED REFERENCE: L.5887/F.680
ELECTION DISTRICT: THIRD
COUNTY: HOWARD
SCALE: 1"=200'
DATE: OCTOBER 24, 2002
DATE OF LATEST FIELD WORK: 10/17/02