


NOTES:

I.R.L. Information, if shown, was obtained from existing record plat or local agencies and is not guaranteed by NTT, Inc.
 Building line and/or Flood Zone information is subject to the interpretation of the originator.
 NTT, Inc. does not certify to unshown or unrecorded encroachments or overlaps.
 Property markers not found, or guaranteed by this location.
 Setback distance accuracy: 1/4".

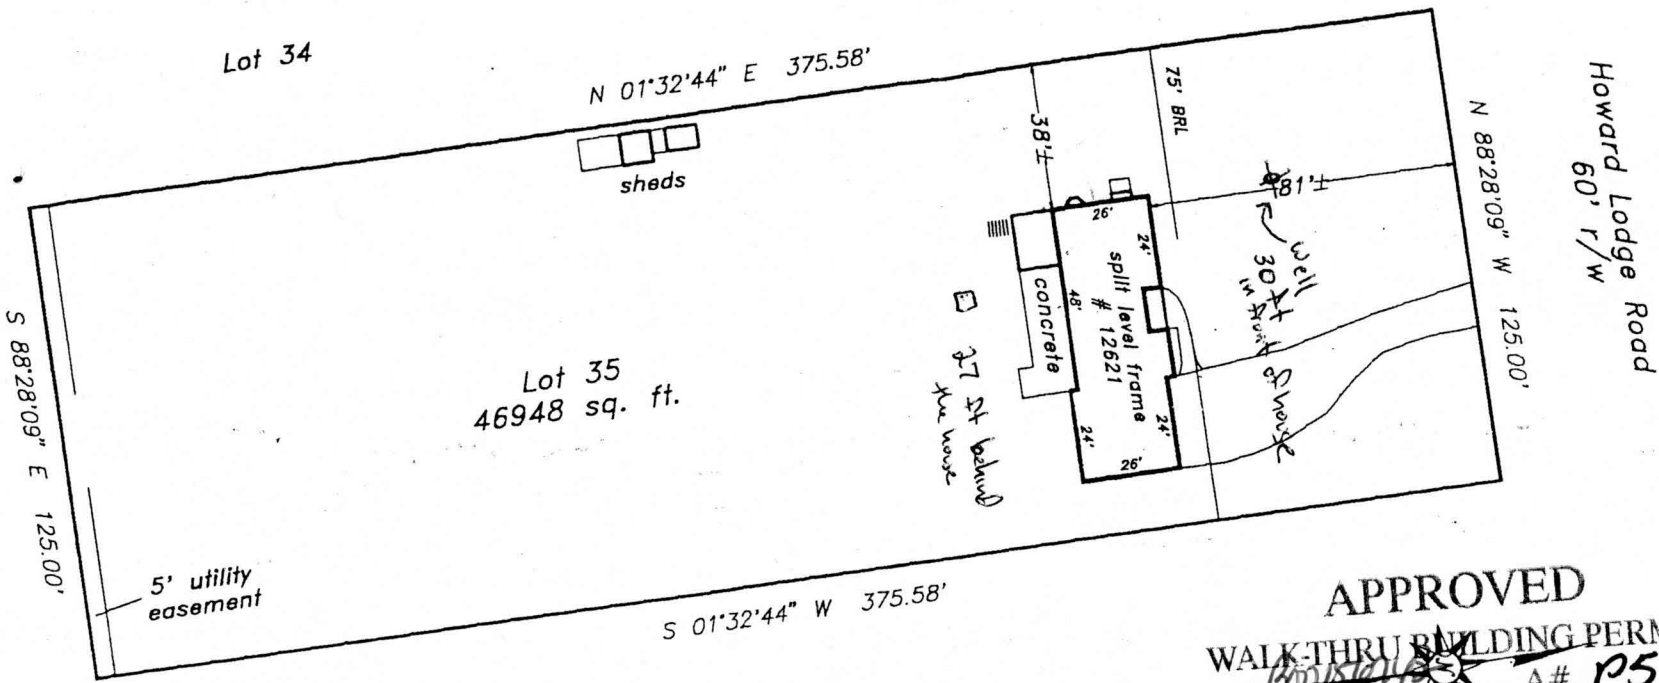

APPROVED
 WALK-THRU BUILDING PERMIT
 BP# ~~12621~~ A# P515274
 APP. SAN KACIE NORTON DATE 10-24-05
 DESC. OF WORK: Deck

Subject property is shown in Zone C on the National Flood Insurance Program Flood Insurance Rate Map of Howard County, Maryland. Panel # 9 of 45 Community Panel # 240044-ND3 PRINTED Effective date: December 4, 1986

This is to certify that I have surveyed the property shown hereon, being known as Lot 35
12621 Howard Lodge Road
 recorded in the Land Records of Howard County, Maryland in Plat Bk. 9/75 Liber 473 Folio 634 for the purpose of locating the improvements thereon.

- * This plat is of benefit to the consumer only insofar as it is required by a lender or a title insurance company or its agent in connection with contemplated transfer, financing, or refinancing purposes.
- * This plat is not to be relied upon for the establishment of location of fences, garages, buildings, or other existing or future structures.
- * This plat does not provide for the accurate identification of property boundary lines, but such identification may not be required for the purpose of title or for securing financing or refinancing.




LOCATION DRAWING
 12621 Howard Lodge Road
 Indian Hills
 3rd election district
 HOWARD COUNTY, MARYLAND

NTT Associates, Inc.
 16205 Old Frederick Road
 Mt. Airy, Maryland 21771
 Ph. (410)442-2031
 Fax No. (410)442-1315

Scale: 1" = 50'
 Date: September 20, 1999
 Field by: JLM
 Drawn by: JLM
 Drawing # 12732CAT

8. Sketch Area:

Well 30 ft in front of the left corner of the house

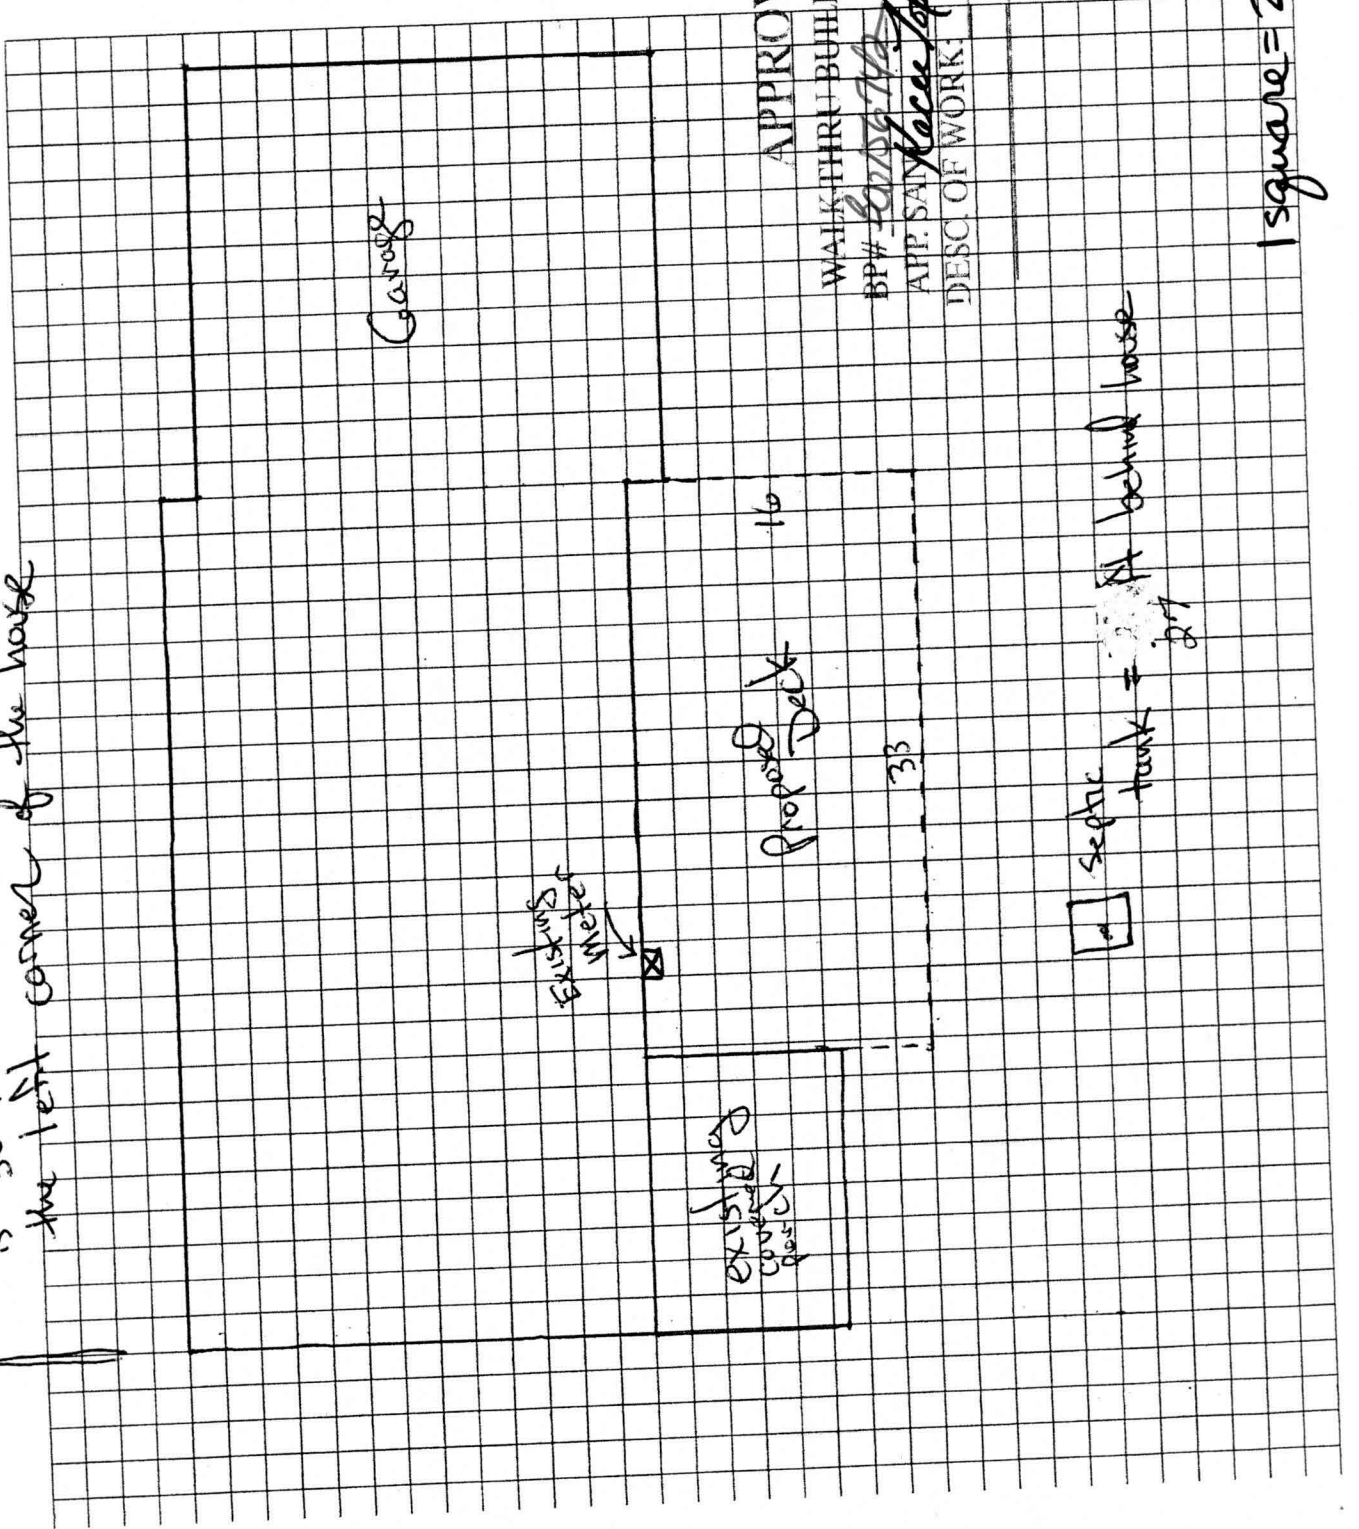

APPROVED

WALK-THRU BUILDING PERMIT

BP# ~~10106714~~ A# P 515274

APP. SAIN ~~Kacee Sprax~~ DATE: 10-24-05

DESC OF WORK: Deck

square = 2'