

APPLICATION

A 12545

SEWAGE DISPOSAL TESTING

P _____

MARYLAND STATE DEPARTMENT OF HEALTH

HOWARD COUNTY

ELLICOTT CITY

413 E. DROOMS
1000 Collier Tank
Well - 350 soft
sidewall area below
789 is met with a maximum
depth of 15 FT

413 E. DROOMS
DISTRICT 3
DATE 3/29/67

TO: THE COUNTY HEALTH OFFICER
ELLICOTT CITY, MARYLAND

I, HEREBY, APPLY FOR THE NECESSARY TESTS IN ORDER TO CONSTRUCT OR RECONSTRUCT A SEWAGE DISPOSAL SYSTEM.

PROPERTY OWNER Country Homes, Ltd.

ADDRESS 5820 Southwestern Blvd., Arbutus, Md. PHONE 242-1600

PROPERTY LOCATION:

SUBDIVISION Indian Hill LOT NO. 35

ROAD AND DESCRIPTION Howard Lodge Road

OCCUPANT _____ PHONE _____

PERSON TO CONSTRUCT SYSTEM _____

ADDRESS _____ PHONE _____

SIZE OF LOT 46,948 sq. ft. TYPE BLDG. 3 OF 4

IF NOT SINGLE RESIDENCE DESCRIBE _____
(Single Fmly. Dwlg.)

SIGNATURE OF APPLICANT [Signature]


APPROVED BY [Signature] FOR [Signature] DATE 29 MAR 67

REJECTED BY _____ FOR _____ DATE _____

HOLD PENDING FURTHER TESTS _____ DATE _____

REASONS FOR REJECTION OR HOLDING _____

THIS IS NOT A PERMIT

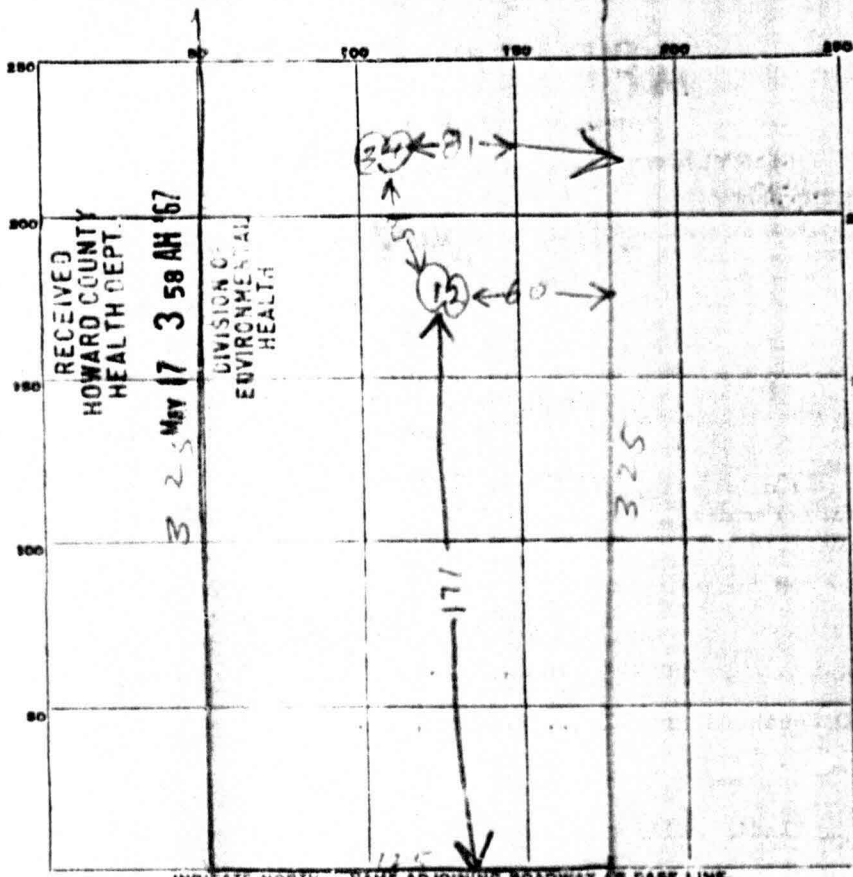

1100 BAY LODGE RD

DATE	TEST NO.	DEPTH	PRE-WET		TEST - 1" DROP		TIME
			START	STOP	START	STOP	
2/29/67	1	12	1006	1014	1014	1028	14
3/1/67	2	7	1007	1013	1013	1025	12
3/1/67	3	12	1040	1044	1044	1057	14
3/2/67	4		1041	1046	1046	1052	6

SOIL AUGER FINDING

TESTED BY *[Signature]*

REMARKS *Lot 35*