

5/18/67
Steady

PERMIT

P 12538

A 12945

SEWAGE DISPOSAL SYSTEM

MARYLAND STATE DEPARTMENT OF HEALTH

HOWARD COUNTY

ELLICOTT CITY

DISTRICT 3

DATE 5-1-67

INDEXED

Charles Doyle IS PERMITTED TO INSTALL ALTER

ADDRESS Box 294-C Randallstown, Md. PHONE 922-6920

A SEWAGE DISPOSAL SYSTEM LOCATED AT _____

SUBDIVISION Indian Hill ROAD ¹²⁶²¹ Howard Lodge Rd. LOT 35

PROPERTY OWNER ~~Stanley H. Hoke, LDC~~ James Jacobs

ADDRESS 5820 Southwestern Blvd., Arbutus, Md.

SPECIFICATIONS - 3-Bedrooms

DRAIN FIELD _____ DEPTH _____ FEET. BOTTOM AREA _____ SQ. FT.

SEEPAGE PITS _____ ABSORBENT SIDE-WALL AREA _____ SQ. FT.

SEPTIC TANK CAPACITY 750 GALLONS

FOR GARRAGE GRINDER, INCREASE DISPOSAL AREA 22% & TANK CAPACITY 50%.

OTHER Dry Well - 350 sq. ft. sidewall area below the inlet with a maximum depth of 15 ft. Locate the Dry well 170 ft. to 230 ft. from the front lot line and 60 ft. to 80 ft. from the right side of the lot as seen when facing the lot from Howard Lodge Rd.

PERMIT VOID AFTER THREE YEARS.

PLANS APPROVED BY Raymond C. Hodges DATE 3/29/67


FILL SEPTIC TANK AND DISTRIBUTION BOX WITH WATER BEFORE CALLING FOR AN INSPECTION. COVER NO WC.WK UNTIL INSPECTED AND APPROVED.

NEITHER THE HOWARD COUNTY COMMISSIONERS NOR THE HEALTH DEPARTMENT IS RESPONSIBLE FOR THE SUCCESSFUL OPERATION OF ANY SYSTEM.

NOTIFY THE HEALTH DEPARTMENT 48 HOURS BEFORE EXCAVATIONS ARE TO BE BACK FILLED.

12538-1

A12545

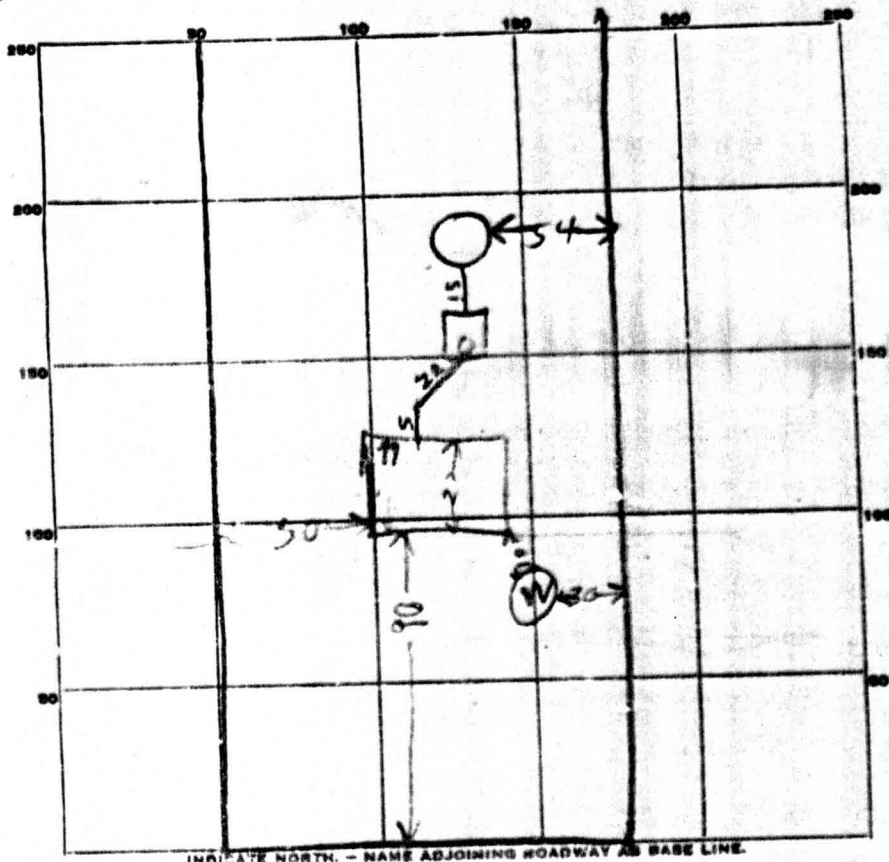

29

PERMIT CARD _____

SEPTIC TANK, LEVEL OK 750 concrete
Top is 1 FT below grade

CLEANOUTS _____

DISTRIBUTION BOX, LEVEL _____

TILE FIELD, DEPTH _____ FT. TRENCH WIDTH _____ FT.

GRAVEL DEPTH _____ IN. TOTAL LENGTH _____ FT.

NUMBER OF TRENCHES _____ TOTAL BOTTOM AREA _____

SEEPAGE PITS, INSIDE DIAMETER 12 FT. DEPTH BELOW INLET 10 FT.

ABSORBENT AREA 370 SQ. FT. not counting stone

REMARKS 5/18/67 New Well Inlet is 2 FT below grade.

About 11 ft stone around dry well
The 4x20 soft sidewalk area counting stone

DATE SYSTEM APPROVED 6/13/67

INSPECTOR Raymond H. [Signature]