

# PERMIT

SEWAGE DISPOSAL SYSTEM  
HOWARD COUNTY HEALTH DEPARTMENT  
BUREAU OF ENVIRONMENTAL HEALTH  
410-313-2640

P 515293

A REPAIR

ISSUE DATE 6/15/01

APPROVAL DATE 6/18/01

INDEXED

05-359414

Fogles Septic Clean, Inc

IS PERMITTED TO INSTALL  ALTER

ADDRESS 580 Obrecht Road, Sykesville, MD 21797

PHONE 410-795-5670

SUBDIVISION Holiday Hills

LOT NUMBER 19

ADDRESS 10617 Hunting Lane

PROPERTY OWNER Mark & Pat Wheeler

PROPERTY OWNER'S ADDRESS Same

SEPTIC TANK CAPACITY approximately GALLONS

PUMP CHAMBER CAPACITY N/A <sup>1000</sup> GALLONS

NUMBER OF BEDROOMS 3

SQUARE FEET PER BEDROOM 200

LINEAR FEET OF TRENCH REQUIRED 92

TRENCHES: Trenches to be 2 feet wide. Inlet 2.5 feet below original grade. Bottom maximum depth

9.0 feet below original grade. 6.5 feet of stone below distribution box.

LOCATION:

REPAIR - PURPOSE - EXISTING SEPTIC SYSTEM HAS FAILED.

Call for inspection when ground is opened so sanitarian can recommend repair. 4/24/01

PLANS APPROVED \_\_\_\_\_

DATE \_\_\_\_\_

PERMIT VOID AFTER 2 YEARS

NOTE: CONTRACTOR RESPONSIBLE FOR SCHEDULING A PRE-CONSTRUCTION INSPECTION FOR ALL INSTALLATIONS

NOTE: TOP OF SEPTIC TANKS ARE TO BE NO DEEPER THAN 3.0 FEET BELOW FINISH GRADE

NOTE: WATERTIGHT SEPTIC TANKS REQUIRED

NOTE: CLEANOUT REQUIRED EVERY 70 FEET OF SEWER LINE AND/OR AT 90° SWEEPS IN LINES FROM HOUSE TO DRAIN FIELDS, 90° ELBOWS ARE NOT ACCEPTABLE

NOTE: ALL PARTS OF SEPTIC SYSTEMS (I.E. TANK, DISTRIBUTION BOX, DRAINFIELDS) TO BE 100 FEET FROM ANY WATER WELL UNLESS OTHERWISE SPECIFICALLY AUTHORIZED

NOTE: NO ABSORPTION TRENCH TO EXCEED 100 FEET IN LENGTH UNLESS SPECIFICALLY AUTHORIZED

NOTE: ALL PIPE FROM HOUSE TO SEPTIC TANK MUST BE CAST IRON OR SCHEDULE 35/40 PVC OR ABS

NOTE: MANHOLE RISERS REQUIRED ON ALL SEPTIC TANKS AND PUMP CHAMBERS

NOTE: DISTRIBUTION BOXES MUST HAVE BAFFLES

NOTE: IF PUMPED SEPTIC SYSTEM REQUIRED, (1) SEPTIC PUMP DETAIL TO BE PROVIDED BY INSTALLER PRIOR TO ISSUANCE OF SEPTIC PERMIT (2) PUMP PERFORMANCE TEST IS NECESSARY PRIOR TO HEALTH DEPARTMENT APPROVAL OF SEPTIC PERMIT

NEITHER THE HOWARD COUNTY COUNCIL NOR THE HEALTH DEPARTMENT IS RESPONSIBLE FOR THE SUCCESSFUL OPERATION OF ANY SYSTEM


PERMITTEE RESPONSIBLE FOR OBTAINING FINAL APPROVAL ON THIS PERMIT

CALL 410-313-2640 FOR INSPECTION OF SEPTIC SYSTEM

P 515293

Test Hole  
 2' Red Br Sa Clay Loam  
 14.5' Beige Sa Loam ~ 10% Rock

NOT TO SCALE

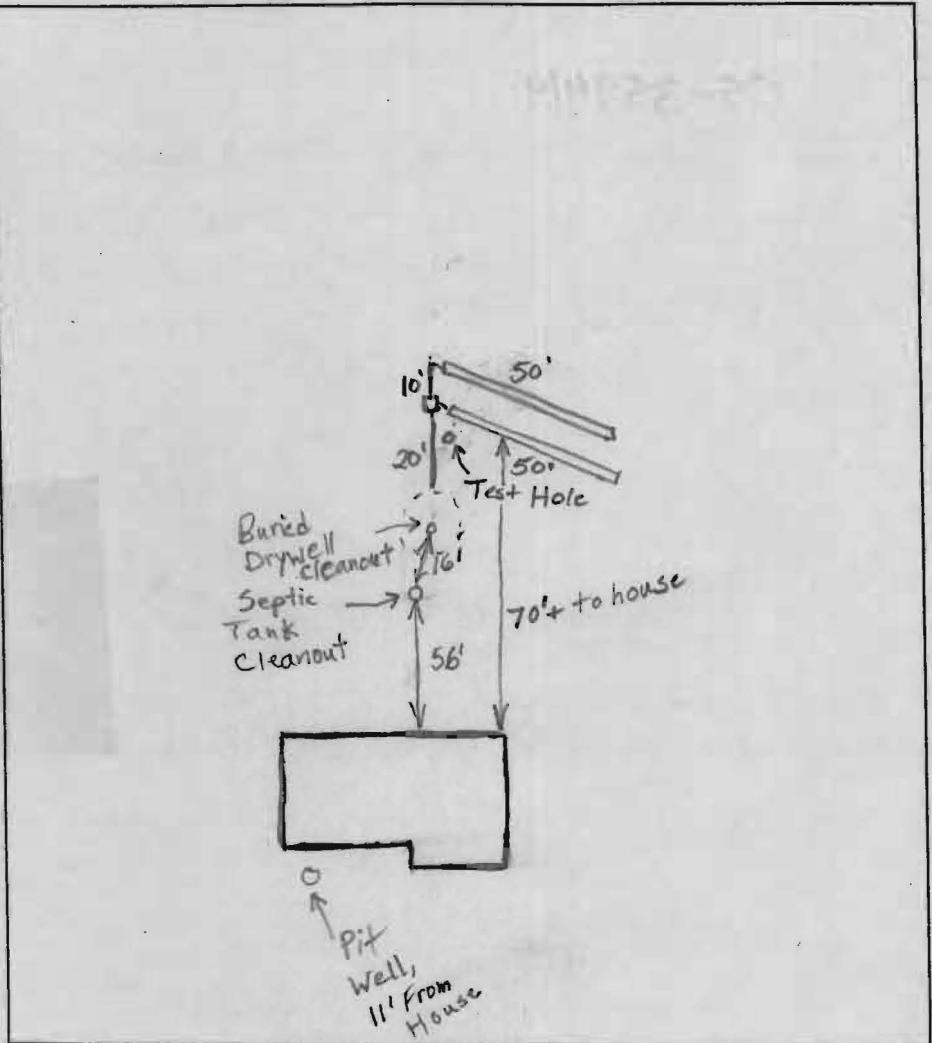

**TRENCH DATA**

TRENCH WIDTH 2

TRENCH INLET DEPTH 2.5'

TRENCH BOTTOM DEPTH 9.0'

DEPTH OF STONE 6.5'

NUMBER OF TRENCHES 2

TOTAL TRENCH LENGTH 100'

ABSORBENT AREA 650 sq ft

DISTRIBUTION BOX LEVEL Yes

BAFFLE IN DISTRIBUTION BOX Yes

**SEPTIC TANK DATA**

SEPTIC TANK approx. 1000 GALLONS

MANHOLE RISER No

6 INCH INSPECTION PORT Yes

**PUMP CHAMBER DATA** N/A

~~PUMP CHAMBER GALLONS \_\_\_\_\_~~

~~MANHOLE RISER \_\_\_\_\_~~

~~ALARM \_\_\_\_\_~~

~~PUMP PERFORMANCE TEST \_\_\_\_\_~~

PRE-CONSTRUCTION INSPECTION: Hunting Lane 6/15/01 2-46' trenches to be installed off of a

distribution box towards right lot line. (BB)

INSPECTION COMMENTS: 6/18/01 House built in 1958. Good soil. Original

drywell lasted ~40 years. System O.K. to cover. (BB)

\_\_\_\_\_

\_\_\_\_\_

INSPECTOR B. Baker DATE SYSTEM APPROVED 6/18/01