

PERMIT

SEWAGE DISPOSAL SYSTEM

A 07125 A 514935-A

MARYLAND STATE DEPARTMENT OF HEALTH

HOWARD COUNTY

ELLICOTT CITY

DISTRICT 5

DATE 12/2/63

RPS# 347777

INDEXED

Frank Robbins

IS PERMITTED TO INSTALL ALTER

ADDRESS _____ PHONE _____

A SEWAGE DISPOSAL SYSTEM LOCATED AT _____

SUBDIVISION Holiday Hills 10825 Hunting Lane ROAD LOT 55, sec. 5

PROPERTY OWNER Frank Robbins

ADDRESS _____

SPECIFICATIONS for 3 bedrooms - Leaching Bed - 30' X 19' with longest part of bed parallel with Hunting Lane.

DRAIN FIELD _____ DEPTH _____ FEET. BOTTOM AREA _____ SQ. FT.

SEEPAGE FITS _____ ABSORBENT SIDE-WALL AREA _____ SQ. FT.

SEPTIC TANK CAPACITY 750 GALLONS

FOR GARBAGE GRINDER, INCREASE DISPOSAL AREA 22% & TANK CAPACITY 50%.

OTHER Place system between 10 and 45 ft. from front lot line and between 60 and 100 ft. from right lot line as seen when facing lot from Hunting Lane. Leaching Bed shall not exceed 5 ft. depth including gravel at point nearest right lot line.

PLANS APPROVED BY D. Monaghan DATE 8/8/63

FILL SEPTIC TANK AND DISTRIBUTION BOX WITH WATER BEFORE CALLING FOR AN INSPECTION. COVER NO WORK UNTIL INSPECTED AND APPROVED.

NEITHER THE HOWARD COUNTY COMMISSIONERS NOR THE HEALTH DEPARTMENT IS RESPONSIBLE FOR THE SUCCESSFUL OPERATION OF ANY SYSTEM.


BLDG PERMITS SIGNED AND RETURNED 2/14/2001 B00128486 FAMILY ROOM

BLDG PERMITS SIGNED AND RETURNED 5/17/01

B00130292 - internal alterations to finish addition into bedroom

A 07125 514935-A

$$\begin{array}{r} 19 \\ 34 \\ \hline 53 \\ 576 \\ \hline 646 \\ 576 \\ \hline 76 \end{array}$$

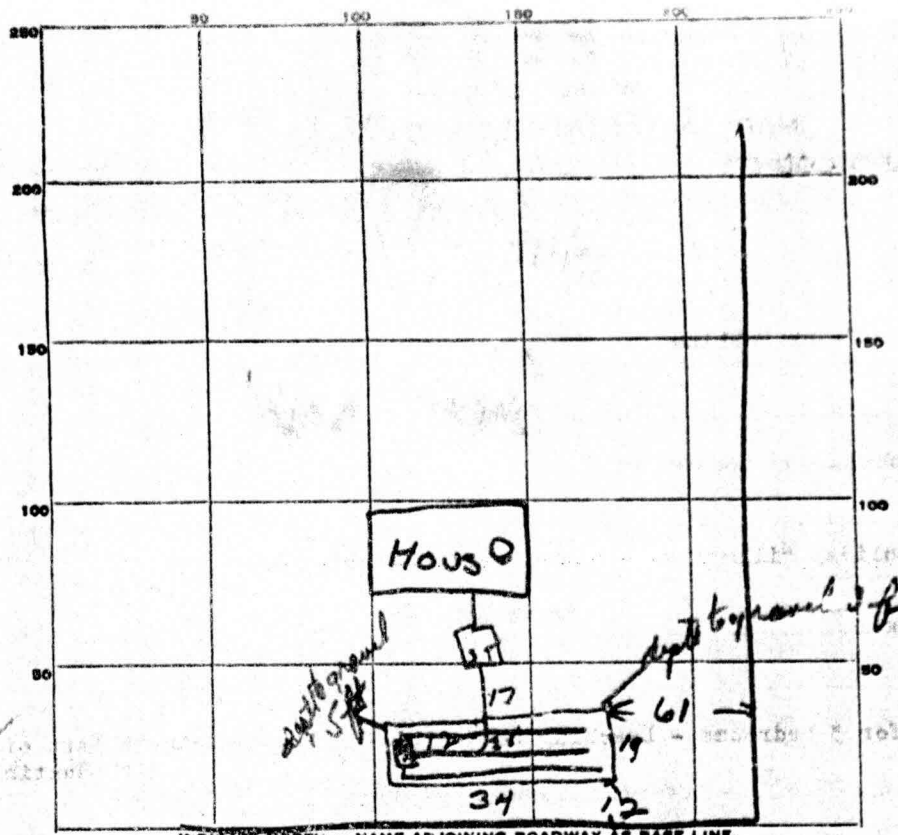

INDICATE NORTH. - NAME ADJOINING ROADWAY AS BASE LINE.

PERMIT CARD not needed any at
 SEPTIC TANK, LEVEL OK - 100 gal concrete. CLEANOUTS OK
 DISTRIBUTION BOX, LEVEL OK
 TILE FIELD, DEPTH 3 ft TRENCH WIDTH 19 FT.
 GRAVEL DEPTH 2.4 IN. TRENCH LENGTH 34 FT.
 NUMBER OF TRENCHES _____ TOTAL BOTTOM AREA 646 sq ft
 SEEPAGE PITS, INSIDE DIAMETER _____ FT. DEPTH BELOW INLET _____ FT.
 ABSORBENT AREA _____ SQ. FT.

REMARKS 12/5/63 - not enough gravel under distributor pipe only 1 1/2 ft - should be 3 ft - not enough gravel over pipe - only 2" - should be 8"
Bed to deep at pt closest to right side line.
OK to approve because bed is 2500 gal length required - 595 gal in 76 sq ft larger than required.

DATE SYSTEM APPROVED 12/5/63 INSPECTOR W. Monaghan