

12/3/01
11:00
Layout

12/5/01
P.M.
Follow up

12/7/01 - P.M. = Follow up

12/10/01
Final PM

ISSUE DATE: 11/29/2001

APPROVAL DATE: 12-10-01

PERMIT INDEXED

P 516430-A

A 59914-Y

ON-SITE SEWAGE DISPOSAL SYSTEM HOWARD COUNTY HEALTH DEPARTMENT BUREAU OF ENVIRONMENTAL HEALTH TAX ID # 04-363906

Fogles Septic Clean, Inc IS PERMITTED TO INSTALL ALTER

ADDRESS: 580 Obrecht Road PHONE NUMBER: 410-795-5670

SUBDIVISION: Monticello LOT NUMBER: 44

ADDRESS: 14301 Fox Creek Court PROPERTY OWNER: D.R. Horton

SEPTIC TANK CAPACITY (GALLONS): 1250 (TOPSEAM) **BUILDING PERMIT SIGNED**

PUMP CHAMBER CAPACITY (GALLONS): N/A **AND RETURNED**
9-23-04 800158485-GAZEBO

NUMBER OF BEDROOMS: 4

SQUARE FEET PER BEDROOM: 180

LINEAR FEET OF TRENCH REQUIRED: 240

| | |
|-----------|--|
| TRENCHES: | Trench to be <u>3</u> feet wide. Inlet <u>4</u> feet below original grade. Bottom maximum depth 6.0 feet below original grade. Effective area begins at 3.0 feet below original grade. <u>2</u> feet of stone below distribution pipe. - 2' of stone |
| LOCATION: | Begin trenches 115 feet up the right lot line and 90 feet off that same lot line as seen when facing the lot from Fox Creek Court. Run trenches on contour in both directions. |
| NOTES: | |


PLANS APPROVED: Amy Mc Millen OK SRK 6/28/01 DATE: 6-27-01

- NOTE: PERMIT VOID AFTER 2 YEARS
- NOTE: CONTRACTOR RESPONSIBLE FOR SCHEDULING A PRE-CONSTRUCTION INSPECTION FOR ALL INSTALLATIONS
- NOTE: WATERTIGHT SEPTIC TANKS REQUIRED
- NOTE: ALL PARTS OF SEPTIC SYSTEM SHALL BE 100 FEET FROM ANY WATER WELL
- NOTE: MANHOLE RISERS REQUIRED ON ALL SEPTIC TANKS AND PUMP CHAMBERS

NEITHER THE HOWARD COUNTY COUNCIL NOR THE HEALTH DEPARTMENT IS RESPONSIBLE FOR THE SUCCESSFUL OPERATION OF ANY SYSTEM PERMITTEE RESPONSIBLE FOR OBTAINING FINAL APPROVAL ON THIS PERMIT CALL 410-313-2640 FOR INSPECTION OF SEPTIC SYSTEM

AS9914-T

NOT TO SCALE

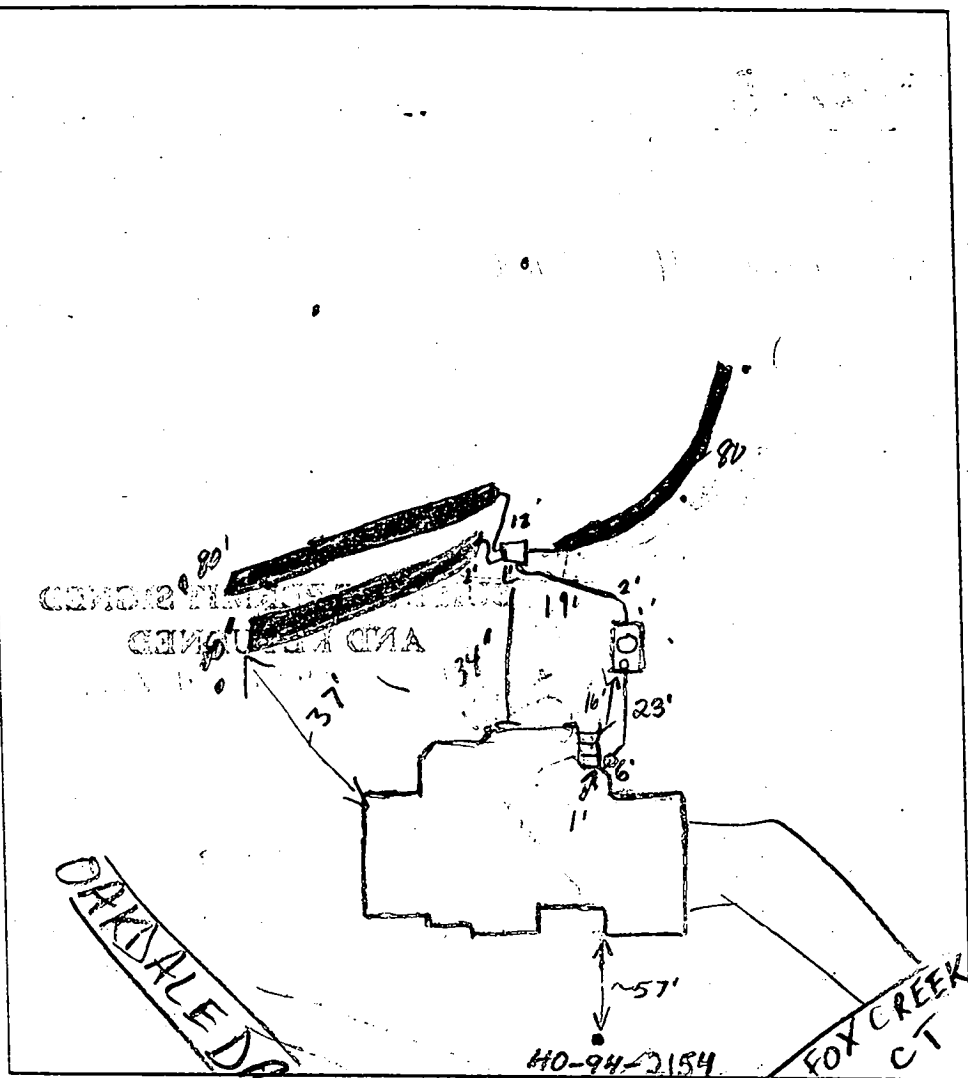

| TRENCH DATA | |
|----------------------------|-------------------------------------|
| TRENCH WIDTH | <u>3'</u> |
| TRENCH INLET DEPTH | <u>4'</u> |
| TRENCH BOTTOM DEPTH | <u>6'</u> |
| DEPTH OF STONE | <u>2'</u> |
| NUMBER OF TRENCHES | <u>3'</u> |
| TOTAL TRENCH LENGTH | <u>240'</u> |
| ABSORBENT AREA | <u>720 sq'</u> |
| DISTRIBUTION BOX LEVEL | <input checked="" type="checkbox"/> |
| BAFFLE IN DISTRIBUTION BOX | <input checked="" type="checkbox"/> |

| SEPTIC TANK DATA | |
|------------------------------|------------------------|
| SEPTIC TANK | <u>1250 TS</u> GALLONS |
| MANHOLE RISER | <u>on center - 42"</u> |
| 6 INCH INSPECTION PORT | <u>on front - 48"</u> |
| PUMP CHAMBER DATA <u>N/A</u> | |
| PUMP CHAMBER GALLONS | _____ |
| MANHOLE RISER | _____ |
| ALARM | _____ |
| PUMP PERFORMANCE TEST | _____ |

PRE-CONSTRUCTION INSPECTION: 12/3/01 Easement staked. To squeeze in

three 30' trenches with box in center of easement. (SR)

INSPECTION COMMENTS: 12/5/01 - INSTALLER PUT D. BOX IN DIFFERENT LOCATION THAN AGREED AT LAYOUT - (THIS IS UNACCEPTABLE) D. BOX MUST BE SET PER PLAN, SPECS CHANGED TO 3' WIDE, 4' INLET & 6' BOTTOM - DUE TO OBSERVATION OF CLAY IN EXCAVATIONS, PROCEED PER PLAN - (SR) 12/7/01 OK TO cover up to S.T. (SR) 12-10-01 OK TO COVER (KG/MR)

INSPECTOR Goedeking, Kacie DATE SYSTEM APPROVED 12-10-01

