

*1/28/72  
Ready after 3 PM  
1/28/72 Ready P.M.*

# PERMIT

SEWAGE DISPOSAL SYSTEM

MARYLAND STATE DEPARTMENT OF HEALTH

HOWARD COUNTY

**INDEXED**

ELLICOTT CITY

DISTRICT 3

DATE 1/25/72

P 16691

A 14707

Donald S. Watts Plumbing & Heating PERMITTED TO INSTALL X (ALTER)

ADDRESS 227 Main Street, Reisterstown, Md. PHONE 833-1733  
21136

A SEWAGE DISPOSAL SYSTEM LOCATED AT \_\_\_\_\_

SUBDIVISION Woodmark, Inc. ROAD Benson Branch Rd. LOT 27, Blk. A, Sec. 6

PROPERTY OWNER Mr. and Mrs. J. Francomacaro

ADDRESS \_\_\_\_\_

SPECIFICATIONS - 4 bedrooms

DRAIN FIELD \_\_\_\_\_ DEPTH \_\_\_\_\_ FEET, BOTTOM AREA \_\_\_\_\_ SQ. FT.

SEEPAGE PITS \_\_\_\_\_ ABSORBENT SIDE-WALL AREA \_\_\_\_\_ SQ. FT.

SEPTIC TANK CAPACITY 1,250 GALLONS

FOR GARBAGE GRINDER, INCREASE DISPOSAL AREA 22% & TANK CAPACITY 50%.

OTHER Dry well - 400 sq. ft. sidewall area below the inlet.

Inlet of dry well to be no deeper than 5 ft. and bottom of dry well to be no deeper than 11 ft. Place the dry well 135 ft. from the front lot line and 35 ft. from the left side of the lot as seen when facing the lot from

Benson Branch Road. PERM T VOID AFTER THREE YEARS.

NOTE: ALL PIPE FROM HOUSE TO SEPTIC TANK MUST BE CAST IRON.


PLANS APPROVED BY Raymond Hodges DATE 8/27/71

NOTE: INSTALL STAND PIPE ON DRY WELL AND SEPTIC TANK. FILL SEPTIC TANK AND DISTRIBUTION BOX WITH WATER BEFORE CALLING FOR AN INSPECTION. COVER NO WORK UNTIL INSPECTED AND APPROVED.

NEITHER THE HOWARD COUNTY COMMISSIONERS NOR THE HEALTH DEPARTMENT IS RESPONSIBLE FOR THE SUCCESSFUL OPERATION OF ANY SYSTEM.

*10/1/72*

47  
23  
111

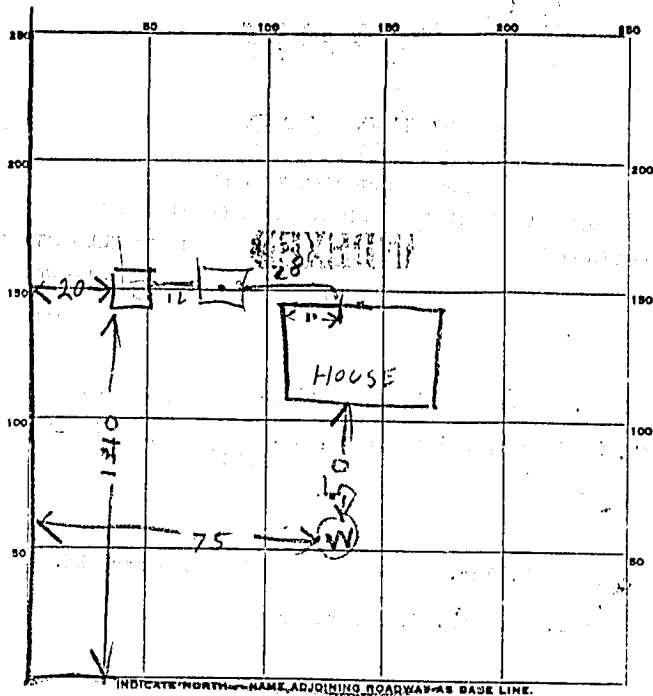

PERMIT CARD \_\_\_\_\_  
 SEPTIC TANK, LEVEL OK 1250 concrete CLEANOUTS \_\_\_\_\_  
 DISTRIBUTION BOX, LEVEL \_\_\_\_\_  
 TILE FIELD, DEPTH \_\_\_\_\_ FT. TRENCH WIDTH \_\_\_\_\_ FT.  
 GRAVEL DEPTH \_\_\_\_\_ IN. TOTAL LENGTH \_\_\_\_\_ FT.  
 NUMBER OF TRENCHES \_\_\_\_\_ TOTAL BOTTOM AREA \_\_\_\_\_

SEEPAGE PITS, INSIDE DIAMETER 12 FT. DEPTH BELOW INLET 7 1/2 FT.  
 ABSORBENT AREA 277 SQ. FT. not counting stone  
counting slope

REMARKS 1/27/72 - OK to cover tank & house  
Sewer. Finish dig walls call  
Permit of Dig. call - 5 ft

DATE SYSTEM APPROVED 1/28/72 INSPECTOR Raymond Hodges