


OK  
8-14-02

*Chas Jones*

10/06/2002 HYDE PARK  
ELEV. 'D'  
1"=50'

**FREDERICK WARD ASSOCIATES, INC.**  
7125 Riverwood Drive Columbia, Maryland 21046-2354  
Phone: 410-290-9550 Fax: 410-720-6228  
Bel Air, Maryland Columbia, Maryland Warrenton, Virginia

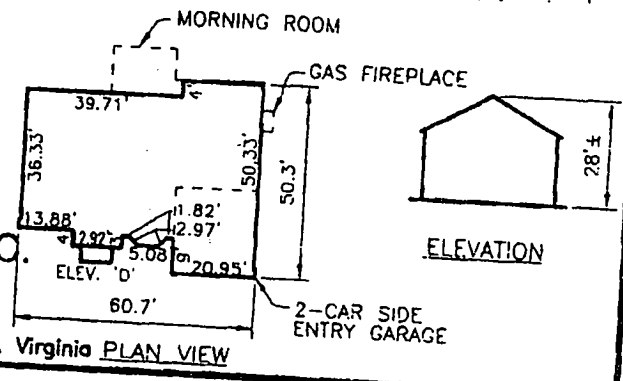

E 1"=50'  
BY CMH  
DRAWN BY JCO  
JULY 2002  
# 2019035.00  
# 1 OF 1

TAX MAP 15 BLOCKS 12 & 18  
TAX MAP BLOCKS 7 & 13  
3RD ELECTION DISTRICT

**NVHomes  
FOX CREEK SUBDIVISION  
LOT 5**

PARCEL '183'  
HOWARD COUNTY, MARYLAND

3/18/04 8' distance from well to deck granted  
B00146826 (KN) (SB ok'd closer dist. on 3/17/04)

