

TENNAANT PROPERTY

COUNTY # _____

SOIL PROFILE

• 237	• 238	• 239	• 240
• 228	• 229	• 230	• 231
• 222	• 223	• 224	• 225
• F 216	• F (as 217 to stream)	• F 218	• H 219

SOIL PROFILE

INDICATE NORTH - NAME ADJOINING ROADWAY AS BASE LINE.

Frederick Road

DATE	TEST NO.	DEPTH	PRE-WET		TEST - 1" DROP		TIME
			START	STOP	START	STOP	

see attached


REMARKS _____

TYPE OF SOIL _____

TESTED BY D. Soe ALSO PRESENT C. Lepp

TRENCH DESIGN DATA: AVERAGE PERCOLATION TIME _____ TRENCH WIDTH _____

INLET DEPTH _____ MAXIMUM BOTTOM DEPTH _____ SQ. FT./BEDROOM _____

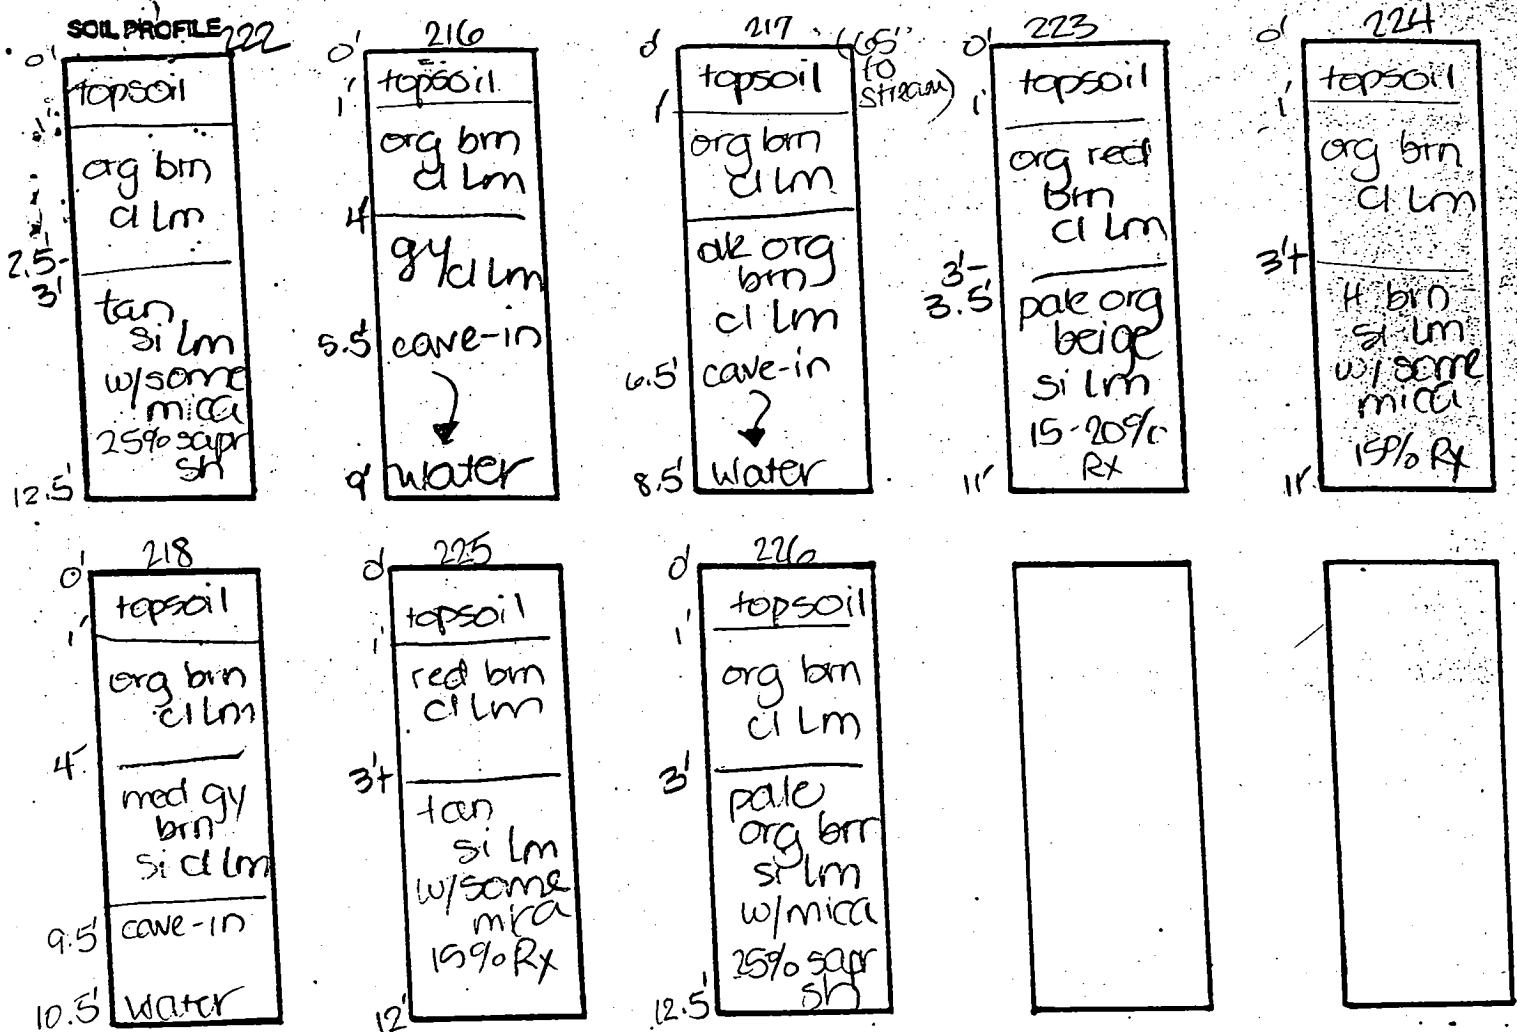

DATE	TEST NO.	DEPTH	PRE-WET		TEST - 1" DROP		TIME
			START	STOP	START	STOP	
6-1-09	222	2.5' S	1:35	1:45	1:45	2:00	15
		12.5' D	Visual	- see	profile		OK
	216	9.0' D	Water	- see	profile		FAIL
	217	8.5' D	Water	- see	profile		FAIL
	223	3.5' S	1:47	1:50	1:50	1:54	4
		11.0' D	Visual	- see	profile		OK
	224	3.0' S	1:53	1:55	1:55	1:58	3
		11.0' D	Visual	- see	profile		OK
	218	10.5' D	Water	- see	profile		FAIL
	225	2.5' S	2:05	2:20	2:20	little slow	OK below
		12.0' D	Visual	- see	profile		OK
	226	3.0' S	2:11	2:17	2:17	2:25	8
		12.5' D	Visual	- see	profile		OK

TESTED BY D. SOE

ALSO PRESENT C. ZEPPE

