

APPLICATION

PERCOLATION TESTING

A 40874

P _____

HOWARD COUNTY HEALTH DEPARTMENT
BUREAU OF ENVIRONMENTAL HEALTH
P.O. BOX 476 ELLICOTT CITY, MARYLAND 21043
TELEPHONE: 461-9933

DISTRICT Fourth

DATE 12-15-87

TO: THE COUNTY HEALTH OFFICER
ELLICOTT CITY, MARYLAND

I HEREBY APPLY FOR THE NECESSARY TEST IN ORDER TO CONSTRUCT (OR RECONSTRUCT) A SEWAGE DISPOSAL SYSTEM.

PROPERTY OWNER Long Meadow Venturers Jon + Connie Casamonte

ADDRESS 7050 Oakland Mills Road Suite 100 PHONE 301-963-7062
301-290-9494

PROSPECTIVE BUYER Columbia, MD 21046

ADDRESS Attention: Mr. Earl Armiger PHONE _____

PROPERTY LOCATION:

SUBDIVISION Foxmoor LOT NO. 21 LOT 11 Prelimin.

ROAD AND DESCRIPTION End of Timberleigh Way (17740 Foxmoor Drive)

TAX MAP 12 PARCEL # 16

SIZE OF LOT 3.0 Acres TYPE BLDG Single Family
(SINGLE FAMILY DWELLING OR COMMERCIAL)

THE SYSTEM INSTALLED UNDER THIS APPLICATION IS ACCEPTABLE ONLY UNTIL PUBLIC FACILITIES BECOME AVAILABLE. I FULLY UNDERSTAND THE FEE CONNECTED WITH THE FILING OF THIS PERC TEST APPLICATION IS NON-REFUNDABLE UNDER ANY CIRCUMSTANCES. I ALSO AGREE TO COMPLY WITH ALL M.O.S.H.A. REQUIREMENTS IN TESTING THIS LOT.

Jeffrey E. Frank agent
(SIGNATURE OF APPLICANT)

APPROVED BY Sid Clark FOR Standard Trenches DATE 2-21-89

REJECTED BY _____ FOR _____ DATE _____

HOLD PENDING FURTHER TESTS _____ DATE _____


REASONS FOR REJECTION OR HOLDING 3-8-88 Re-eval Satisfactory - Hold for PEAT S&B

SHALLOW SYST. TOP SPAN SEPTIC TANK - PLACE SEPTIC TANK AT HIGH
note in Peat. Field. (SA)

BLDG. PERMIT SIGNED
AND RETURNED 9/28/88
Serial # 50433-SFD-4Bms

THIS IS NOT A PERMIT

HD-216

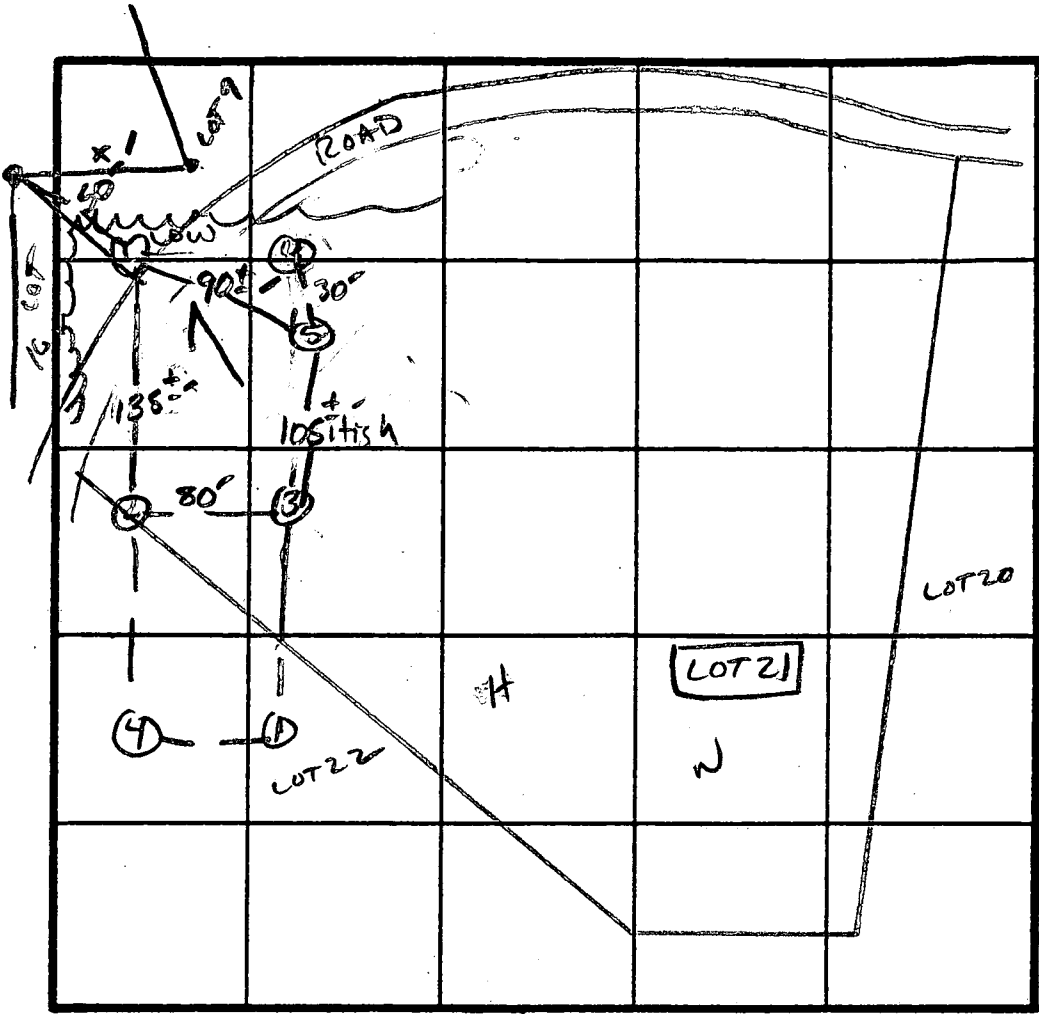

X Perc 9min
 190 #1 BA
 Inlet 35
 Bottom 6.5
 3' wide

SOIL PROFILE

0	AP
6"	Yell BA CLAYLN 20-25% SHARP FRAGS
4"	Yell. BA TO BR. Silt loam 25-35% FRAGS
15"	

INDICATE NORTH - NAME ADJOINING ROADWAY AS BASE LINE.

Florence Rd.

DATE	TEST NO.	DEPTH	PRE-WET		TEST - 1" DROP		TIME	
			START	STOP	START	STOP		
3/8/88	1S	4.5'	2:30	2:35	2:35	2:49	14min	
	1M	9.5'	2:31	2:35	2:35	2:45	10min	
	1V	13'	uniform below 4'					
	2S	5'	2:35	2:37	2:37	2:41	4 min	
	2M	8'	2:37	2:43	2:43	2:55	12min	
	2V	12'	SIMILAR TO #1 MORE COARSE FRAGS AT 11-12" 40-50%					
	3S	4.5'	2:44	2:46	2:46	2:51	5min	
	3M	8.5'	2:44	2:49	2:49	2:55	6min	
	3V	11.5'	See Profile					
	4V	STRUCTURED AT 6.5'						
	5S	4'	2:48	2:52	2:52	2:59	7min	
	5M	8.5'	2:53	2:59	2:59	3:07	8min	
	5V	11'	SAME AS #2					

0	AP
6"	Yell BA CLAYLN 20-25% FRAGS
4"	Yellow BA TO BROWN Silt loam 35-45% FRAGS
	50% a bit 2 A+ 11"

REMARKS Holes DIFF THAN PLAT - shallow test only

TYPE OF SOIL Mt Airy MANDAL

TESTED BY S. Abel ALSO PRESENT Kenny Dave