

**HOWARD COUNTY
 PERMIT APPLICATION**

PERMIT NUMBER

B090-2757

Building Address 6731 Mink Hollow rd
Highland MD

Suite/Apt. #: _____ SDP/WP/Petition #: _____

Census Tract _____ Subdivision _____

Section _____ Area _____ Lot _____

Tax Map _____ Parcel _____ Grid _____

Zoning _____ Map Coordinates _____ Lot size _____

Property Owner's Name Terry Gray

Address 6731 Mink Hollow rd

City Highland State MD Zip Code 20747

Phone 301-451-2757 Phone 410-460-3417

Applicant's Name & Mailing Address, (if other than stated hereon): _____

Phone _____ Fax _____

Existing Use Residential

Proposed Use Garage/Barn

Estimated Construction Cost \$ 5,000.00

Description of Work Garage - Barn
Demolished, 24 x 57

Contractor Company OWNER

Contact Person Terry Gray

Address _____

City _____ State _____ Zip Code _____

License No. _____

Phone _____ Fax _____

Occupant or Tenant _____

Contact Name _____

Address _____

City _____ State _____ Zip Code _____

Phone _____ Fax _____

Engineer or Architect Company _____

Contact Person _____

Address _____

City _____ State _____ Zip Code _____

Phone _____ Fax _____

BUILDING DESCRIPTION - COMMERCIAL

BUILDING DESCRIPTION - RESIDENTIAL

Building Characteristics	Utilities
Height: _____	Water Supply: _____ _____ Public _____ Private
No. of stories: _____	Sewage Disposal: _____ _____ Public _____ Private
Gross area, sq. ft. per floor: _____	Electric Yes <input type="checkbox"/> No <input type="checkbox"/>
Use group: _____	Gas Yes <input type="checkbox"/> No <input type="checkbox"/>
Construction type: _____ Reinforced Concrete _____ Structural Steel _____ Masonry _____ Wood Frame	Heating System: Electric <input type="checkbox"/> Oil <input type="checkbox"/> Natural Gas <input type="checkbox"/> Propane Gas <input type="checkbox"/>
_____ State Certified Modular	Sprinkler system: N/A <input type="checkbox"/> _____ Full _____ Partial _____ Other Suppression _____ # of Heads

Building Characteristics	Utilities
SF Dwelling <input type="checkbox"/> SF Townhouse <input type="checkbox"/> _____ Depth _____ Width _____	Water Supply: _____ _____ Public _____ Private
1st floor: _____	Sewage Disposal: _____ _____ Public _____ Private
2nd floor: _____	Electric Yes <input type="checkbox"/> No <input type="checkbox"/>
Basement: _____	Gas Yes <input type="checkbox"/> No <input type="checkbox"/>
Finished Basement <input type="checkbox"/> Unfinished Basement <input type="checkbox"/>	Heating System: Electric <input type="checkbox"/> Oil <input type="checkbox"/>
Crawl space <input type="checkbox"/> Slab on Grade <input type="checkbox"/>	Natural Gas <input type="checkbox"/>
No. of Bedrooms _____	Propane Gas <input type="checkbox"/>
Height: _____	Sprinkler system: N/A <input type="checkbox"/> _____ NFPA #13D _____ NFPA #13R _____ Other:
Multi-family dwellings: No. of efficiency units: _____ No. of 1 BR units: _____ No. of 2 BR units: _____ No. of 3 BR units: _____	
Other Structure: _____	
Dimensions: _____	
Footings: _____	
Roof Height: _____	
_____ State Certified Modular	
_____ Manufactured Home	

THE UNDERSIGNED HEREBY CERTIFIES AND AGREES AS FOLLOWS: (1) THAT HE/SHE IS AUTHORIZED TO MAKE THIS APPLICATION; (2) THAT THE INFORMATION IS CORRECT; (3) THAT HE/SHE WILL COMPLY WITH ALL REGULATIONS OF HOWARD COUNTY WHICH ARE APPLICABLE THERETO; (4) THAT HE/SHE WILL PERFORM NO WORK ON THE ABOVE REFERENCED PROPERTY NOT SPECIFICALLY DESCRIBED IN THIS APPLICATION; (5) THAT HE/SHE GRANTS COUNTY OFFICIALS THE RIGHT TO ENTER ONTO THIS PROPERTY FOR THE PURPOSE OF INSPECTING THE WORK PERMITTED AND POSTING NOTICES.

Terry Gray
 Applicant's Signature

OWNER
 Title/Company

Terry Gray
 Print Name

9-16-08
 Date

Checks payable to: **DIRECTOR OF FINANCE OF HOWARD COUNTY**
 ** PLEASE WRITE NEATLY AND LEGIBLY. **
FOR OFFICE USE ONLY

AGENCY	DATE	SIGNATURE	APPROVAL
Land Development, DPZ			
State Highways			
Building Official			
Dev. Engineering, DPZ			
Health	<u>10/3/08</u>	<u>[Signature]</u>	
Fire Protection			

Is Sediment Control approval required prior to issuance?
 YES NO

DPZ SETBACK INFORMATION	PROPERTY ID#:
Front: _____	Filing fee \$ _____
Rear: _____	Permit fee \$ _____
Side: _____	Excise tax \$ _____
Side St.: _____	Add'l per. fee \$ _____
All minimum setbacks met? YES <input type="checkbox"/> NO <input type="checkbox"/>	TOTAL FEES \$ _____
Is Entrance Permit required? YES <input type="checkbox"/> NO <input type="checkbox"/>	Sub-total paid \$ _____
Historic District? YES <input type="checkbox"/> NO <input type="checkbox"/>	Balance due \$ _____
Lot Coverage for NewTown Zone _____	Check # _____
SDP/Red-line approval date _____	Validation # _____

CONTINGENCY CONSTRUCTION START:

ONE STOP SHOP:

Distribution of Copies- White: Building Official Green: LDD, DPZ

Accepted by _____

Yellow: DED, DPZ Pink: Health Gold: SHA

TO: Avis L. Corbin

Scanned by [Signature] Date 9/24/08

I am asking to revise my plot plan, because when I submitted the original I did not place the new proposed building in the proper place. The address is 6731 Minik Hollow Rd Highland, MD 20727

RECEIVED

SEP 22 2008

LICENSES & PERMITS
DIVISION

Terry Gray owner

[Signature]

301 534-0253

Permit #

B08002757

[Signature] 10/3/08

PR

JUNE 5, 2001

cc: J P Z
6/4/01

2195
CR 39134
6-5-01
25

MS. AVES CORBIN

HOWARD COUNTY DEPARTMENT OF

LICENSES AND PERMITS

3430 COUNTRY CLUB DRIVE

ELLIOTT CITY, MARYLAND

REVIEWED FOR
CODE COMPLIANCE

DEPARTMENT OF INSPECTIONS,
LICENSES AND PERMITS DIVISION
HOWARD COUNTY

DATE:
BY: BOO 12775

SUBJECT TO COMMENTS OF LETTER
 SUBJECT TO FIELD INSPECTION
 SUBJECT TO COMMENTS ON PLANS
 SUBJECT TO AMENDMENT
 AMENDMENT FINAL

RECEIVED

JUN 05 2001

LICENSES & PERMITS DIVISION

LICENSES AND PERMITS DIVISION
2001 JUN -5 PM 1:52

RE: 6731 HUNK HOLLOW ROAD

PERMIT # BOO 12775

Dear Ms. Corbin

A request is hereby submitted to amend the above referenced building permit to include the following:

- 1) Add a 6' wide porch along the front portion of the house and to wrap approximately 9' along the left corner (4 copies of site plan attached)
- 2) Finish the 400 s.f. of garage space to include a bedroom, a sitting room, and a full bathroom.

Sincerely,

L. RAY PACHUBA, MEMBER

PACHUBA HOMEBUILDERS, LLC.

946 A MARIMICH COURT

ELDENSBURG MARYLAND 21764

OK
HoCo Health
6/15/01
UP


MINK HOLLOW ROAD

N 03°23'04" W
50.53'

INGRESS & EGRESS LOT #1
EASEMENT (30' x 20') FOR
PRESERVATION PARCEL 'A' & LOT #1
USE-IN-COMMON DRIVEWAY
EASMT & UTILITY EASMT.
(PRIVATE)

PRESERVATION
PARCEL 'X'
7.061 ACRES ±

- FIRST FLOOR SUBV. = 446.20
- B. FLOOR ELEV. = 437.20
- INVERT OUT HOUSE ELEV. = 435.20
- EX. GRD. @ SEPTIC TANK = 433.20
- INVERT IN " " = 435.20
- INVERT OUT " " = 435.20
- EX. GRD. @ PUMP CHAMBER = 439.20
- INVERT IN " " = 434.20
- INVERT OUT " " = 434.20
- EX. GRD. @ DISTR. BOX = 464.20
- INVERT IN " " = 460.20
- INVERT OUT " " = 460.20
- EX. GRD. @ TRENCHES = 464.20
- INVERT IN " " = 460.20

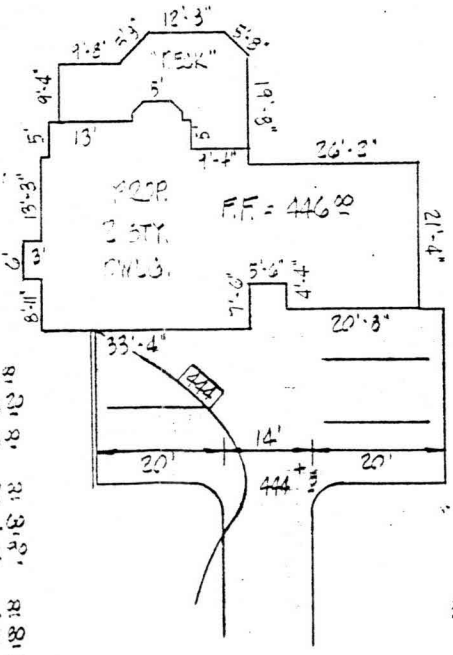

PLOT PLAN
FOR
PRESERVATION PARCEL 'A'
THE GUEL PROPERTY

A SUBDIVISION OF PARCEL 317
SINGLE-TR. DISTR. TAX MAP #40
HOWARD CO., MARYLAND.

SCALE: 1" = 100'
DATE: 2-13-2001

CHARLES R. CROCKEN & ASSOC., INC.
Civil Engineering & Land Planning
P.O. Box 307
Westminster, Maryland 21157
Tel. (410) 549-2708

REVISED

Date: 2-13-01
6731 Mink Hollow Rd
Comments: Normal SFD
3/2/01
OK (M)