

# APPLICATION

PERCOLATION TESTING

A 49810  
P \_\_\_\_\_

HOWARD COUNTY HEALTH DEPARTMENT  
BUREAU OF ENVIRONMENTAL HEALTH  
3525-H ELLICOTT MILLS DRIVE/ELLICOTT CITY, MARYLAND 21043  
TELEPHONE: 313-2840

*PREVIEW OK  
PROPOSAL IS TO  
EXPAND EXISTING  
EASER TO 4' TO 6' 2"  
1 NEW TEST FEE 225  
1 REPAIR TEST FEE 225  
\$250*

DISTRICT \_\_\_\_\_

DATE 12/15/93

*WGT SEASON  
TESTING 15-90'*

TO: THE COUNTY HEALTH OFFICER  
ELLICOTT CITY, MARYLAND

I HEREBY APPLY FOR THE NECESSARY TEST PRIOR TO APPLICATION FOR PERMIT TO CONSTRUCT (OR RECONSTRUCT) A SEWAGE DISPOSAL SYSTEM.

PROPERTY OWNER J THOMAS GUEEL

ADDRESS 7509 Cinnabar Ter Gaithersburg MD 20878 PHONE 301-330-6297

AGENT OR PROSPECTIVE BUYER Some

ADDRESS \_\_\_\_\_ PHONE \_\_\_\_\_

PROPERTY LOCATION:

SUBDIVISION Romualdo Property (New Gueel Property) LOT NO. \_\_\_\_\_

ROAD AND DESCRIPTION 6235 Mink Hollow Rd

TAX MAP 40 PARCEL # 317

SIZE OF LOT \_\_\_\_\_ TYPE BLDG. Subdiv for 2 Single Family  
(SINGLE FAMILY DWELLING OR COMMERCIAL)

THE SYSTEM INSTALLED UNDER THIS APPLICATION IS ACCEPTABLE ONLY UNTIL PUBLIC FACILITIES BECOME AVAILABLE. I FULLY UNDERSTAND THE FEE CONNECTED WITH THE FILING OF THIS PERC TEST APPLICATION IS NON-REFUNDABLE UNDER ANY CIRCUMSTANCES. I ALSO AGREE TO

COMPLY WITH ALL M.O.S.H.A. REQUIREMENTS IN TESTING THIS LOT. [Signature]  
(SIGNATURE OF APPLICANT)

APPROVED BY \_\_\_\_\_ FOR \_\_\_\_\_ DATE \_\_\_\_\_

DISAPPROVED BY \_\_\_\_\_ FOR \_\_\_\_\_ DATE \_\_\_\_\_

HOLD PENDING FURTHER TESTS \_\_\_\_\_

REASONS FOR REJECTION OR HOLDING \_\_\_\_\_


PERCOLATION TEST PLAT/PRELIMINARY PLAT - TITLE OR I.D. # \_\_\_\_\_ DATE \_\_\_\_\_

SITE DEVELOPMENT PLAN/FINAL PLAT - TITLE OR I.D. # \_\_\_\_\_ DATE \_\_\_\_\_

# THIS IS NOT A PERMIT

THE PURPOSE OF THIS DOCUMENT IS TO ADJUST THE ESTABLISHED SEPTIC EASEMENT.

5-7-96 - NOTE: HEALTH DEPT. RECORDS DO NOT INDICATE RECORDED SEWAGE EASEMENT. *Ch. Dwyer SANITARIAN*

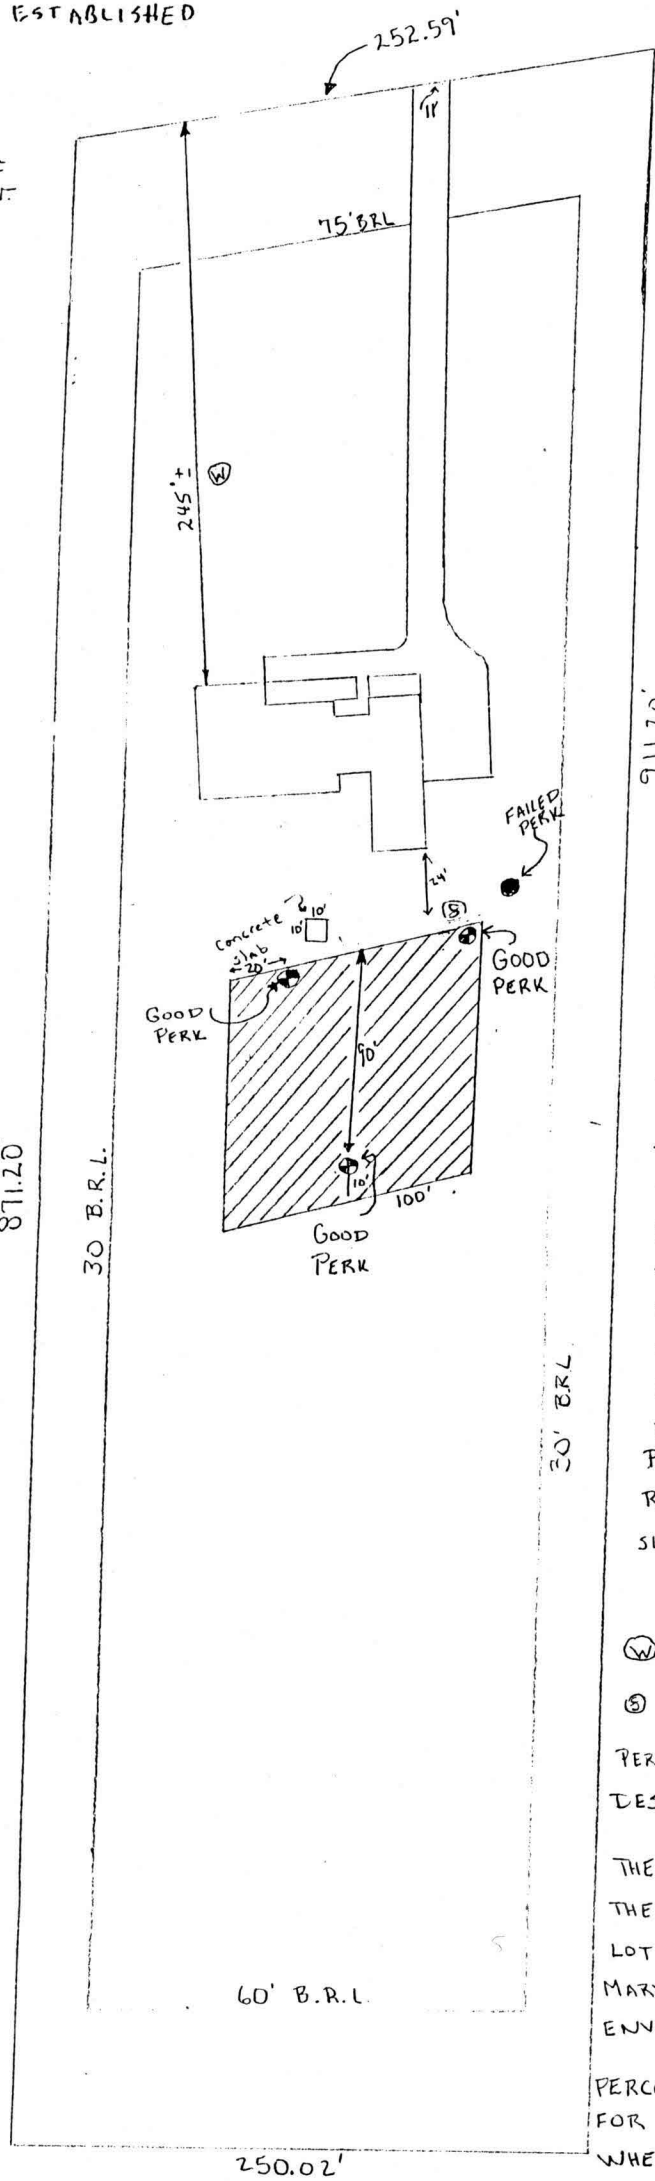

Post-It® Fax Note	7671	Date	7/2	# of pages	1
To	Charles Crocker	From	Amy		
Co/Dept.		Co.			
Phone #		Phone #			
Fax #	Property to Adj	Fax #	th of Guid Prop		

**THIS AREA DESIGNATES A PRIVATE SEWAGE EASEMENT OF AT LEAST 10,000 SQUARE FEET AS REQUIRED BY THE MARYLAND STATE DEPARTMENT OF ENVIRONMENT FOR INDIVIDUAL SEWERAGE DISPOSAL IMPROVEMENTS OF ANY NATURE. THIS AREA ARE RESTRICTED UNTIL PUBLIC SEWERAGE IS AVAILABLE. THIS EASEMENT SHALL BECOME NULL AND VOID UPON CONNECTION TO A PUBLIC SEWERAGE SYSTEM. THE COUNTY HEALTH OFFICER SHALL HAVE THE AUTHORITY TO GRANT VARIANCES FOR ENCROACHMENTS INTO THE PRIVATE SEWERAGE EASEMENT, RECORDATION OF A MODIFIED EASEMENT SHALL NOT BE NECESSARY.**

- ⊙ - well
- Ⓢ - septic tank

PERCOLATION TEST HOLES ARE DESIGNATED BY "⊕"

THE LOT SHOWN HEREON COMPLY WITH THE MINIMUM OWNERSHIP WIDTH AND LOT AREAS AS REQUIRED BY THE MARYLAND STATE DEPARTMENT OF THE ENVIRONMENT.

PERCOLATION AREAS AND WATER WELLS FOR ADJOINING LOTS HAVE BEEN SHOWN WHERE PERTINENT.

DANIEL L. PATRICIA J. BETZ RESIDENCE  
 0725 MINK HOLLOW ROAD  
 HIGHLAND MD. 20777

*[Signature]*

LIBER 666  
 FOLIO 735


APPROVED: FOR PRIVATE WATER AND PRIVATE SEWAGE SYSTEMS  
 HOWARD COUNTY HEALTH DEPARTMENT

*Joyce M. Boyd*  
 HOWARD COUNTY HEALTH OFFICER

6-13-96  
 DATE

A49800  
COUNTY #

FOR THE (LOW) LOT #1

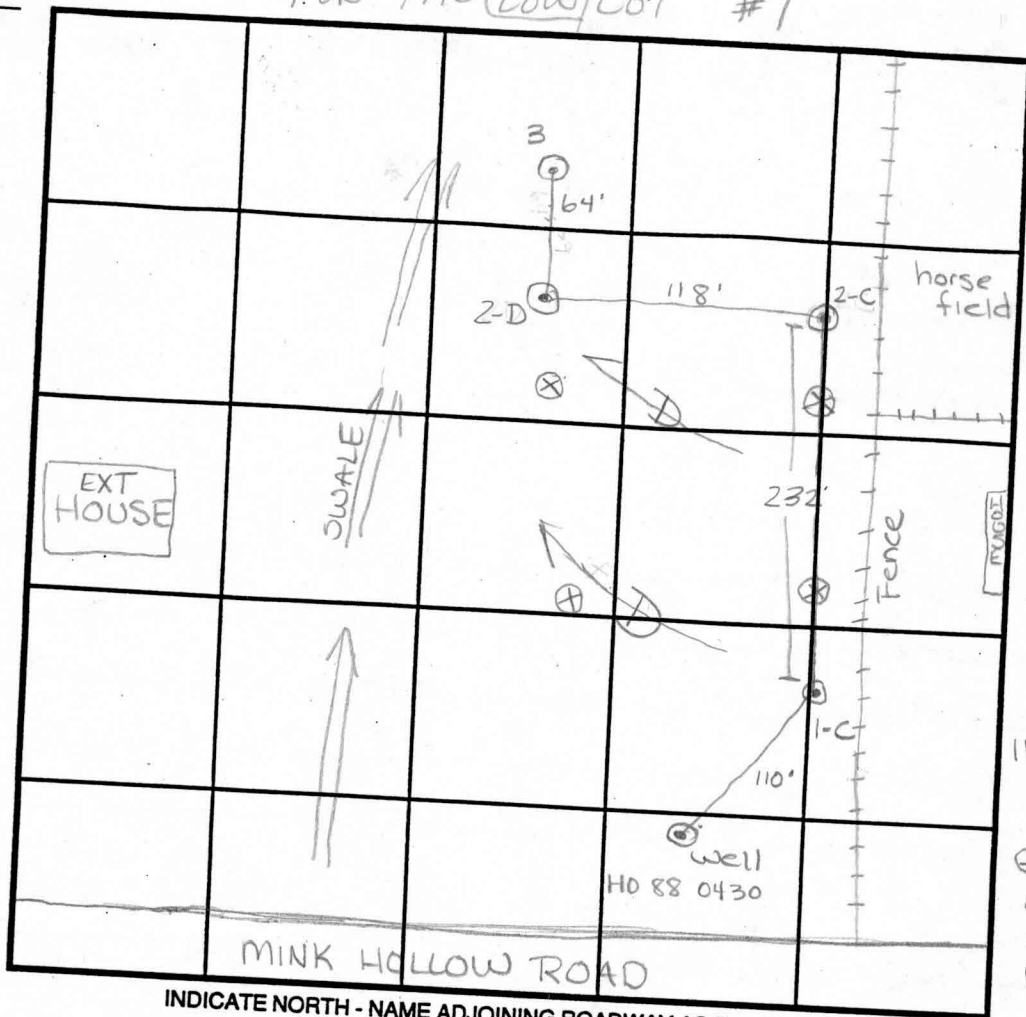

INDICATE NORTH - NAME ADJOINING ROADWAY AS BASE LINE.

SOIL PROFILE 3




⊕ previously approved test notes (approx. location only)


SOIL PROFILE 1-C



2c

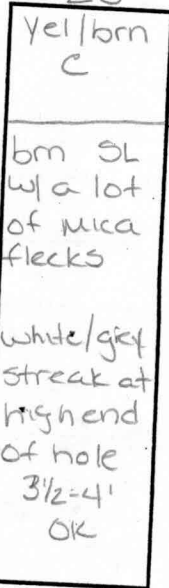

2D

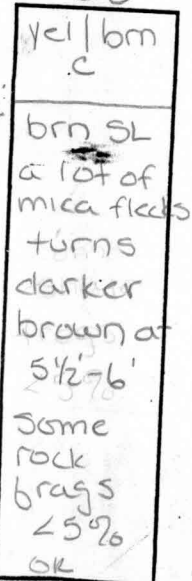

DATE	TEST NO.	DEPTH	PRE-WET		TEST - 1" DROP		TIME
			START	STOP	START	STOP	
2-14-94	1-C	6'	9:01 <sup>30</sup>	9:02 <sup>30</sup>	9:02 <sup>30</sup>	9:04	1 1/2 min
		9'	9:07 <sup>15</sup>	9:17	9:17	9:44 <sup>45</sup>	27 3/4 min
	2-C	6'	9:22 <sup>45</sup>	9:23 <sup>45</sup>	9:23 <sup>45</sup>	9:25 <sup>45</sup>	2 min
		9'	9:32 <sup>15</sup>	9:34 <sup>15</sup>	9:34 <sup>15</sup>	9:36 <sup>45</sup>	2 1/2 min
	2-D	5'	9:47 <sup>45</sup>	9:48 <sup>15</sup>	9:48 <sup>15</sup>	9:49 <sup>30</sup>	1 1/4 min
		8 1/2'	9:48 <sup>15</sup>	9:51	9:51	9:56	5 min
	3	6'	10:01	10:02 <sup>30</sup>	10:02 <sup>30</sup>	10:06	3 1/2 min
		9'	10:02 <sup>15</sup>	10:04	10:04	10:05 <sup>15</sup>	1 1/4 min

REMARKS well is lower than hole 1-C, shall only due to water in previous test notes

TYPE OF SOIL \_\_\_\_\_

TESTED BY A. McMillen / C. Williams ALSO PRESENT Tom Guice


TRENCH DESIGN DATA: AVERAGE PERCOLATION TIME 2 min TRENCH WIDTH 3"

INLET DEPTH 2'



# MINK HOLLOW RD

Perc. Cert  
Approved  
2.14.89

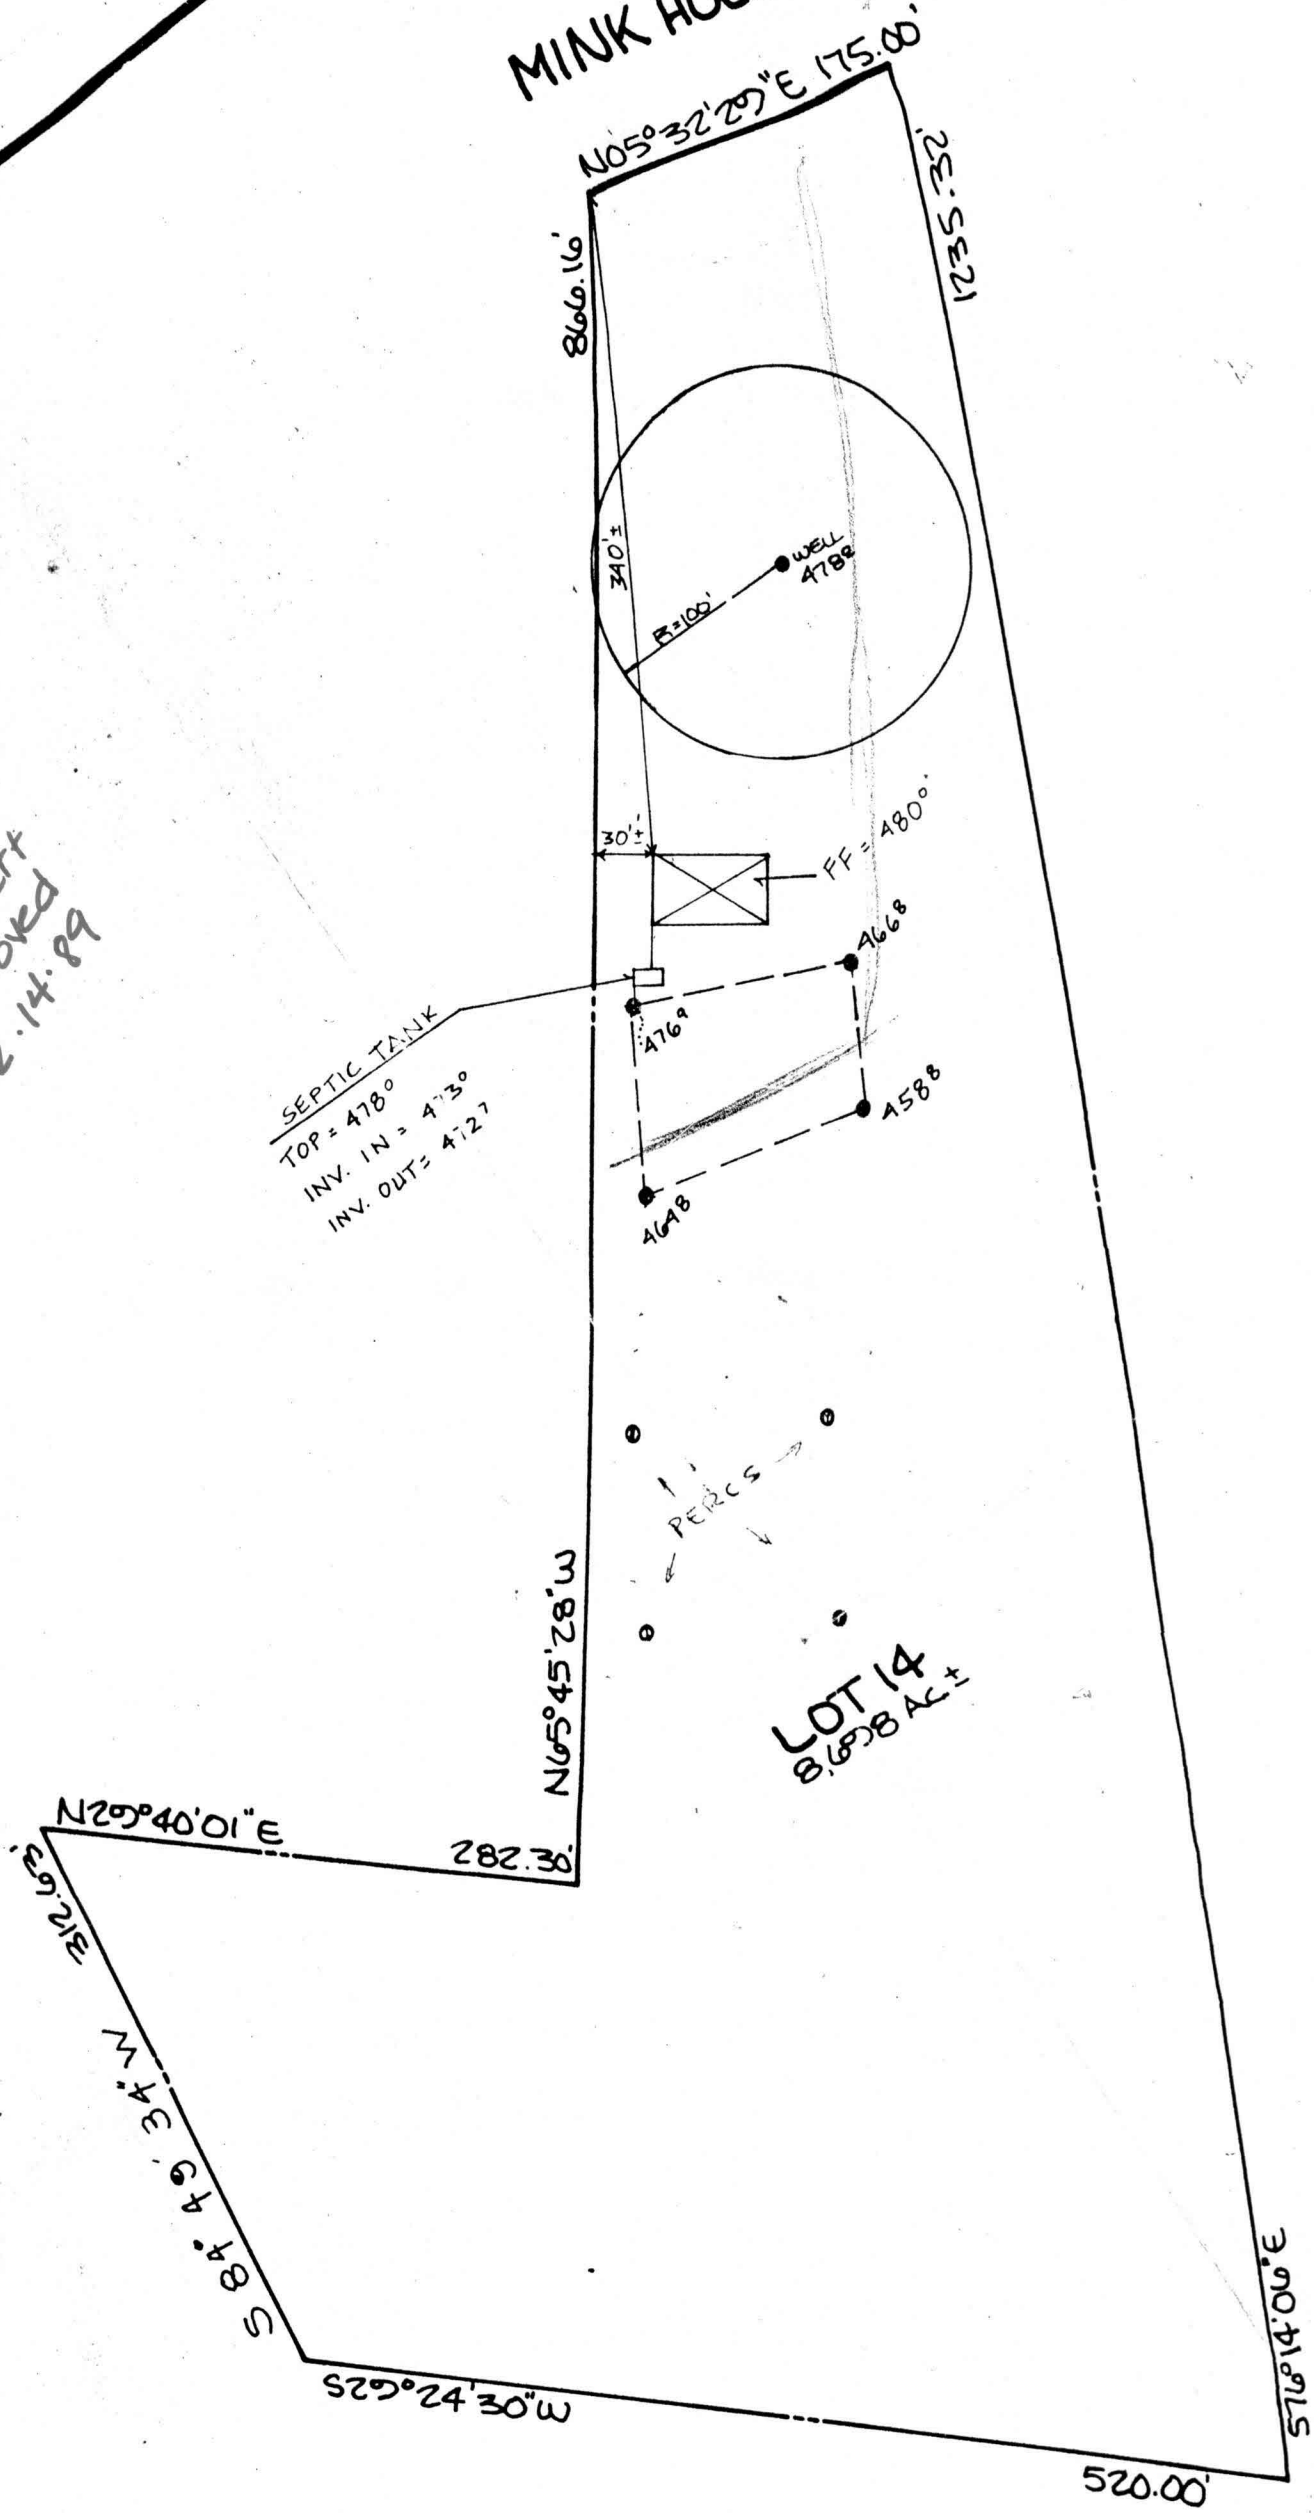

SEPTIC TANK  
TOP = 478.0  
INV. IN = 477.30  
INV. OUT = 472.7

LOT 14  
8.6528 AC. ±

NOTE:

LAND DEDICATED TO HOWARD COUNTY FOR THE PURPOSE OF PUBLIC ROAD WIDENING 0.1223 AC

FP-5	S 23° 30'	53.00'
FP-6	S 21° 51' 09" W	35.00'
FP-7	N 54° 08' 51" W	251.99'
FP-8	N 28° 29' 24" W	92.00'
FP-9	N 03° 53' 15" E	92.00'

PARCEL 316  
DANIEL L. & PATRICIA J. BERTZ  
3246/197

PARCEL 280  
MARGIELE B. ALLISON  
424/2572/127

MILK HOLLOW ROAD  
(MINOR COLLECTOR)

BUILDABLE #088 GEN. NOTE #17  
PRESERVATION  
PARCEL 'A'  
7.061 AC.

LOT 1  
1.369 AC.

80' x 40' INGRESS & EGRESS  
AND UTILITIES EASEMENT (PRIVATE),  
USE IN COMMON DRIVENWAY  
EASEMENT FOR LOT #1 &  
PRESERVATION PARCEL 'A'

PARCEL 226  
DENNIS L. & THELMA L. CLARK  
1342/294

F-00-23  
7/24/00

PARCEL 190  
JOHN F. & PATRICIA S.  
1867/547 & 2158/300

SUBJECT TO A WAIVER PETITION FOR FINAL APPROVAL FOR ORIGINAL MU MAP

