

5/12/81
9:30 A.M.
5/14/81 soon as possible
HOWARD COUNTY

5/14/81 FILE APPROVED
P 31375 C.80

PERMIT

SEWAGE DISPOSAL SYSTEM

MARYLAND STATE DEPARTMENT OF HEALTH*

HOWARD COUNTY

ELLICOTT CITY

DISTRICT 5th

DATE 5/13/81

INDELED

Jack Fyock

IS PERMITTED TO INSTALL ALTER X

ADDRESS 13775 Triadelphia Road, Glenelg, Md. 21733 PHONE 988-9270

SUBDIVISION _____ ROAD Mink Hollow Road LOT _____

PROPERTY OWNER Mr. Gramling

ADDRESS Mink Hollow Road, Highland, Md. Phone: 286-2797

SPECIFICATIONS

- SEPTIC TANK CAPACITY _____ GALLONS
- DRAIN FIELD _____ DEPTH _____ FEET, BOTTOM AREA _____ SQ. FT.
- DEEP TRENCH _____ DEPTH _____ FEET, BOTTOM AREA _____ SQ. FT.
- SEEPAGE PITS _____ ABSORBENT SIDE-WALL AREA _____ SQ. FT.
- INLET PIPE _____ FT. BELOW ORIGINAL GRADE. MAXIMUM DEPTH _____ FT. BELOW ORIGINAL GRADE
- EFFECTIVE DEPTH AT _____ FT. BELOW ORIGINAL GRADE.
- LOCATE DISPOSAL AREA _____ FT. FROM _____ LOT LINE AND _____ FT. FROM _____ LOT LINE AS SEEN WHEN FACING LOT FROM

REPAIR - Call for an appointment when ground is opened up and Sanitarian will recommend the repair system.

TRENCH - One trench 70 feet long, 6 feet wide, 5-5 1/2 feet deep, inlet at 3 feet, with at least 2 feet of stone under distribution pipe. Sewage ejector pump is to be installed. Old system to be abandoned. Locate system in area of test hole #2 which is 75 feet from house and 50 feet from the right side line, as seen when
Palmer F. Wine

PLANS APPROVED BY _____ DATE 5/8/81
facing the lot from the gravel lane.
COVER NO WORK UNTIL INSPECTED AND APPROVED.

NEITHER THE HOWARD COUNTY COUNCIL NOR THE HEALTH DEPARTMENT IS RESPONSIBLE FOR THE SUCCESSFUL OPERATION OF ANY SYSTEM.

NOTE: IF TRENCH IS USED CALL FOR INSPECTION BEFORE PLACING GRAVEL IN TRENCH.

NOTE: NO DRY WELL SHALL EXCEED 15 FOOT IN DIAMETER.


NOTE: ALL PIPE FROM HOUSE TO DISPOSAL AREA MUST BE CAST IRON.

PERMIT VOID AFTER THREE YEARS.

NOTE: INSTALL STAND PIPE ON SEPTIC TANK AND DRY WELL. STAND PIPES MUST BE 6 INCHES IN DIAMETER. CAST IRON, CONCRETE OR TERRA COTTA ACCEPTED.

*INSTALLER IS RESPONSIBLE FOR OBTAINING FINAL APPROVAL ON THIS PERMIT.

R.P. 31375

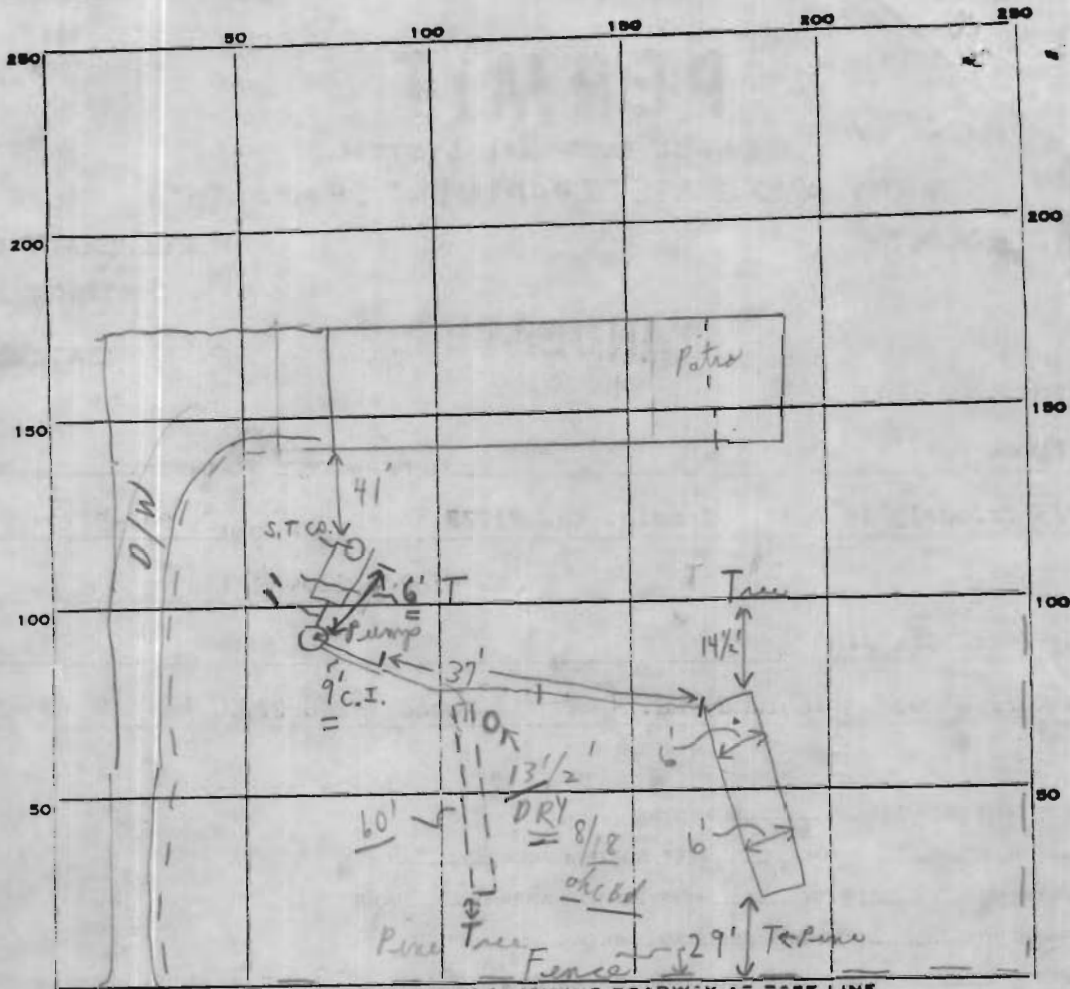

INDICATE NORTH. - NAME ADJOINING ROADWAY AS BASE LINE.

PERMIT CARD _____
 SEPTIC TANK, LEVEL _____ CLEANOUTS _____
 DISTRIBUTION BOX, LEVEL _____
 TILE FIELD, DEPTH 5' on spec FT. TRENCH WIDTH 6 FT.
 GRAVEL DEPTH 3'-2 1/2" IN. TOTAL LENGTH 80 FT.
 NUMBER OF TRENCHES 1 TOTAL BOTTOM AREA 480
 SEEPAGE PITS, INSIDE DIAMETER _____ FT. DEPTH BELOW INLET _____ FT.
 ABSORBENT AREA 480 SQ. FT.

REMARKS 5/14/81 CHECKED SYSTEM COMPLETE.
C.B.A.

{ New 8/18/89 60'+ Trench - 2' wide 3'-4' max depth 11'-12'
repair FOR 480' sq ft absorbent area - use old pump pipe
line to new trench. Call for inspection }

DATE SYSTEM APPROVED 5/14/81 INSPECTOR C.B.A. Stecker