

6/7/01  
Lynnet  
10:00

6/29/01 - follow up  
a.m.

6/28/01  
C.O. AM

7/18/01  
AM  
House Connection (2:00)

Master Homes = Builder (Contractor) American Plumbing & Heating = (Subcontractor)

# PERMIT

P 515278

## SEWAGE DISPOSAL SYSTEM HOWARD COUNTY HEALTH DEPARTMENT BUREAU OF ENVIRONMENTAL HEALTH

A 49889-B

410-313-2640

ISSUE DATE 6/6/2001

APPROVAL DATE 7/18/01

INDEXED

~~Each Tank Septic Service~~ IS PERMITTED TO INSTALL  ALTER

ADDRESS ~~P.O. Box 88, Greenlee, MD 21787~~ P.O. Box 644 Manchester, MD 21102 PHONE ~~410-988-9070~~ 410 374 0800

SUBDIVISION Harless Manor LOT NUMBER 31 ADDRESS 14025 Monticello Drive

PROPERTY OWNER Patrick Eronini Sr PROPERTY OWNER'S ADDRESS 8903 Joseph's Coat Ct

SEPTIC TANK CAPACITY 1250 GALLONS (20794)

PUMP CHAMBER CAPACITY N/A GALLONS

04-357957

NUMBER OF BEDROOMS 4

SQUARE FEET PER BEDROOM 210

LINEAR FEET OF TRENCH REQUIRED 280

TRENCHES: Trenches to be 3 feet wide. Inlet .2.5 feet below original grade. Bottom maximum depth

4 feet below original grade. 1.5 feet of stone below distribution box pipe.

LOCATION: Place the distribution box 195 feet from front lot line (144.00') and 50 feet from right lot line (411.05') as viewed from Monticello Drive. Install trenches on contour in both directions from distribution box. 3/5/01 OK (BB)

PLANS APPROVED Donna K. Clark, R.S. DATE 3/1/2001

PERMIT VOID AFTER 2 YEARS

NOTE: CONTRACTOR RESPONSIBLE FOR SCHEDULING A PRE-CONSTRUCTION INSPECTION FOR ALL INSTALLATIONS

NOTE: TOP OF SEPTIC TANKS ARE TO BE NO DEEPER THAN 3.0 FEET BELOW FINISH GRADE

NOTE: WATERTIGHT SEPTIC TANKS REQUIRED

NOTE: CLEANOUT REQUIRED EVERY 70 FEET OF SEWER LINE AND/OR AT 90° SWEEPS IN LINES FROM HOUSE TO DRAIN FIELDS, 90° ELBOWS ARE NOT ACCEPTABLE

NOTE: ALL PARTS OF SEPTIC SYSTEMS (I.E. TANK, DISTRIBUTION BOX, DRAINFIELDS) TO BE 100 FEET FROM ANY WATER WELL UNLESS OTHERWISE SPECIFICALLY AUTHORIZED

NOTE: NO ABSORPTION TRENCH TO EXCEED 100 FEET IN LENGTH UNLESS SPECIFICALLY AUTHORIZED

NOTE: ALL PIPE FROM HOUSE TO SEPTIC TANK MUST BE CAST IRON OR SCHEDULE 35/40 PVC OR ABS

NOTE: MANHOLE RISERS REQUIRED ON ALL SEPTIC TANKS AND PUMP CHAMBERS

NOTE: DISTRIBUTION BOXES MUST HAVE BAFFLES


NOTE: IF PUMPED SEPTIC SYSTEM REQUIRED, (1) SEPTIC PUMP DETAIL TO BE PROVIDED BY INSTALLER PRIOR TO ISSUANCE OF SEPTIC PERMIT (2) PUMP PERFORMANCE TEST IS NECESSARY PRIOR TO HEALTH DEPARTMENT APPROVAL OF SEPTIC PERMIT

NEITHER THE HOWARD COUNTY COUNCIL NOR THE HEALTH DEPARTMENT IS RESPONSIBLE FOR THE SUCCESSFUL OPERATION OF ANY SYSTEM

PERMITTEE RESPONSIBLE FOR OBTAINING FINAL APPROVAL ON THIS PERMIT  
CALL 410-313-2640 FOR INSPECTION OF SEPTIC SYSTEM

P515278

NOT TO SCALE

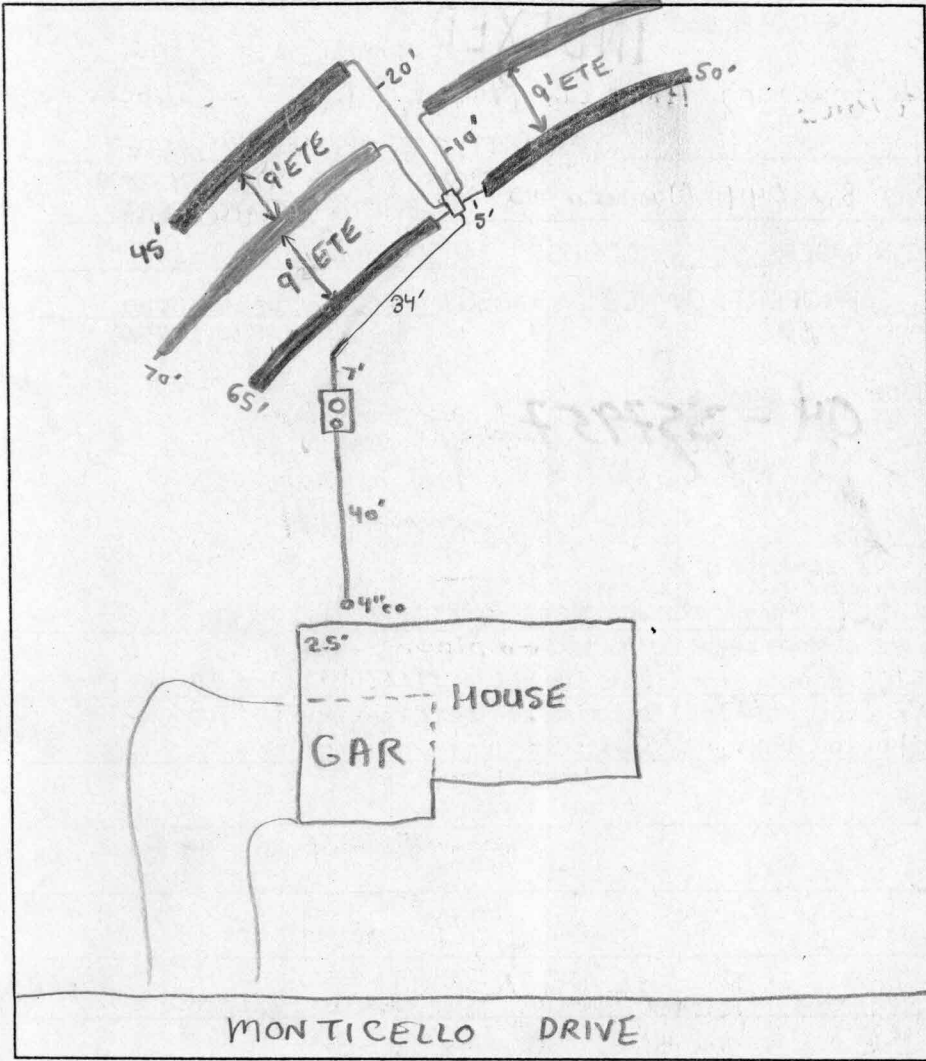

**TRENCH DATA**

TRENCH WIDTH 3'  
 TRENCH INLET DEPTH 2.5'  
 TRENCH BOTTOM DEPTH 4'  
 DEPTH OF STONE 1.5'  
 NUMBER OF TRENCHES 5  
 TOTAL TRENCH LENGTH 280'  
 ABSORBENT AREA 840 ft<sup>2</sup>  
 DISTRIBUTION BOX LEVEL   
 BAFFLE IN DISTRIBUTION BOX

**SEPTIC TANK DATA**

SEPTIC TANK 1250 T.S. GALLONS  
 MANHOLE RISER on center  
 6 INCH INSPECTION PORT on front

**PUMP CHAMBER DATA**

PUMP CHAMBER GALLONS NA  
 MANHOLE RISER NA  
 ALARM NA  
 PUMP PERFORMANCE TEST NA

PRE-CONSTRUCTION INSPECTION: NO LAYOUT EVER CALLED IN, INSTALLER AWARE OF HO. CO. GUIDELINES, DISCUSSED W/ INSTALLER PROPER INSP. PROCEDURES. (SRW)

INSPECTION COMMENTS: 6/28/01 - INSTALL SYSTEM AS DISCUSSED IN FIELD (SRW)

6/29/01 - OK TO COVER ALL WORK, SYSTEM NEEDS HOUSE CONNECTION (SRW)

7/18/01 House connection made. (BB)

INSPECTOR B. Baker DATE SYSTEM APPROVED 7/18/01