

5/7/01
3:00 - layout
5/10/01 - 2:00
6/12/01
10:00

PERMIT

SEWAGE DISPOSAL SYSTEM
HOWARD COUNTY HEALTH DEPARTMENT
BUREAU OF ENVIRONMENTAL HEALTH
410-313-2640

P 515030-C

A 49888-V

ISSUE DATE 4/6/2001

APPROVAL DATE 6/12/01

INDEXED
04-357469

Jack Fyock Septic Service

IS PERMITTED TO INSTALL ALTER

ADDRESS P. O. Box 89, Glenelg, MD 21737 PHONE (410) 9889270

SUBDIVISION Harless Manor LOT NUMBER 13 ADDRESS 14033 Monticello Drive

PROPERTY OWNER Cornerstone Homes, Inc PROPERTY OWNER'S ADDRESS 9691 Norfolk Ave (20723)

SEPTIC TANK CAPACITY 1250 GALLONS **** WATERTIGHT SEPTIC TANK REQUIRED ****

PUMP CHAMBER CAPACITY 1250 GALLONS ***** WATERTIGHT PUMP CHAMBER REQUIRED *****

NUMBER OF BEDROOMS 4

SQUARE FEET PER BEDROOM 180

LINEAR FEET OF TRENCH REQUIRED 240

TRENCHES: Trenches to be 3 feet wide. Inlet 2 feet below original grade. Bottom maximum depth

4 feet below original grade. 2 feet of stone below distribution box. pipe

LOCATION: Place distribution box 10 feet from right (380.11') lot line and 255 feet from

front lot line as viewed from Monticello Drive. Run (3) 80' trenches on contour toward

left lot line. IT IS

WELL LINE TO BE SLEEVED WHERE LESS THAN 10' TO

ALL PARTS OF SEPTIC SYSTEM - (FORCE MAIN, EASEMENT,

TANKS, etc.) - (SEE HIGHLIGHTED ON PLAN)

PLANS APPROVED Mark Rifkin, R.S. OK SRU 2/27/01 DATE 2/21/2001

PERMIT VOID AFTER 2 YEARS

NOTE: CONTRACTOR RESPONSIBLE FOR SCHEDULING A PRE-CONSTRUCTION INSPECTION FOR ALL INSTALLATIONS

NOTE: TOP OF SEPTIC TANKS ARE TO BE NO DEEPER THAN 3.0 FEET BELOW FINISH GRADE

NOTE: WATERTIGHT SEPTIC TANKS REQUIRED

NOTE: CLEANOUT REQUIRED EVERY 70 FEET OF SEWER LINE AND/OR AT 90° SWEEPS IN LINES FROM HOUSE TO DRAIN FIELDS, 90° ELBOWS ARE NOT ACCEPTABLE

NOTE: ALL PARTS OF SEPTIC SYSTEMS (I.E. TANK, DISTRIBUTION BOX, DRAINFIELDS) TO BE 100 FEET FROM ANY WATER WELL UNLESS OTHERWISE SPECIFICALLY AUTHORIZED

NOTE: NO ABSORPTION TRENCH TO EXCEED 100 FEET IN LENGTH UNLESS SPECIFICALLY AUTHORIZED

NOTE: ALL PIPE FROM HOUSE TO SEPTIC TANK MUST BE CAST IRON OR SCHEDULE 35/40 PVC OR ABS

NOTE: MANHOLE RISERS REQUIRED ON ALL SEPTIC TANKS AND PUMP CHAMBERS

NOTE: DISTRIBUTION BOXES MUST HAVE BAFFLES

NOTE: IF PUMPED SEPTIC SYSTEM REQUIRED, (1) SEPTIC PUMP DETAIL TO BE PROVIDED BY INSTALLER PRIOR TO ISSUANCE OF SEPTIC PERMIT (2) PUMP PERFORMANCE TEST IS NECESSARY PRIOR TO HEALTH DEPARTMENT APPROVAL OF SEPTIC PERMIT

NEITHER THE HOWARD COUNTY COUNCIL NOR THE HEALTH DEPARTMENT IS RESPONSIBLE FOR THE SUCCESSFUL OPERATION OF ANY SYSTEM


PERMITTEE RESPONSIBLE FOR OBTAINING FINAL APPROVAL ON THIS PERMIT

CALL 410-313-2640 FOR INSPECTION OF SEPTIC SYSTEM

515 030-C

Well
Ho-94-0618

NOT TO SCALE

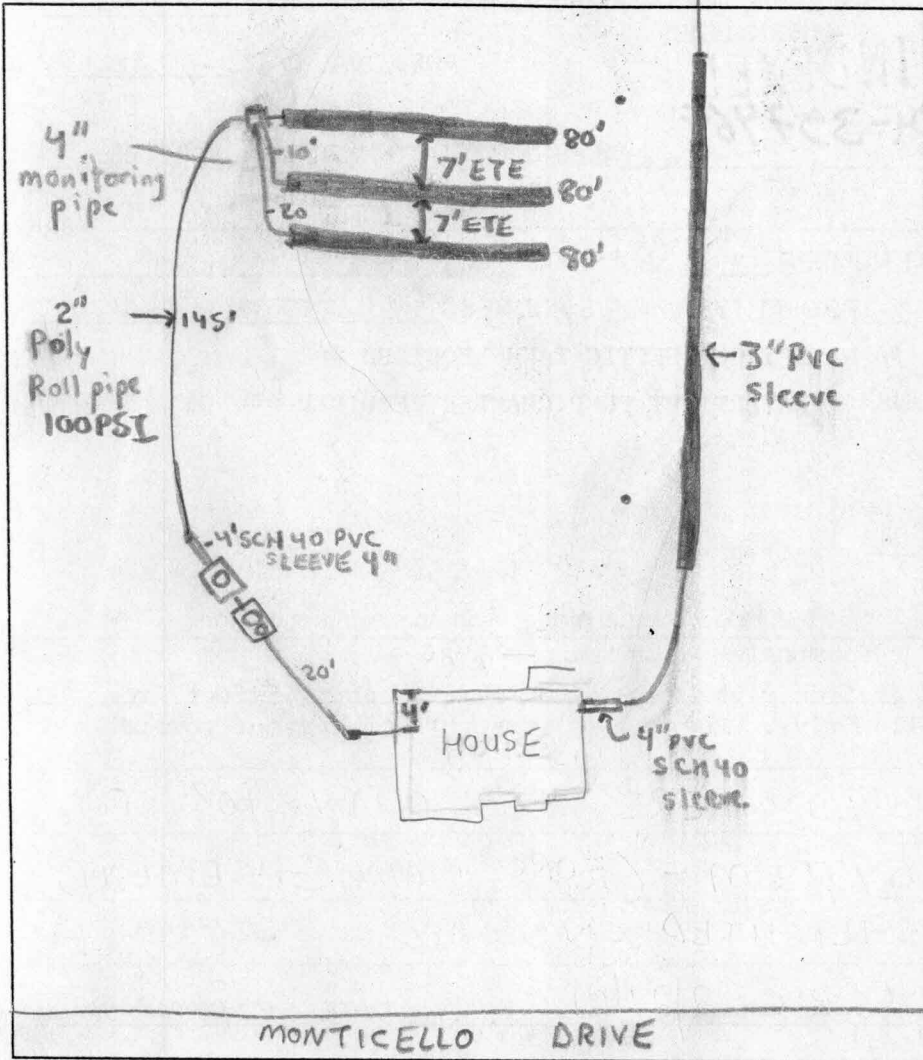

TRENCH DATA

TRENCH WIDTH 3'
 TRENCH INLET DEPTH 2'
 TRENCH BOTTOM DEPTH 4'
 DEPTH OF STONE 2'
 NUMBER OF TRENCHES 3
 TOTAL TRENCH LENGTH 240'
 ABSORBENT AREA 720ft²
 DISTRIBUTION BOX LEVEL ✓
 BAFFLE IN DISTRIBUTION BOX NA
 Elbow Fitting

SEPTIC TANK DATA

SEPTIC TANK 1250 TS GALLONS
 MANHOLE RISER on center
 6 INCH INSPECTION PORT on front

PUMP CHAMBER DATA

PUMP CHAMBER GALLONS 1250 TS
 MANHOLE RISER on center
 ALARM _____
 PUMP PERFORMANCE TEST _____

PRE-CONSTRUCTION INSPECTION: 5/7/01 - PLUMBING SET TO OTHER SIDE OF HOUSE, OK TO PUT D-BOX IN UPPER LEFT CORNER OF SDA AND RUN 3-80' TRENCHES - (OK SRW)

INSPECTION COMMENTS: 5/10/01 - OK TO COVER ALL WORK, STILL NEED HOUSE CONN. & PUMP TEST - (SRW) 6/12/01 Pump and alarm working. Robert said house connection was made. (BB)

INSPECTOR B. Baker

DATE SYSTEM APPROVED 6/12/01