

5/15/01
11:00

PERMIT
SEWAGE DISPOSAL SYSTEM
HOWARD COUNTY HEALTH DEPARTMENT
BUREAU OF ENVIRONMENTAL HEALTH
410-313-2640

P 515242-G

A 49888-P

ISSUE DATE 5/11/2001

APPROVAL DATE 5/15/01

01-357426

INDEXED

Fogles Septic Clean, Inc IS PERMITTED TO INSTALL ALTER

ADDRESS 580 Obrecht Road, Sykesville, MD 21784 PHONE 410-795-5670

SUBDIVISION Harless Manor LOT NUMBER 9 ADDRESS 14049 Monticello Drive

PROPERTY OWNER Matt & Kathy Berdini PROPERTY OWNER'S ADDRESS Same

SEPTIC TANK CAPACITY 1250 GALLONS (TOPSEAM)

PUMP CHAMBER CAPACITY NA GALLONS

NUMBER OF BEDROOMS 4

SQUARE FEET PER BEDROOM 210

LINEAR FEET OF TRENCH REQUIRED 280

TRENCHES: Trenches to be 2 feet wide. Inlet 3 feet below original grade. Bottom maximum depth 6 feet below original grade. 3 feet of stone below distribution box pipe

LOCATION: Place distribution box 10 feet from left (356.25') lot line at the highest portion of the septic easement as viewed from Monticello Drive. Install trenches on contour in both directions or as best determined during layout inspection.

Well line must be sleeved where less than 10' to septic easement is encountered

PLANS APPROVED Amy McMillen OK SRN 2/14/01 DATE 2/8/2001

PERMIT VOID AFTER 2 YEARS

NOTE: CONTRACTOR RESPONSIBLE FOR SCHEDULING A PRE-CONSTRUCTION INSPECTION FOR ALL INSTALLATIONS

NOTE: TOP OF SEPTIC TANKS ARE TO BE NO DEEPER THAN 3.0 FEET BELOW FINISH GRADE

NOTE: WATERTIGHT SEPTIC TANKS REQUIRED

NOTE: CLEANOUT REQUIRED EVERY 70 FEET OF SEWER LINE AND/OR AT 90° SWEEPS IN LINES FROM HOUSE TO DRAIN FIELDS, 90° ELBOWS ARE NOT ACCEPTABLE

NOTE: ALL PARTS OF SEPTIC SYSTEMS (I.E. TANK, DISTRIBUTION BOX, DRAINFIELDS) TO BE 100 FEET **BUILDING PERMIT SIGNED** OTHERWISE SPECIFICALLY AUTHORIZED

NOTE: NO ABSORPTION TRENCH TO EXCEED 100 FEET IN LENGTH UNLESS SPECIFICALLY AUTHORIZED **AND RETURNED** 12/12/2002 B00139682 SUNROOM

NOTE: ALL PIPE FROM HOUSE TO SEPTIC TANK MUST BE CAST IRON OR SCHEDULE 35/40 PVC OR ABS

NOTE: MANHOLE RISERS REQUIRED ON ALL SEPTIC TANKS AND PUMP CHAMBERS

NOTE: DISTRIBUTION BOXES MUST HAVE BAFFLES


NOTE: IF PUMPED SEPTIC SYSTEM REQUIRED, (1) SEPTIC PUMP DETAIL TO BE PROVIDED BY INSTALLER PRIOR TO ISSUANCE OF SEPTIC PERMIT (2) PUMP PERFORMANCE TEST IS NECESSARY PRIOR TO HEALTH DEPARTMENT APPROVAL OF SEPTIC PERMIT

NEITHER THE HOWARD COUNTY COUNCIL NOR THE HEALTH DEPARTMENT IS RESPONSIBLE FOR THE SUCCESSFUL OPERATION OF ANY SYSTEM
PERMITTEE RESPONSIBLE FOR OBTAINING FINAL APPROVAL ON THIS PERMIT
CALL 410-313-2640 FOR INSPECTION OF SEPTIC SYSTEM

P515242-G

NOT TO SCALE

HO-94-0616

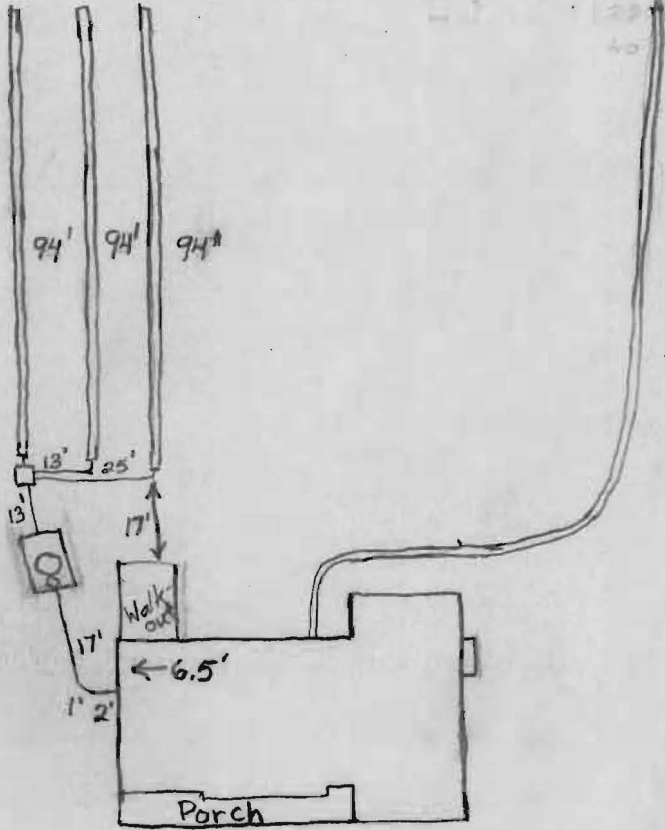

TRENCH DATA

TRENCH WIDTH 2'
 TRENCH INLET DEPTH 3'
 TRENCH BOTTOM DEPTH 6'
 DEPTH OF STONE 3'
 NUMBER OF TRENCHES 3
 TOTAL TRENCH LENGTH 282'
 ABSORBENT AREA 846 sq. ft.
 DISTRIBUTION BOX LEVEL OK
 BAFFLE IN DISTRIBUTION BOX Yes

SEPTIC TANK DATA

SEPTIC TANK 1250 TS GALLONS
 MANHOLE RISER Yes
 6 INCH INSPECTION PORT Yes

PUMP CHAMBER DATA N/A

~~PUMP CHAMBER GALLONS _____
 MANHOLE RISER _____
 ALARM _____
 PUMP PERFORMANCE TEST _____~~

Monticello Drive

PRE-CONSTRUCTION INSPECTION: 5/15/01 Will install distribution box at left front corner of easement. Can't make gravity to middle, 3-95' trenches (BB)

INSPECTION COMMENTS: 5/15/01 System satisfactory. O.K. to cover. (BB)

BUILDING PERMIT SIGNED AND RETURNED

INSPECTOR B. Baker DATE SYSTEM APPROVED 5/15/01