

COUNTY #

SOIL PROFILE

(327)

0' Topsoil 3-4"

DK brn
CL Lm

2 1/2' Micaceous S
Sa Lm
brn
tan
beige

Frag
25-35%
Bottom

(328)

T.S.
org brn
CL
Lm

off white
tan
brn
beige
micaceous
S: Lm
5-10% Frag
Bottom


(329)

T.S.
Brn
DK Brn
CL Lm

beige
tan
white

Sa
Loam
Frag < 5%

Bottom

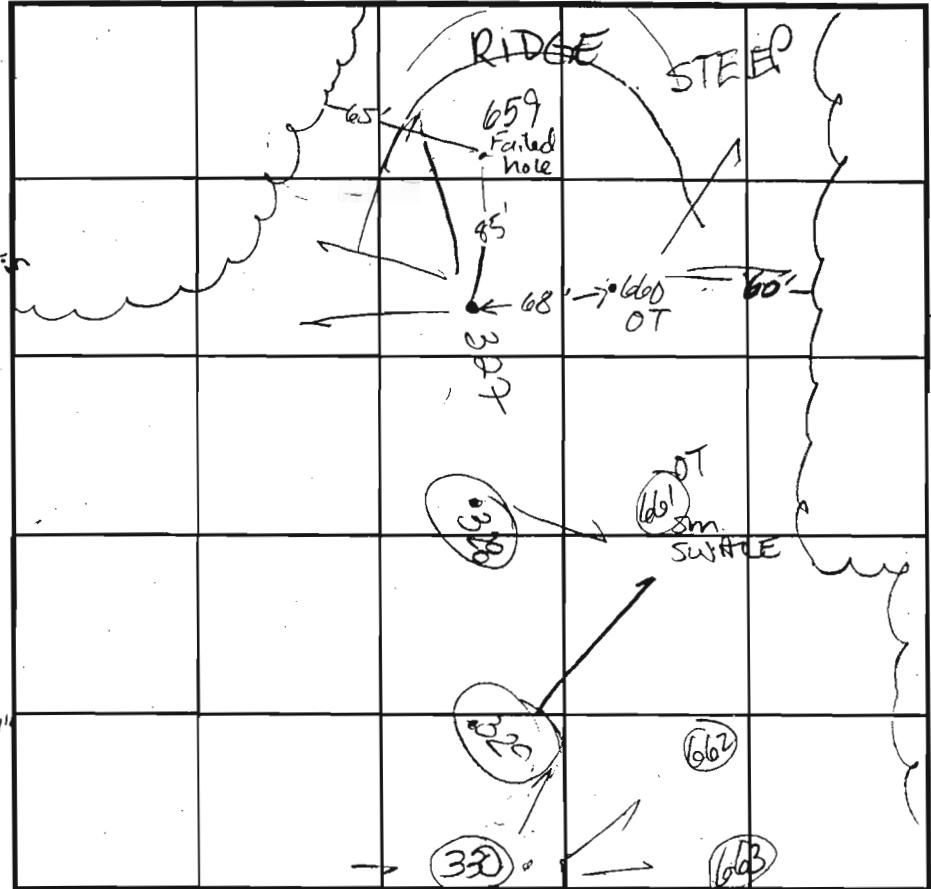

SOIL PROFILE

(330)

0' T.S.
DK brn
tan

3-4" CL Lm

H beige
H brn

Sa Lm

10-15% Frag
Bottom

INDICATE NORTH - NAME ADJOINING ROADWAY AS BASE LINE.

DATE	TEST NO.	DEPTH	PRE-WET		TEST - 1" DROP		TIME
			START	STOP	START	STOP	
8-31-01	p 327	5'2" S	1:29 ³⁰	1:31 ³⁰	1:31 ³⁰	1:32	~ 1 min
		11" D	1:32 ⁰⁰	1:34	1:34	1:36	2 min PASS
	p 328	5'5" S	12:56	12:57 ³⁰	12:57 ³⁰	12:59 ³⁰	2 min
		14" D	1:01 ²⁰	1:02 ³⁰	1:02 ³⁰	1:04 ³⁰	2 min PASS
	p 329	5'8" S	12:55	1:05	1:05	1:22	7 min
		132" D					PASS
	p 330	5'4" S	1:19	1:21	1:21	1:23	2 min
		14" D					PASS

REMARKS: HOLES PER PLAN

TYPE OF SOIL _____

TESTED BY: Goedeking ALSO PRESENT: Chuck C
Mike & crew


TRENCH DESIGN DATA: AVERAGE PERCOLATION TIME _____ TRENCH WIDTH _____

13'2" INLET DEPTH _____ MAXIMUM BOTTOM DEPTH _____ SQ. FT./BEDROOM _____


COUNTY #

SOIL PROFILE

0' 663
 top soil
 4-4.5' org bn cl lm
 med org bn sa mica
 14' 5-10% rock

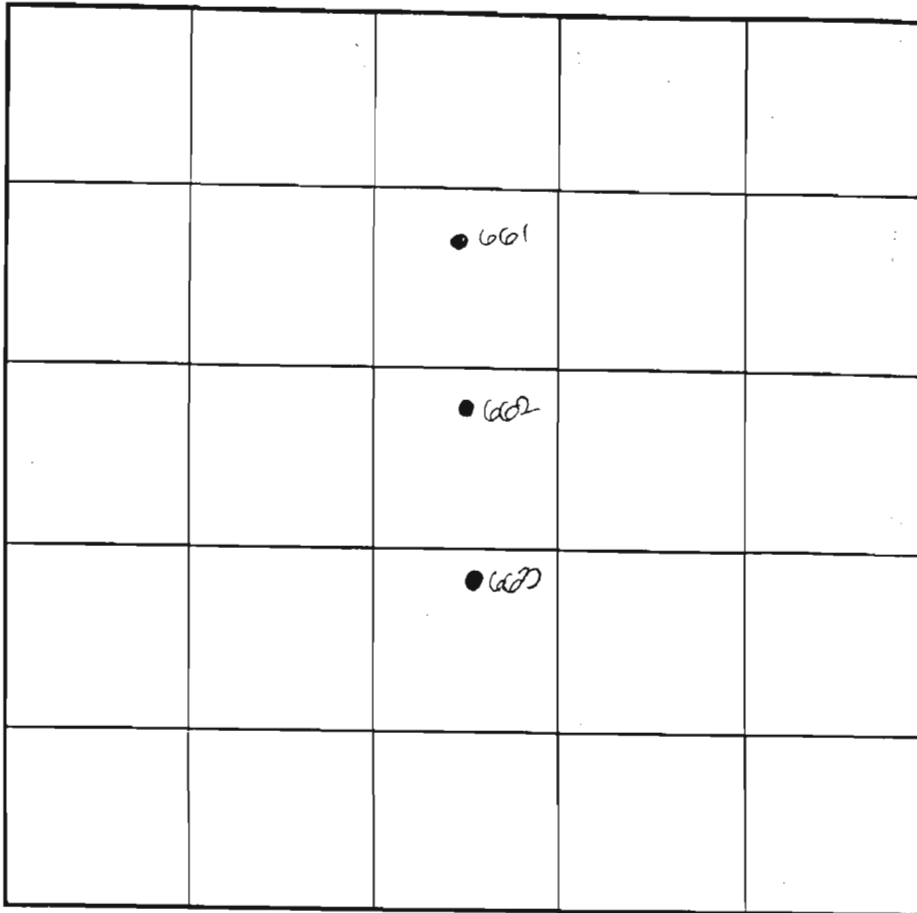

SOIL PROFILE

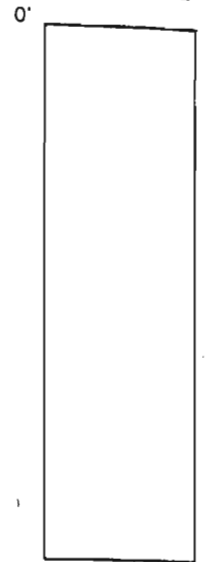


0' 662/661
 top soil
 4-4.5' org bn cl lm
 14' 14' org bn sa mica
 5-10% rock

INDICATE NORTH - NAME ADJOINING ROADWAY AS BASE LINE.

DATE	TEST NO.	DEPTH	PRE-WET		TEST - 1' DROP		TIME
			START	STOP	START	STOP	
5-29-01	<u>663</u>	5.5'S	11:49	11:50 ₃	11:50 ₃	11:52	2
		14.0'D	Visual	- See	profile		OK
	<u>662</u>	5.5'S	12:00 ₃	12:01 ₃	12:01 ₃	12:03	2
		14.0'D	Visual	- see	profile		OK
	661	6.0'S	12:09	12:10 ₃	12:10 ₃	12:12	2
		14.0'D	Visual	- see	profile		OK

REMARKS holes tested as staked

TYPE OF SOIL _____ DUE TO DROUGHT CONDITIONS,
 TESTED BY DKC APPROVABLE HOLES MUST HAVE 8
 TRENCH DESIGN DATA: FEET FROM OBSERVED
 GROUNDWATER TO BOTTOM OF
 INLET DEPTH _____ PROPOSED SEPTIC SYSTEM
 SO PRESENT M. Johnson & cr
 TRENCH WIDTH _____
 O. FT/BEDROOM _____

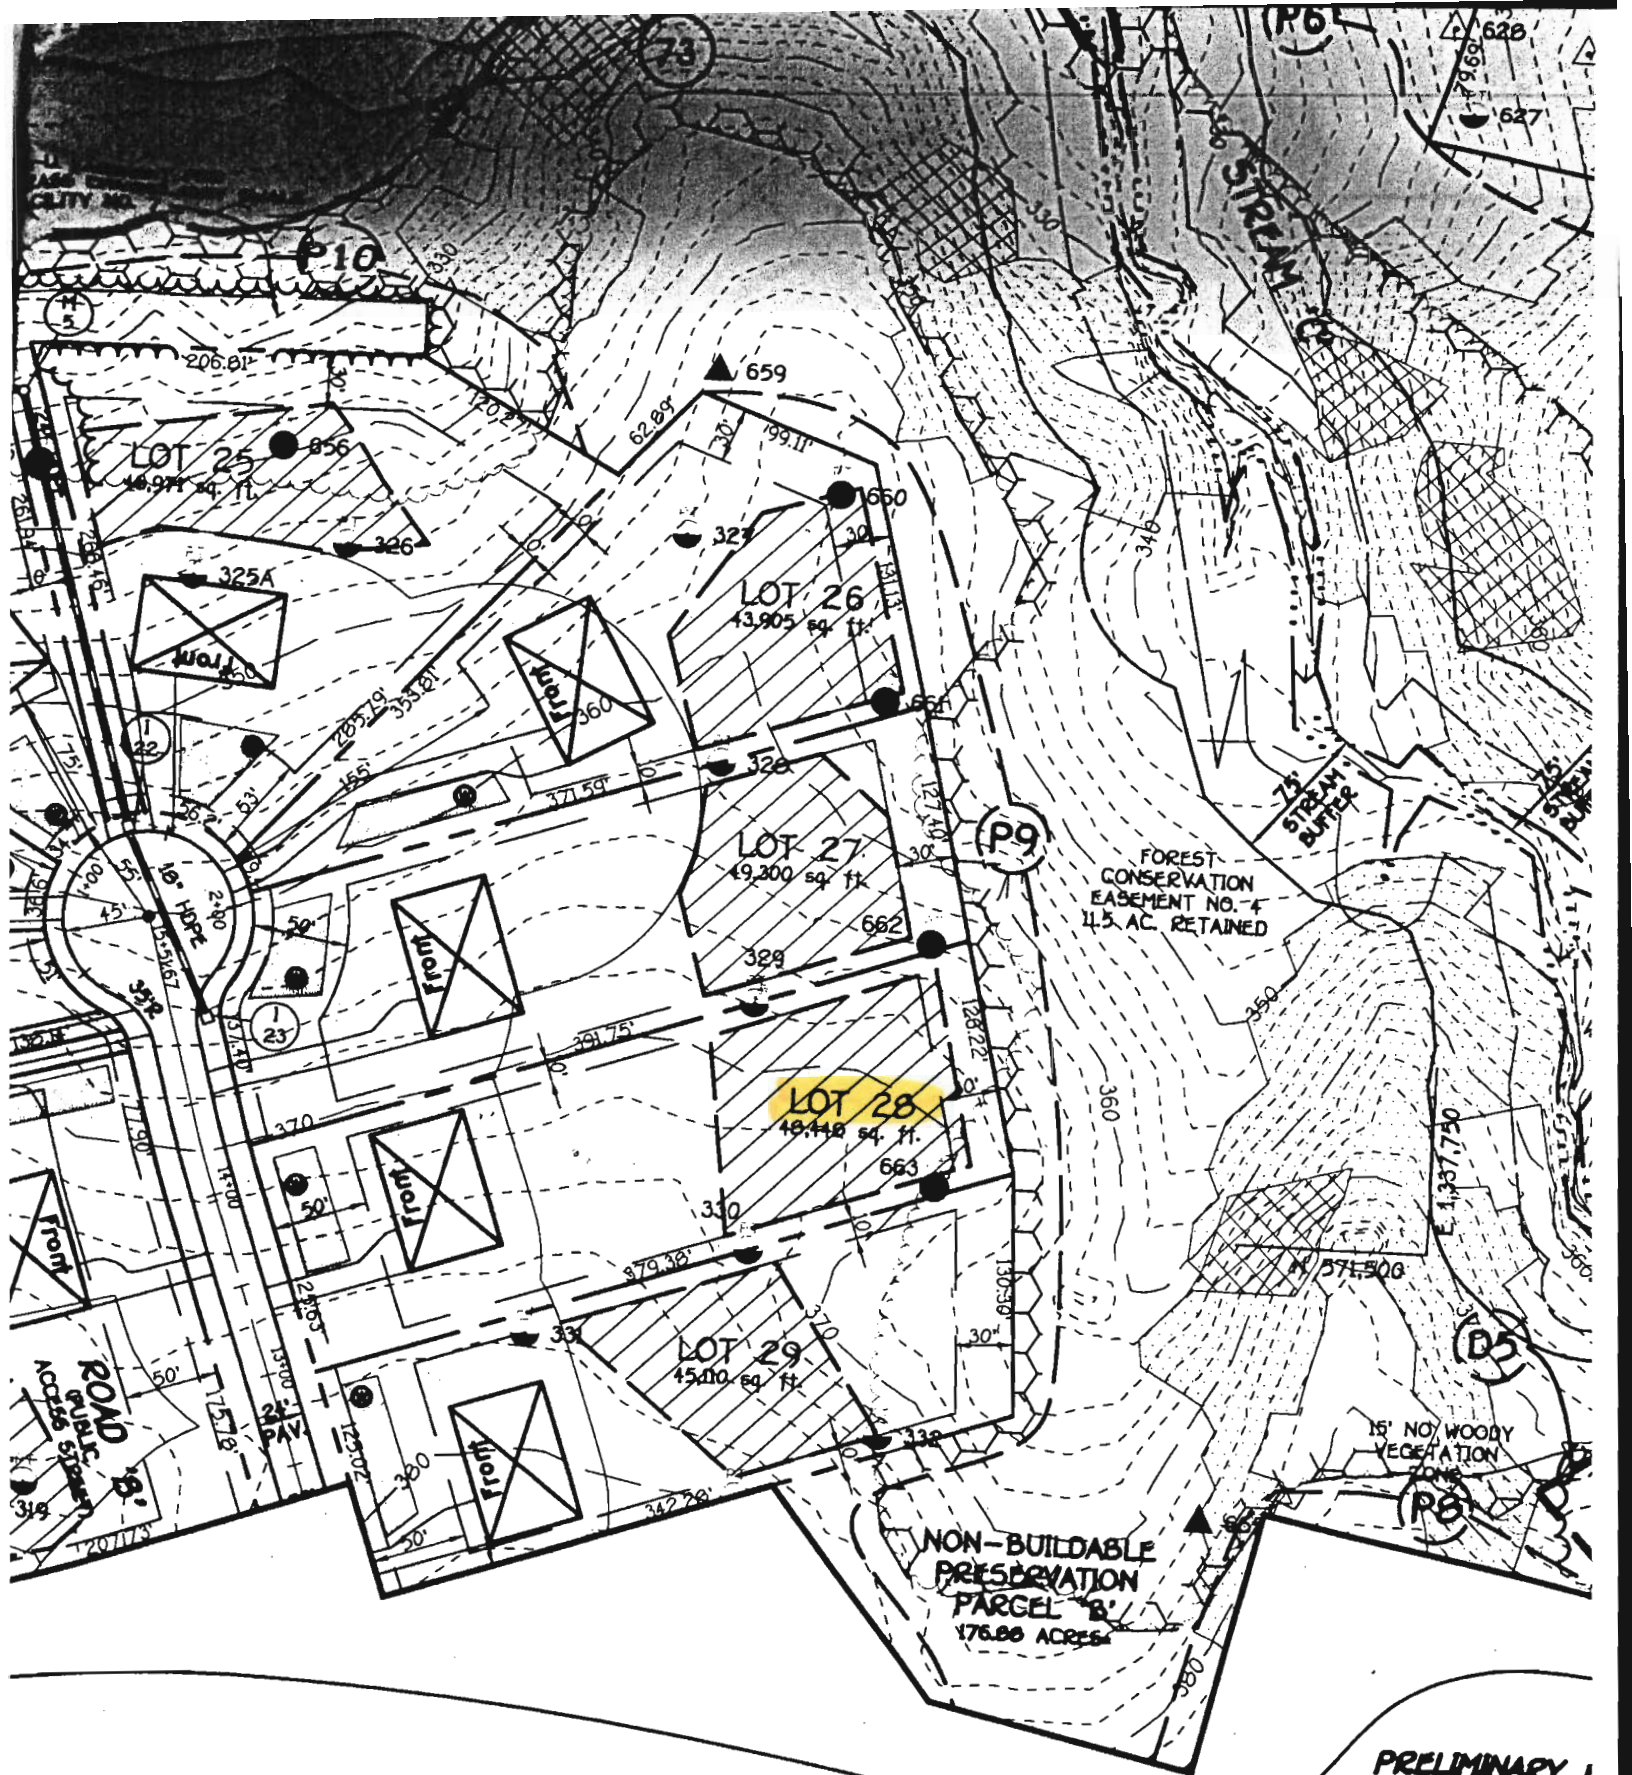

Signal 1/3/03
 SP-02-13

DEVELOPER



PRELIMINARY
 BE
 BUILDABLE LOTS 1
 NON-BUILDABLE P
 NON-BUILD

TAX MAP NO. 29